


—“DREDGE FIELDING.”—

—PROPOSED CONVERSION TO OIL CARRIER.—

—GENERAL ARRANGEMENT.—

—SCALE  $\frac{1}{8}" = \text{ONE FOOT.}$ —

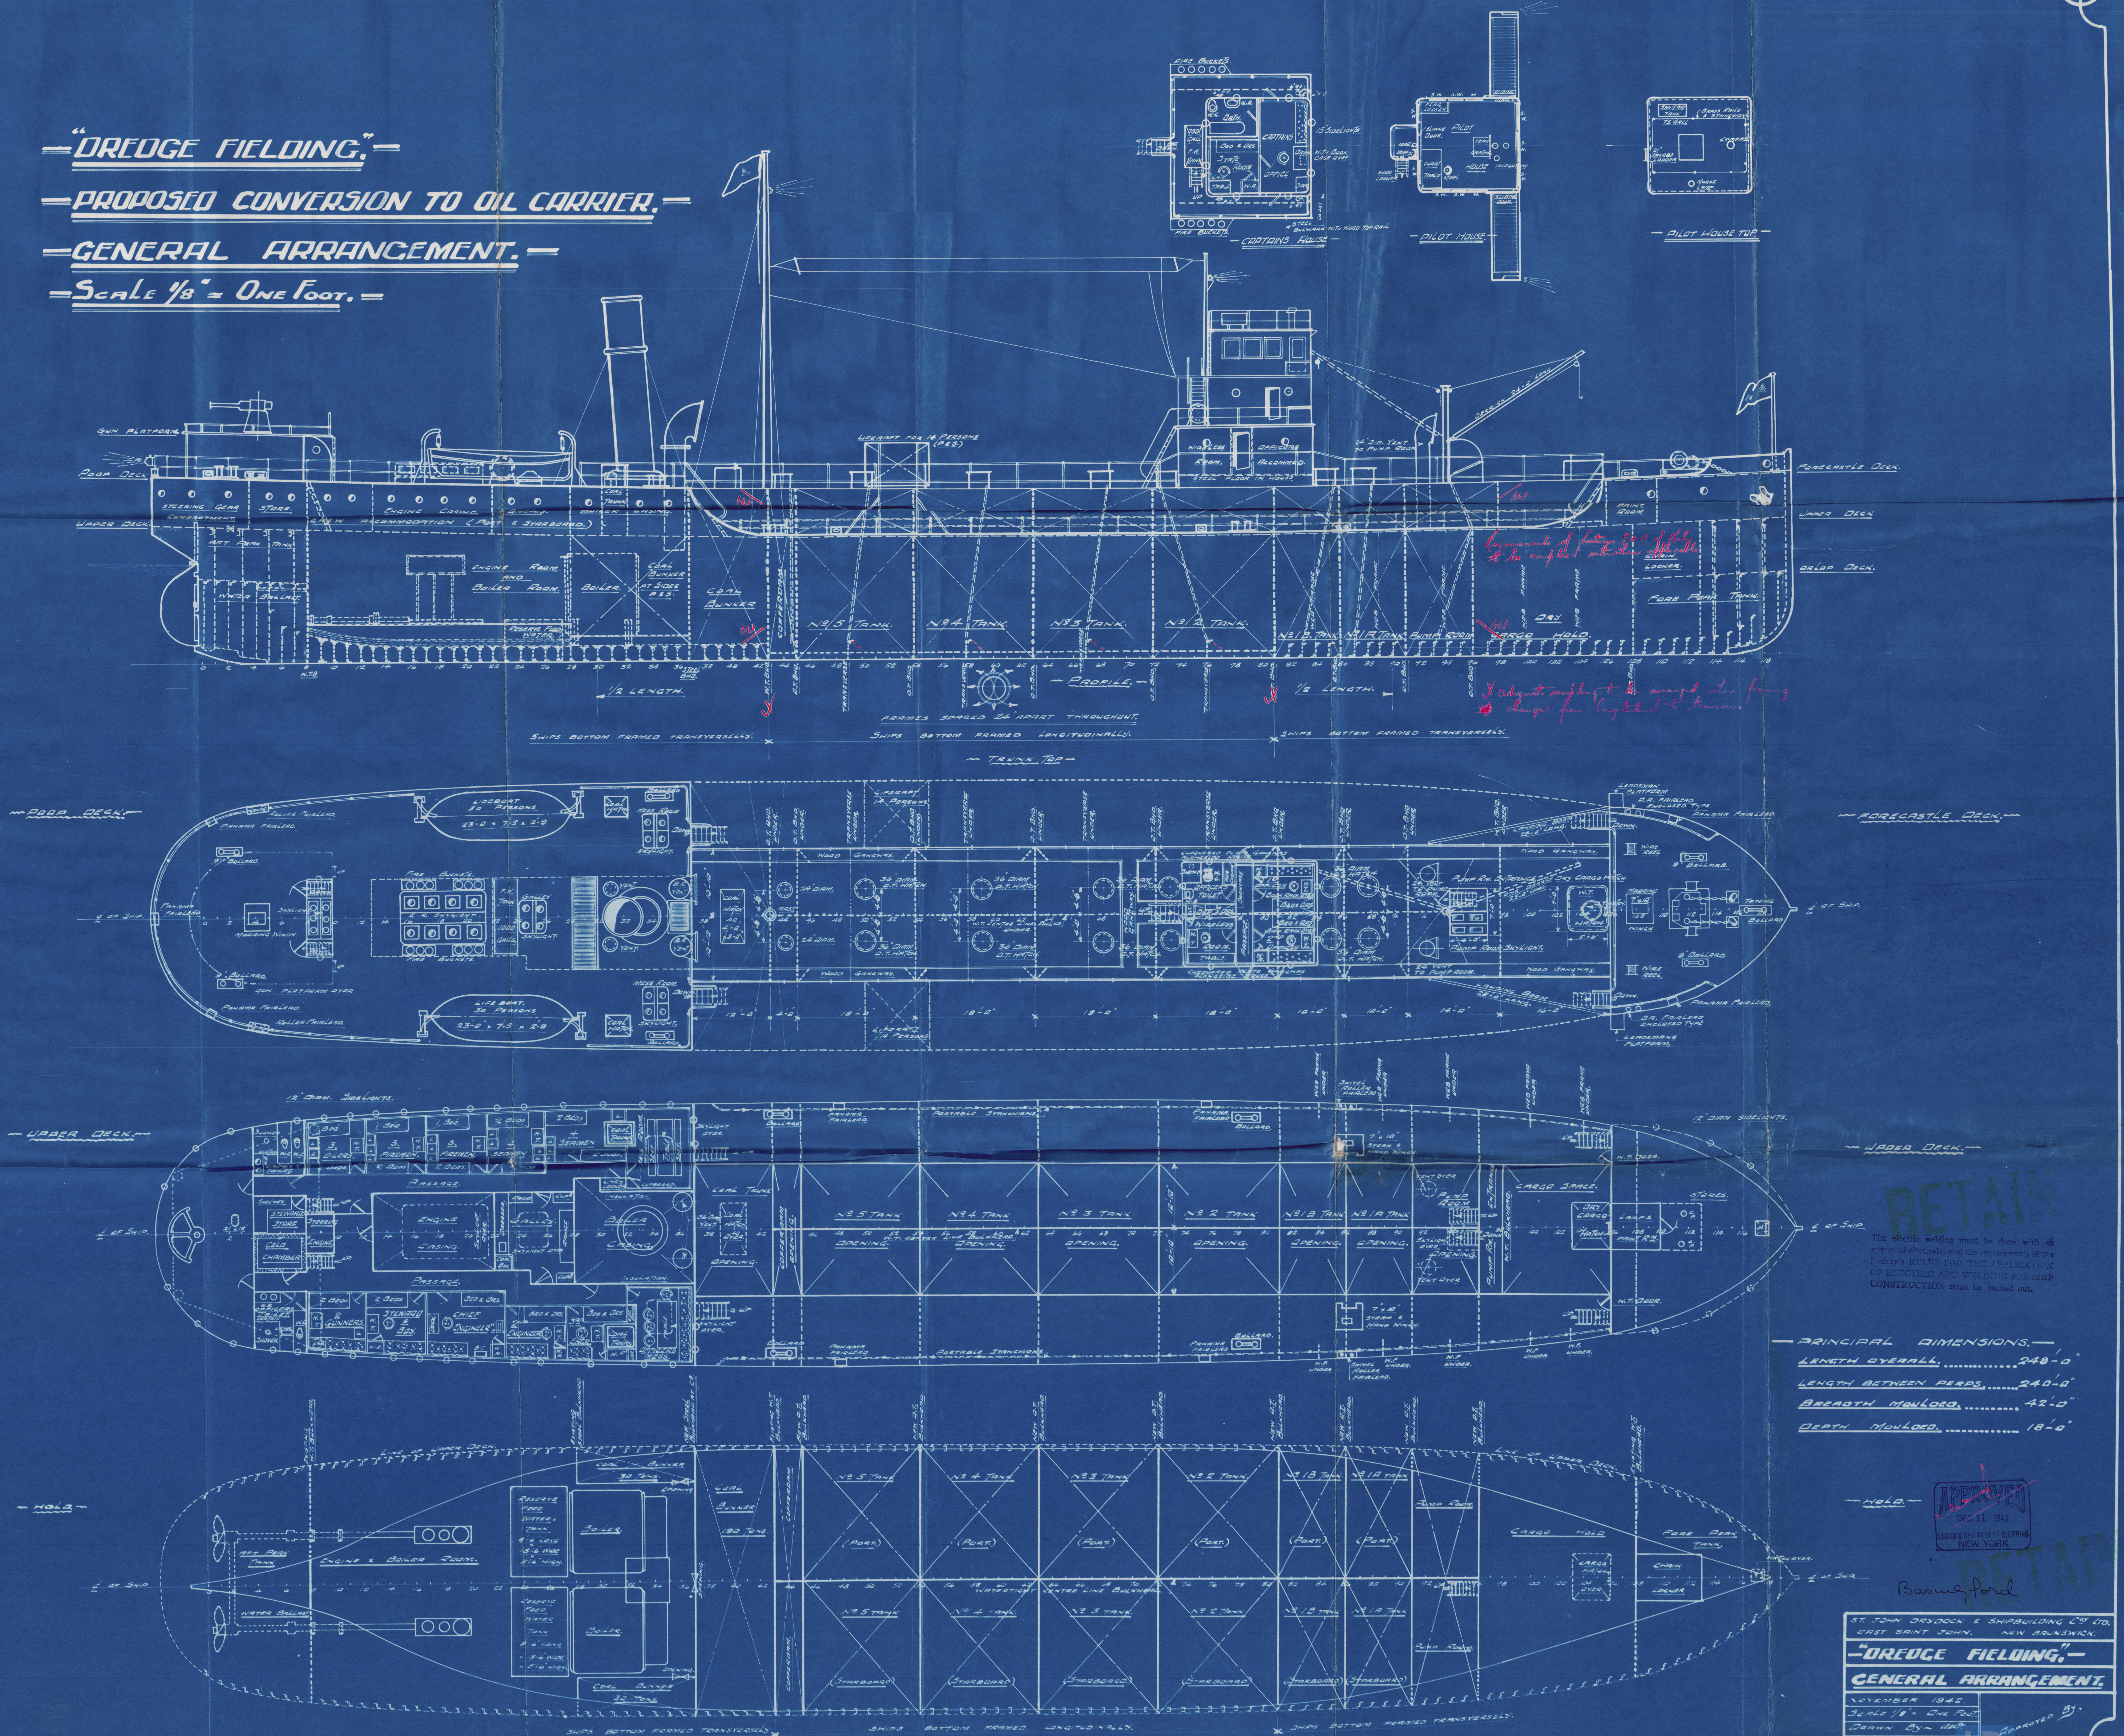

RETAIN

The electric welding must be done with an approved electric welding machine and the construction of the ship must be carried out.

—PRINCIPAL DIMENSIONS.—  
LENGTH OVERALL.....240'-0"  
LENGTH BETWEEN PERPS.....240'-0"  
BREADTH OVERALL.....42'-0"  
DEPTH OVERALL.....18'-0"

APPROVED  
DEC 11 1942  
LLOYD'S REGISTER OF SHIPPING  
NEW YORK

Barnesford  
ST. JOHN DRYDOCK & SHIPBUILDING CO. LTD.  
—DREDGE FIELDING.—  
GENERAL ARRANGEMENT.  
NOVEMBER 1942  
SCALE 1/8" = ONE FOOT.  
DRAWN BY H. H. H. APPROVED BY J. R.  
DRAWING NO. 1524



DREDGE FIELDING  
GENERAL ARRANGEMENT

E 1509/2

"Kiding Mountain Park"  
St. J. 544



© 2020

Lloyd's  
Foundation