

- "DREDGE FIELDING" -

- PROPOSED CONVERSION TO OIL CARRIER -

- SECTIONS IN WAY OF OIL TANKS -

- SCALE 1/2" = ONE FOOT -

FIRST LONGITUDINAL NUMBER (L x D) = 4,320

SECOND LONGITUDINAL NUMBER L x (B x D) = 14,400


EQUIPMENT NUMBER = 15,552 LETTER Q

1/2 DIA RIVETS THROUGHOUT EXCEPT THROUGH KEEL BUTTS WHICH ARE TO BE 3/4 DIA

NOTES FOR LONGITUDINALS ARE TO BE WELL COVERED AT JOINTS AND NOT RIVET PUNCHED

- SECTION AT MIDSHIPS - IN WAY OF TRANSVERSES -

- SECTION AT MIDSHIPS - CLEAR OF TRANSVERSES -

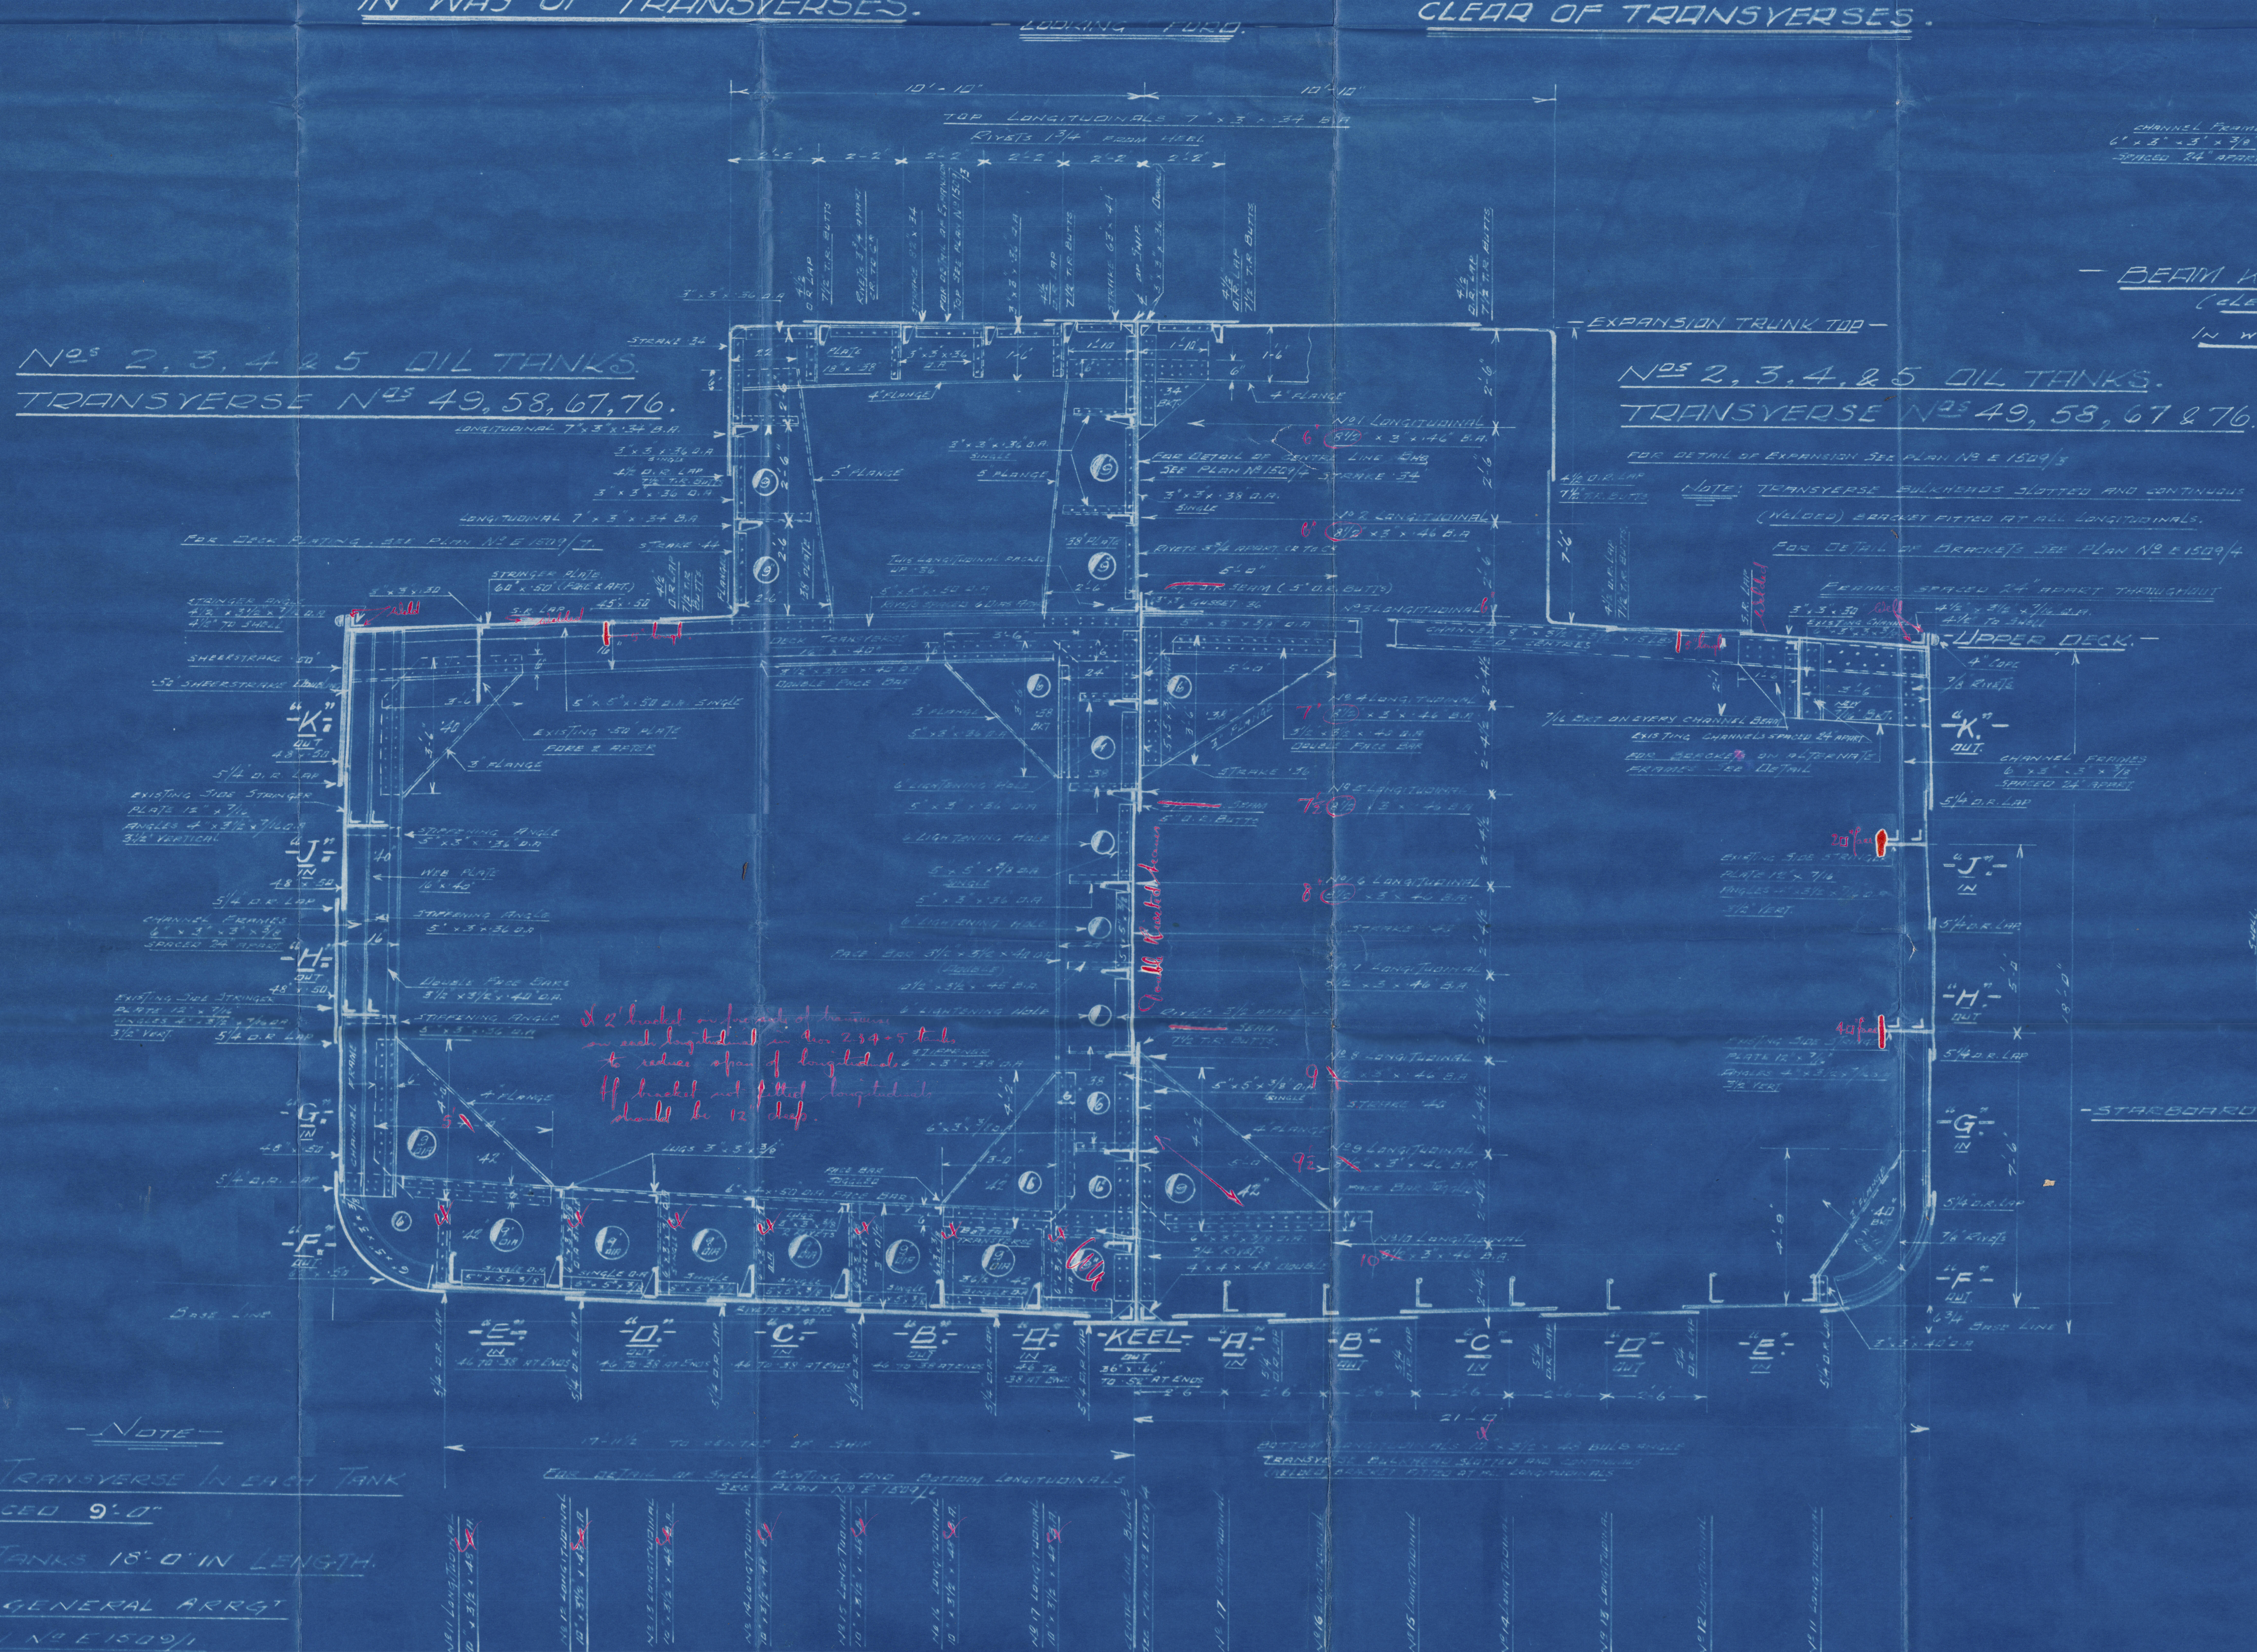

DIMENSIONS	
Length (B.P.)	940'-0"
Breadth (Mid.)	48'-0"
Depth (Mid.)	18'-0"

EQUIPMENT SUMMARY	
L x (B x D)	940' x (48' x 18') = 14,400
F tole	1/2" x 7.5' = 155
Poop	1/2" x 7.5' = 155
Trunk	1/2" x 7.5' = 155
Total	15,552
EQUIPMENT LETTER	"Q"

Notes: Equipment ordered to First General Arrangement. Subsequent alteration to length of Poole and Trunk necessitated figures being amended.

- EQUIPMENT -

ANCHORS
3 BOW ANCHORS (KAYLERS)
(35,000 LBS)
(35,000 LBS)
(35,000 LBS)
1 STEERING ANCHOR (35,000 LBS)
CHAIN CHAINS
STEEL CHAIN CABLE 242 FATHOMS
1 1/2" MINIMUM SIZE
TERRACE CHAIN OR STEEL WIRE (STEEL WIRE)
CHAIN LBS
STEEL WIRE
TOWING (300 FATHOMS)
1 1/2" MINIMUM SIZE
HAWKERS (HAWK OR STEEL WIRE)

- O.T. BULKHEADS -

TRANSVERSE	5' x 3/4" x 48' B.A. (15,000)
"	7' x 3/4" x 48' B.A. (17,000)
"	6' x 3/4" x 48' B.A. (13,000)
PLATING "D" 5/16" x 48'	
"	5/16" x 48' x 48'
"	5/16" x 48' x 48'
"	5/16" x 48' x 48'

See Plan No. 15509/5

FRAMES SPACED 24' THROUGHOUT

- SECTION IN WAY OF NO. 1 TANK - - BETWEEN FRAMES 81-91 -

- WEBS ON FRAME NOS. 84 & 89 -



The electric welding must be done with the approved electrode, and the electrodes must be of the correct size for the application of the welding.


DREDGE FIELDING

MIDSHIP SECTION

E 1509/1

Basingford,
ex
"Riding Mountain Park"
St. J 544

RETAIN



© 2020

Lloyd's Register
Foundation

W1011-0884