

28 AUG 1946


No 1354.

MODIFIED FRAMING IN No 1 HOLD.

SCALE 1/16" = 1 FOOT.

*Painting stowage to be fitted
w shell plating increased per
Sec. 7. of Rules.*

SHELL PLATING
INCREASED.

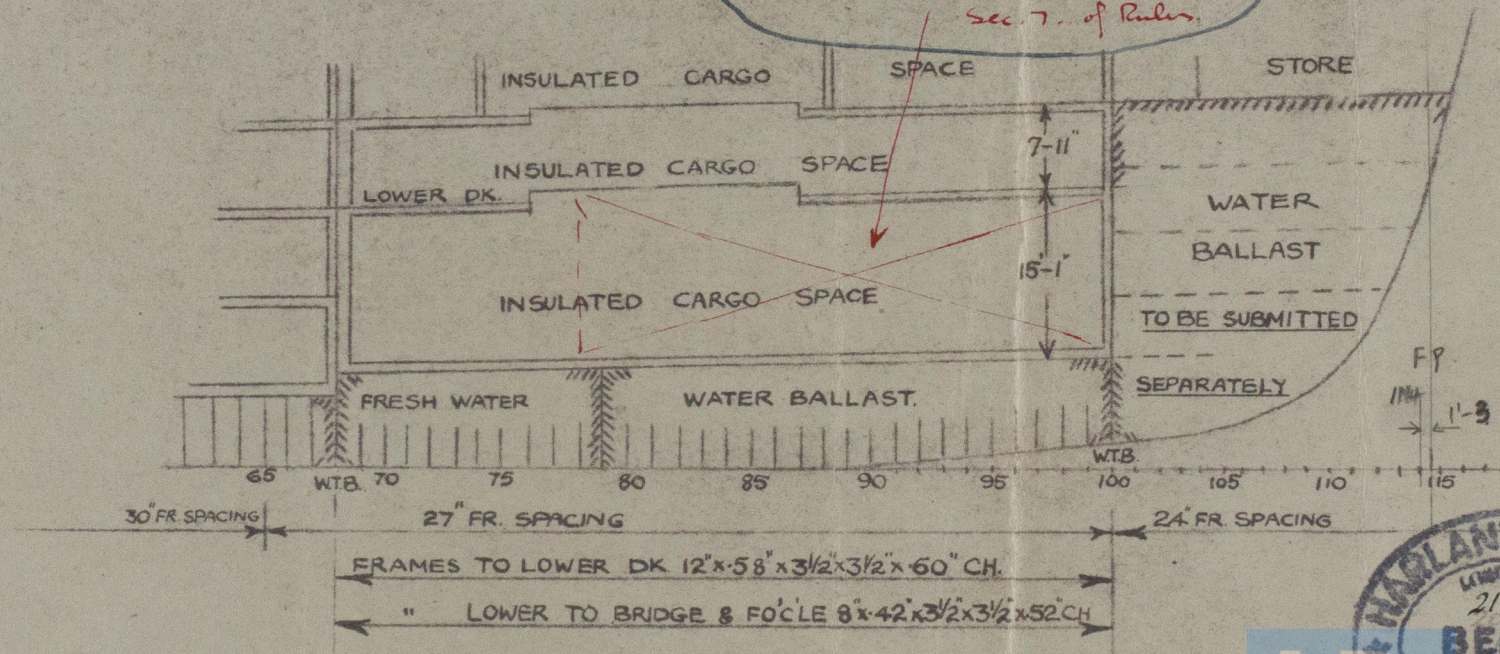

M
28.8.46

Lloyd's Register
Foundation

W1012-0170

5

HARLAND & WOLFF LTD.
BELFAST



No. 1354.

TITLE *mod. to framing at
fore end*

DATE APPROVED 28/8/46.

Bel. npt. No. _____



© 2020
Lloyd's Register
Foundation