


7-2-17  
24.4.17  
29.6.17  
18.6.17


PROFILE.  
NEW 519.  
SCALE  $\frac{1}{8}'' = 1 \text{ FOOT}$ .

$$\frac{32 \times 76 \times 8}{166} = 83$$

Approved JRM  
27/1/17

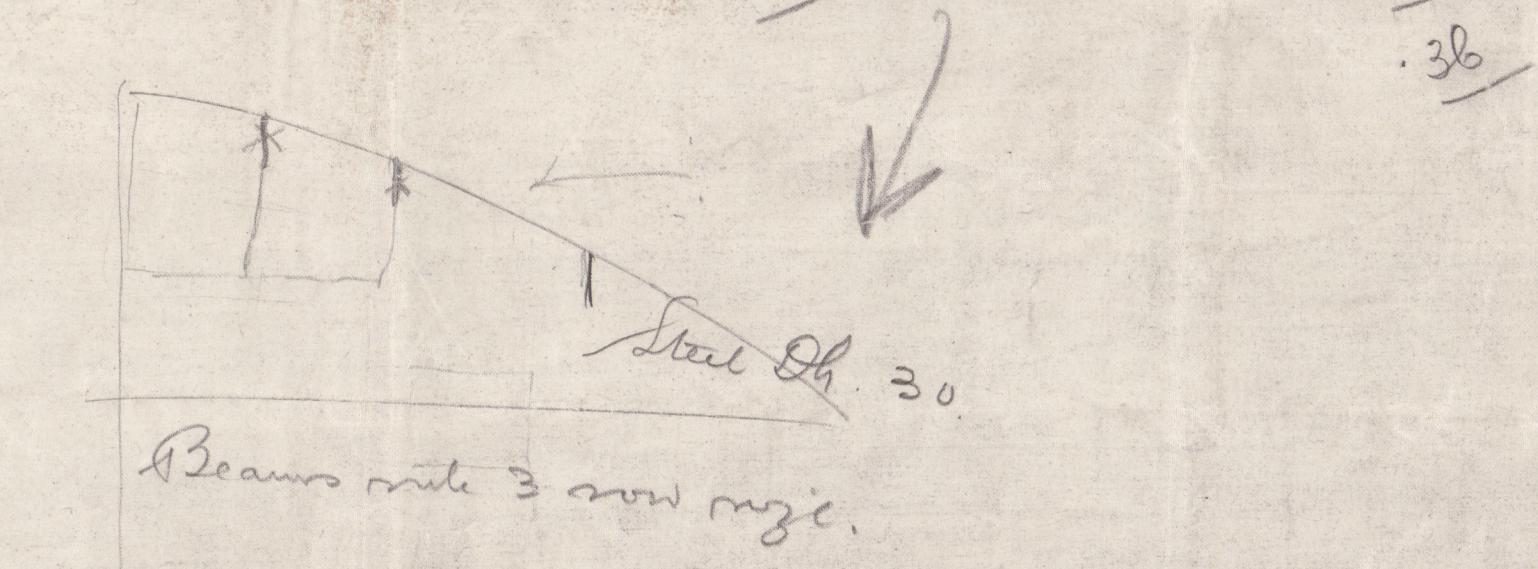

For 6 x 3 x 36 B.A. bolted to deck

 


Plating arrangement to be submitted.

Beam plate change

Plating arrangement to be submitted.

6.6/7.2.17







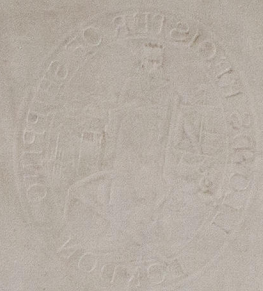

*Lloyd's*

*Maltrona*

GLASGOW REPORT No 38170.  
*3/5 Glenapp.*

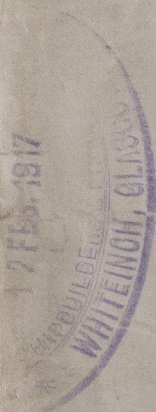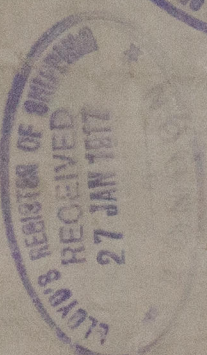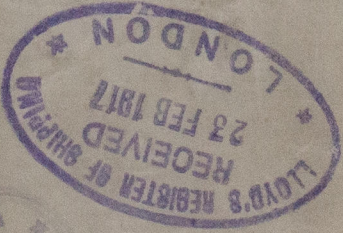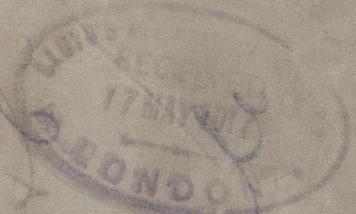

**RETAIN**

22

W1012-0234



© 2020  
Lloyd's Register  
Foundation