


	Sta
	to
	To


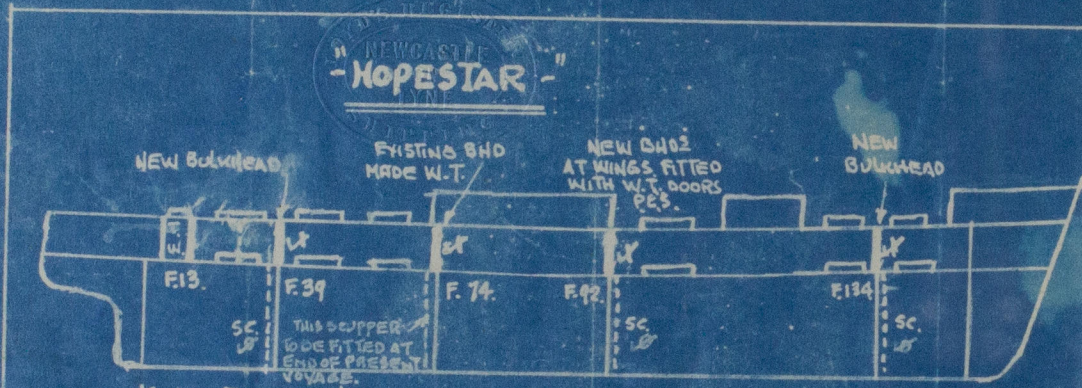

LT DENOTES NEW 'TWEEN OR BULKHEADS  
 LR " " " " SCUPPERS LED TO BILGES.

1840

a slightly c  
 a new day  
 under refa

It i

It is  
eligible  
vol. 9.43

The

Lloyd's Register  
Foundation