
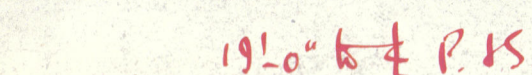
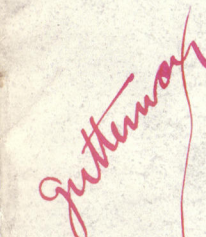


W1013-0209

ADDITIONAL OIL FUEL TANK IN DEEP TANK


SCALE: ~ $\frac{1}{4}" = 1 \text{ FOOT}$

OVER FLOW 2'-6 ABOVE SHELTER DK.

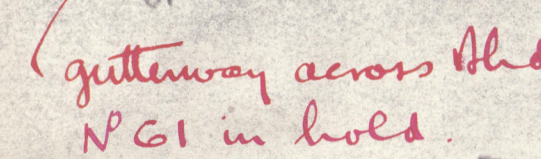


Additional

SECTION THROUGH TANK
LOOKING FORWARD

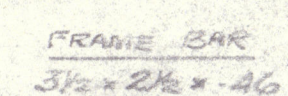

W.T. BULKHEAD No 74

LOOKING FORWARD,
TO BE MADE OILTIGHT

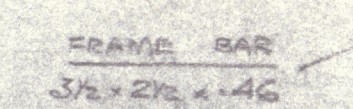

W.T. BULKHEAD N° 61

LOOKING AFT
TO BE MADE OILTIGHT


W1013-0204