

COPY.

WOKINGHAM.

C. 16988

Lloyd's Register of Shipping.

Port NEWCASTLE-on-TYNE.30th September, 1943

This is to Certify that

E.H. DEAN and K. LITTLE,

the undersigned Surveyor^s to this Society did at the request of ~~XXXXXXXXXXXXXXXXXXXX~~ in collaboration with the local officers of the Ministry of War Transport, survey the s.s. "HOPESTAR", 5267 tons gross of Newcastle as she lay afloat and in drydock at Wallsend-on-Tyne, in connection with the extension of the main W.T. bulkheads to the shelter deck.

Four additional W.T. bulkheads suitably stiffened have now been fitted in the shelter 'tween decks as shown on sketch attached herewith. On completion, these bulkheads were hose tested with satisfactory results.

These arrangements are in accordance with circulars "Ministry of War Transport M.152576/42" and "Merchant Shipbuilding Department, M/S.603/42."

Suitable scupper pipes led to bilges have now been fitted to the new 'tween deck spaces formed by these bulkheads as shown on sketch.

One scupper pipe yet to be fitted port and starboard sides just aft of deep tank. This will be effected on completion of present voyage.

Fee: - 24-4-0.

E. H. Dean & K. Little.

SURVEYORS TO LLOYD'S REGISTER.

This Certificate is issued upon the terms of the Rules and Regulations of the Society, which provide that:—

"While the Committees of the Society use their best endeavours to ensure that the functions of the Society are properly executed, it is to be understood that neither the Society nor any Member of any of its Committees is under any circumstances whatever to be held responsible for any inaccuracy in any report or certificate issued by the Society or its Surveyors, or in any entry in the Register Book or other publication of the Society, or for any error of judgment, default or negligence of any of its Committees or any Member thereof, or the Surveyors, or other Officers or Agents of the Society."

16/88

COPY


Lloyd's Register of Shipping



Plan

This is to certify that

the undersigned surveyor to this Society did at the request of

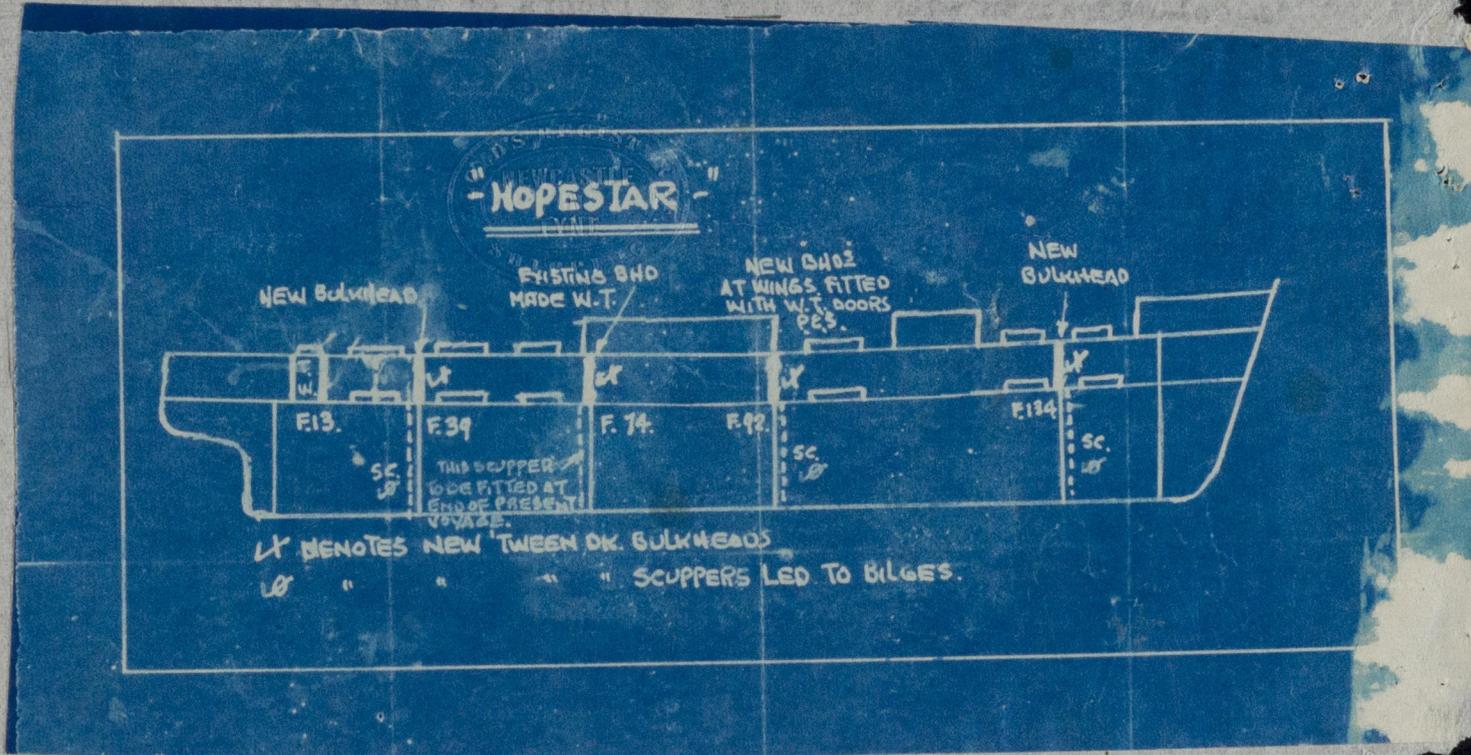


