


# SHIP No 1513

## WIRING DIAGRAM

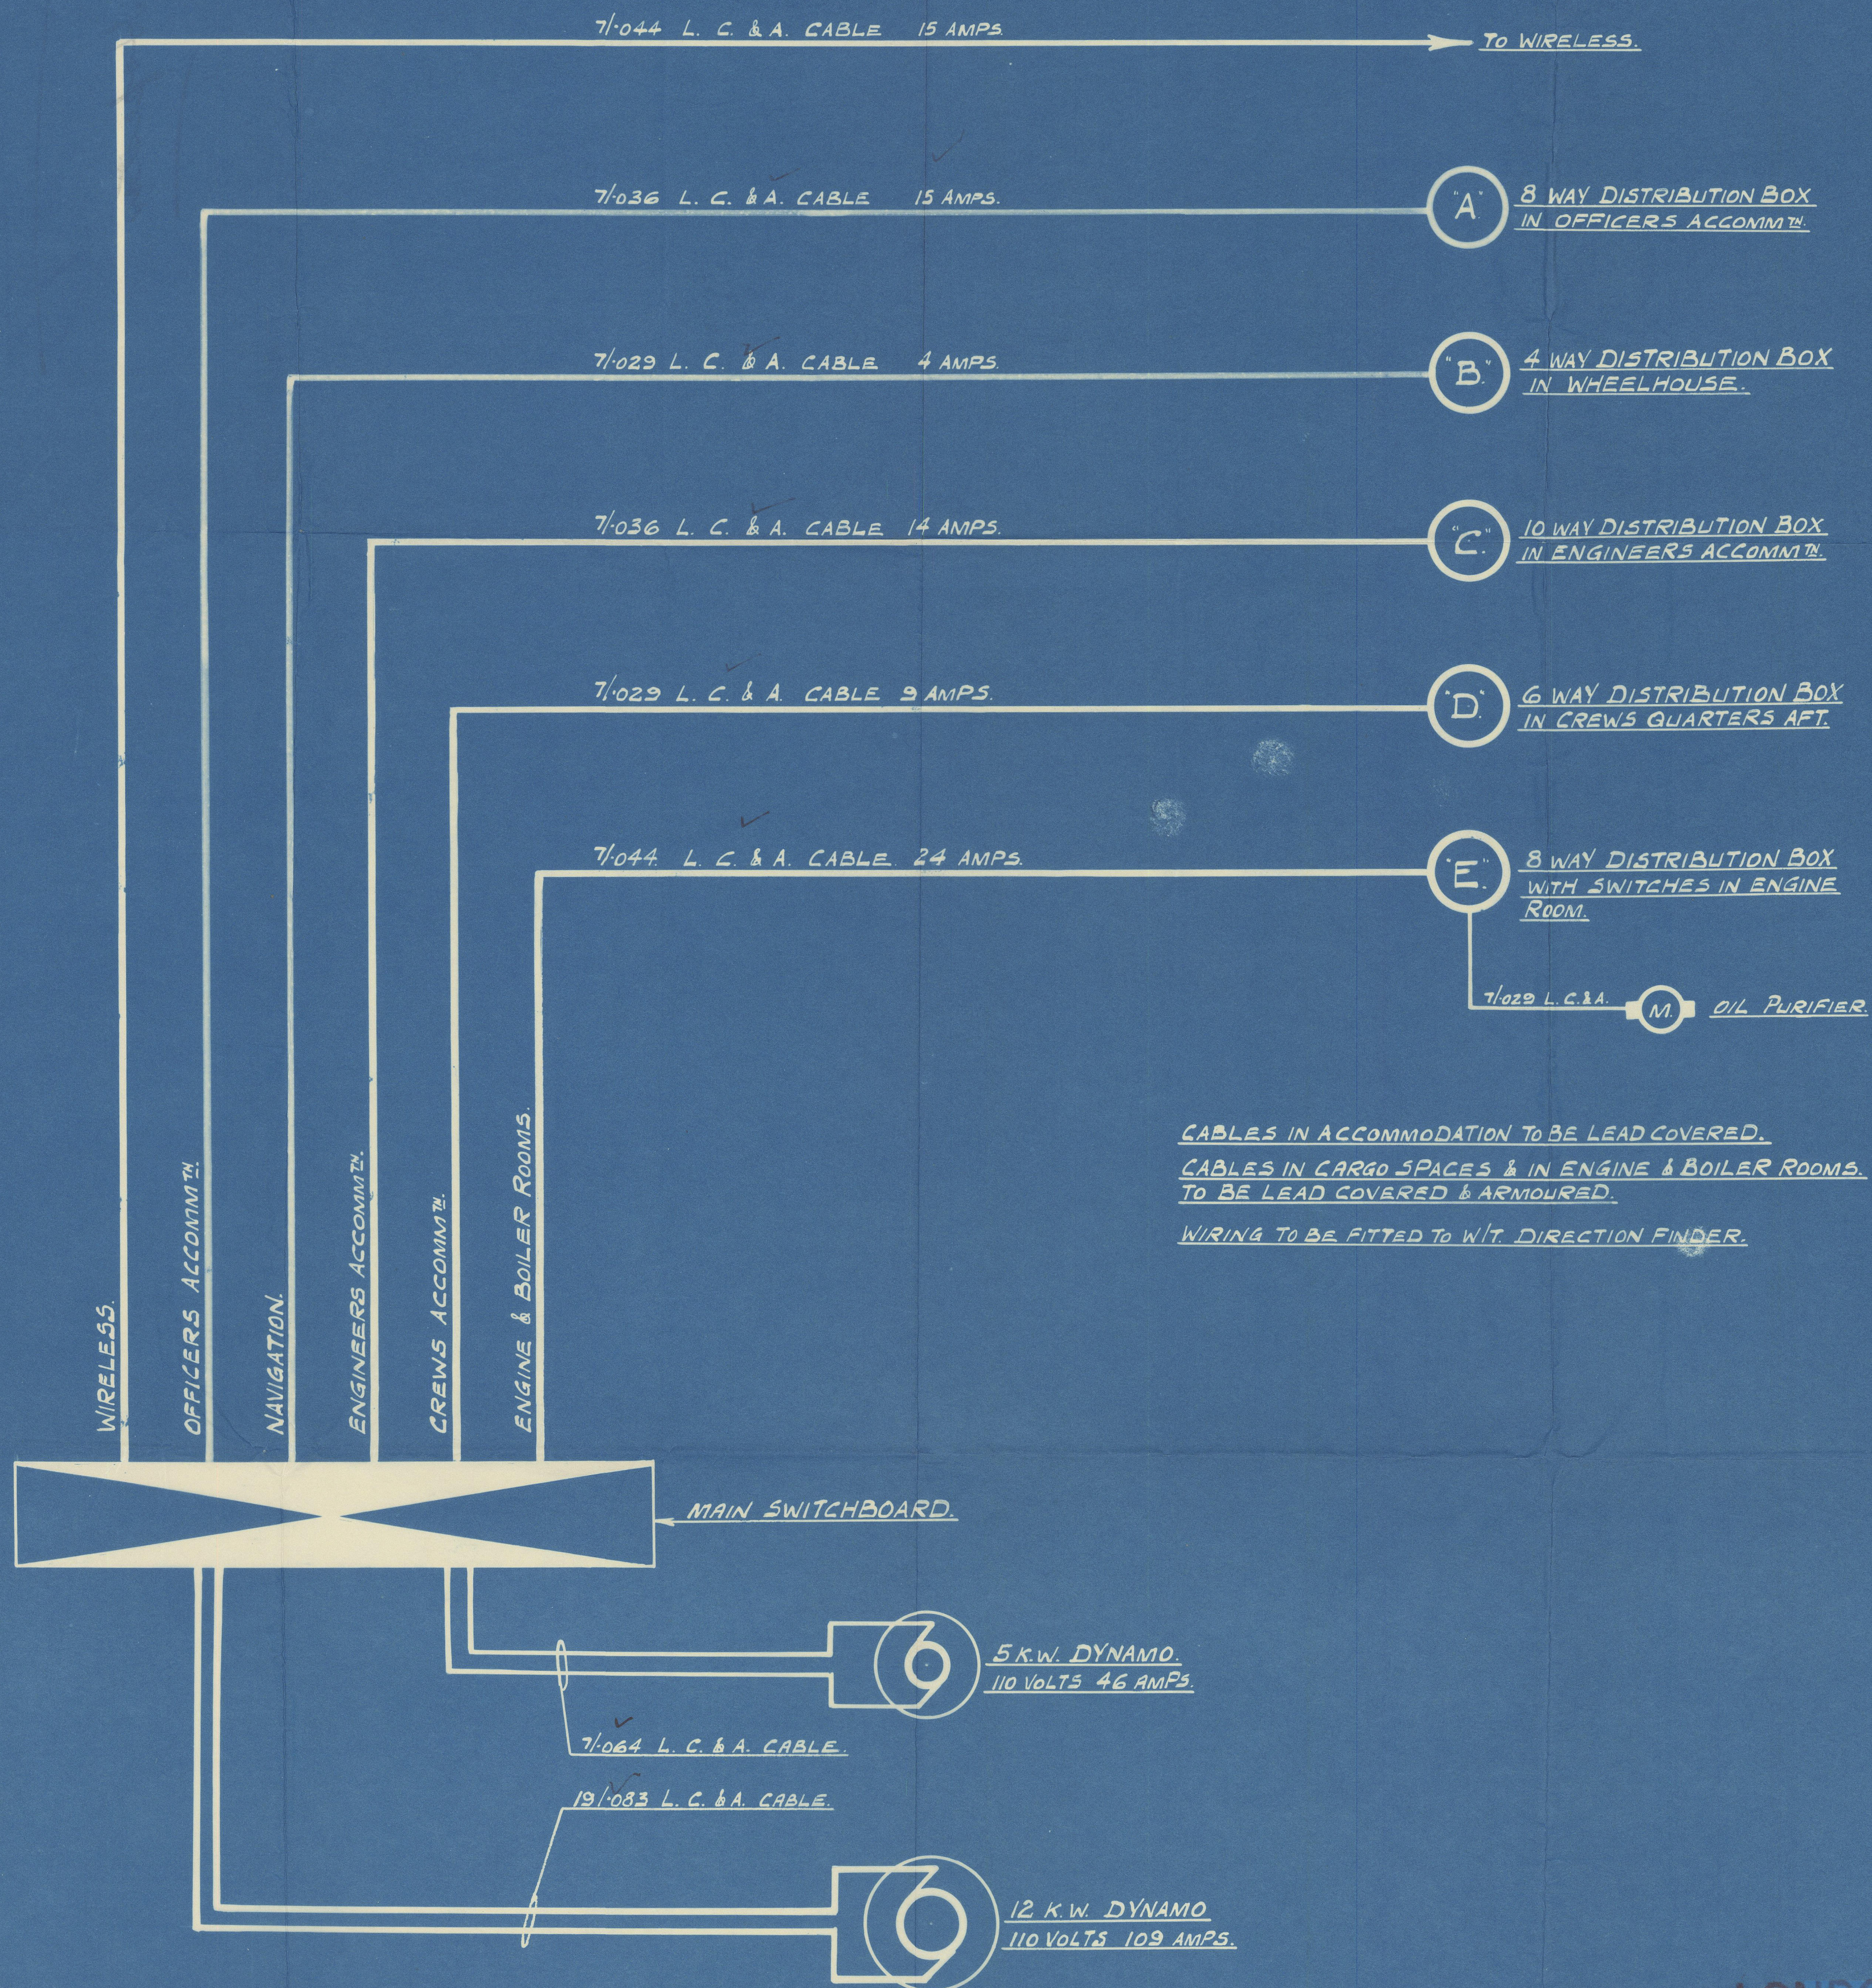

LONDON COPY

15.11.35  
LONDON COPY  
15.11.35  
WIRING



S H+WR Ship no 1513

Dir of connection

(wiring)

(34)

~~GEN BOX NO~~

~~70~~

Hooper



© 2020

Lloyd's Register  
Foundation

W1014-0139