




THE NORTH EASTERN MARINE ENGINEERING CO. LTD.  
WALLSEND - ON - TYNE  
COMBUSTION CHAMBER SUPERHEATER ARRANGEMENT  
SCALE: 1 INCH = 1 FOOT

17 OCT 1935  
2110

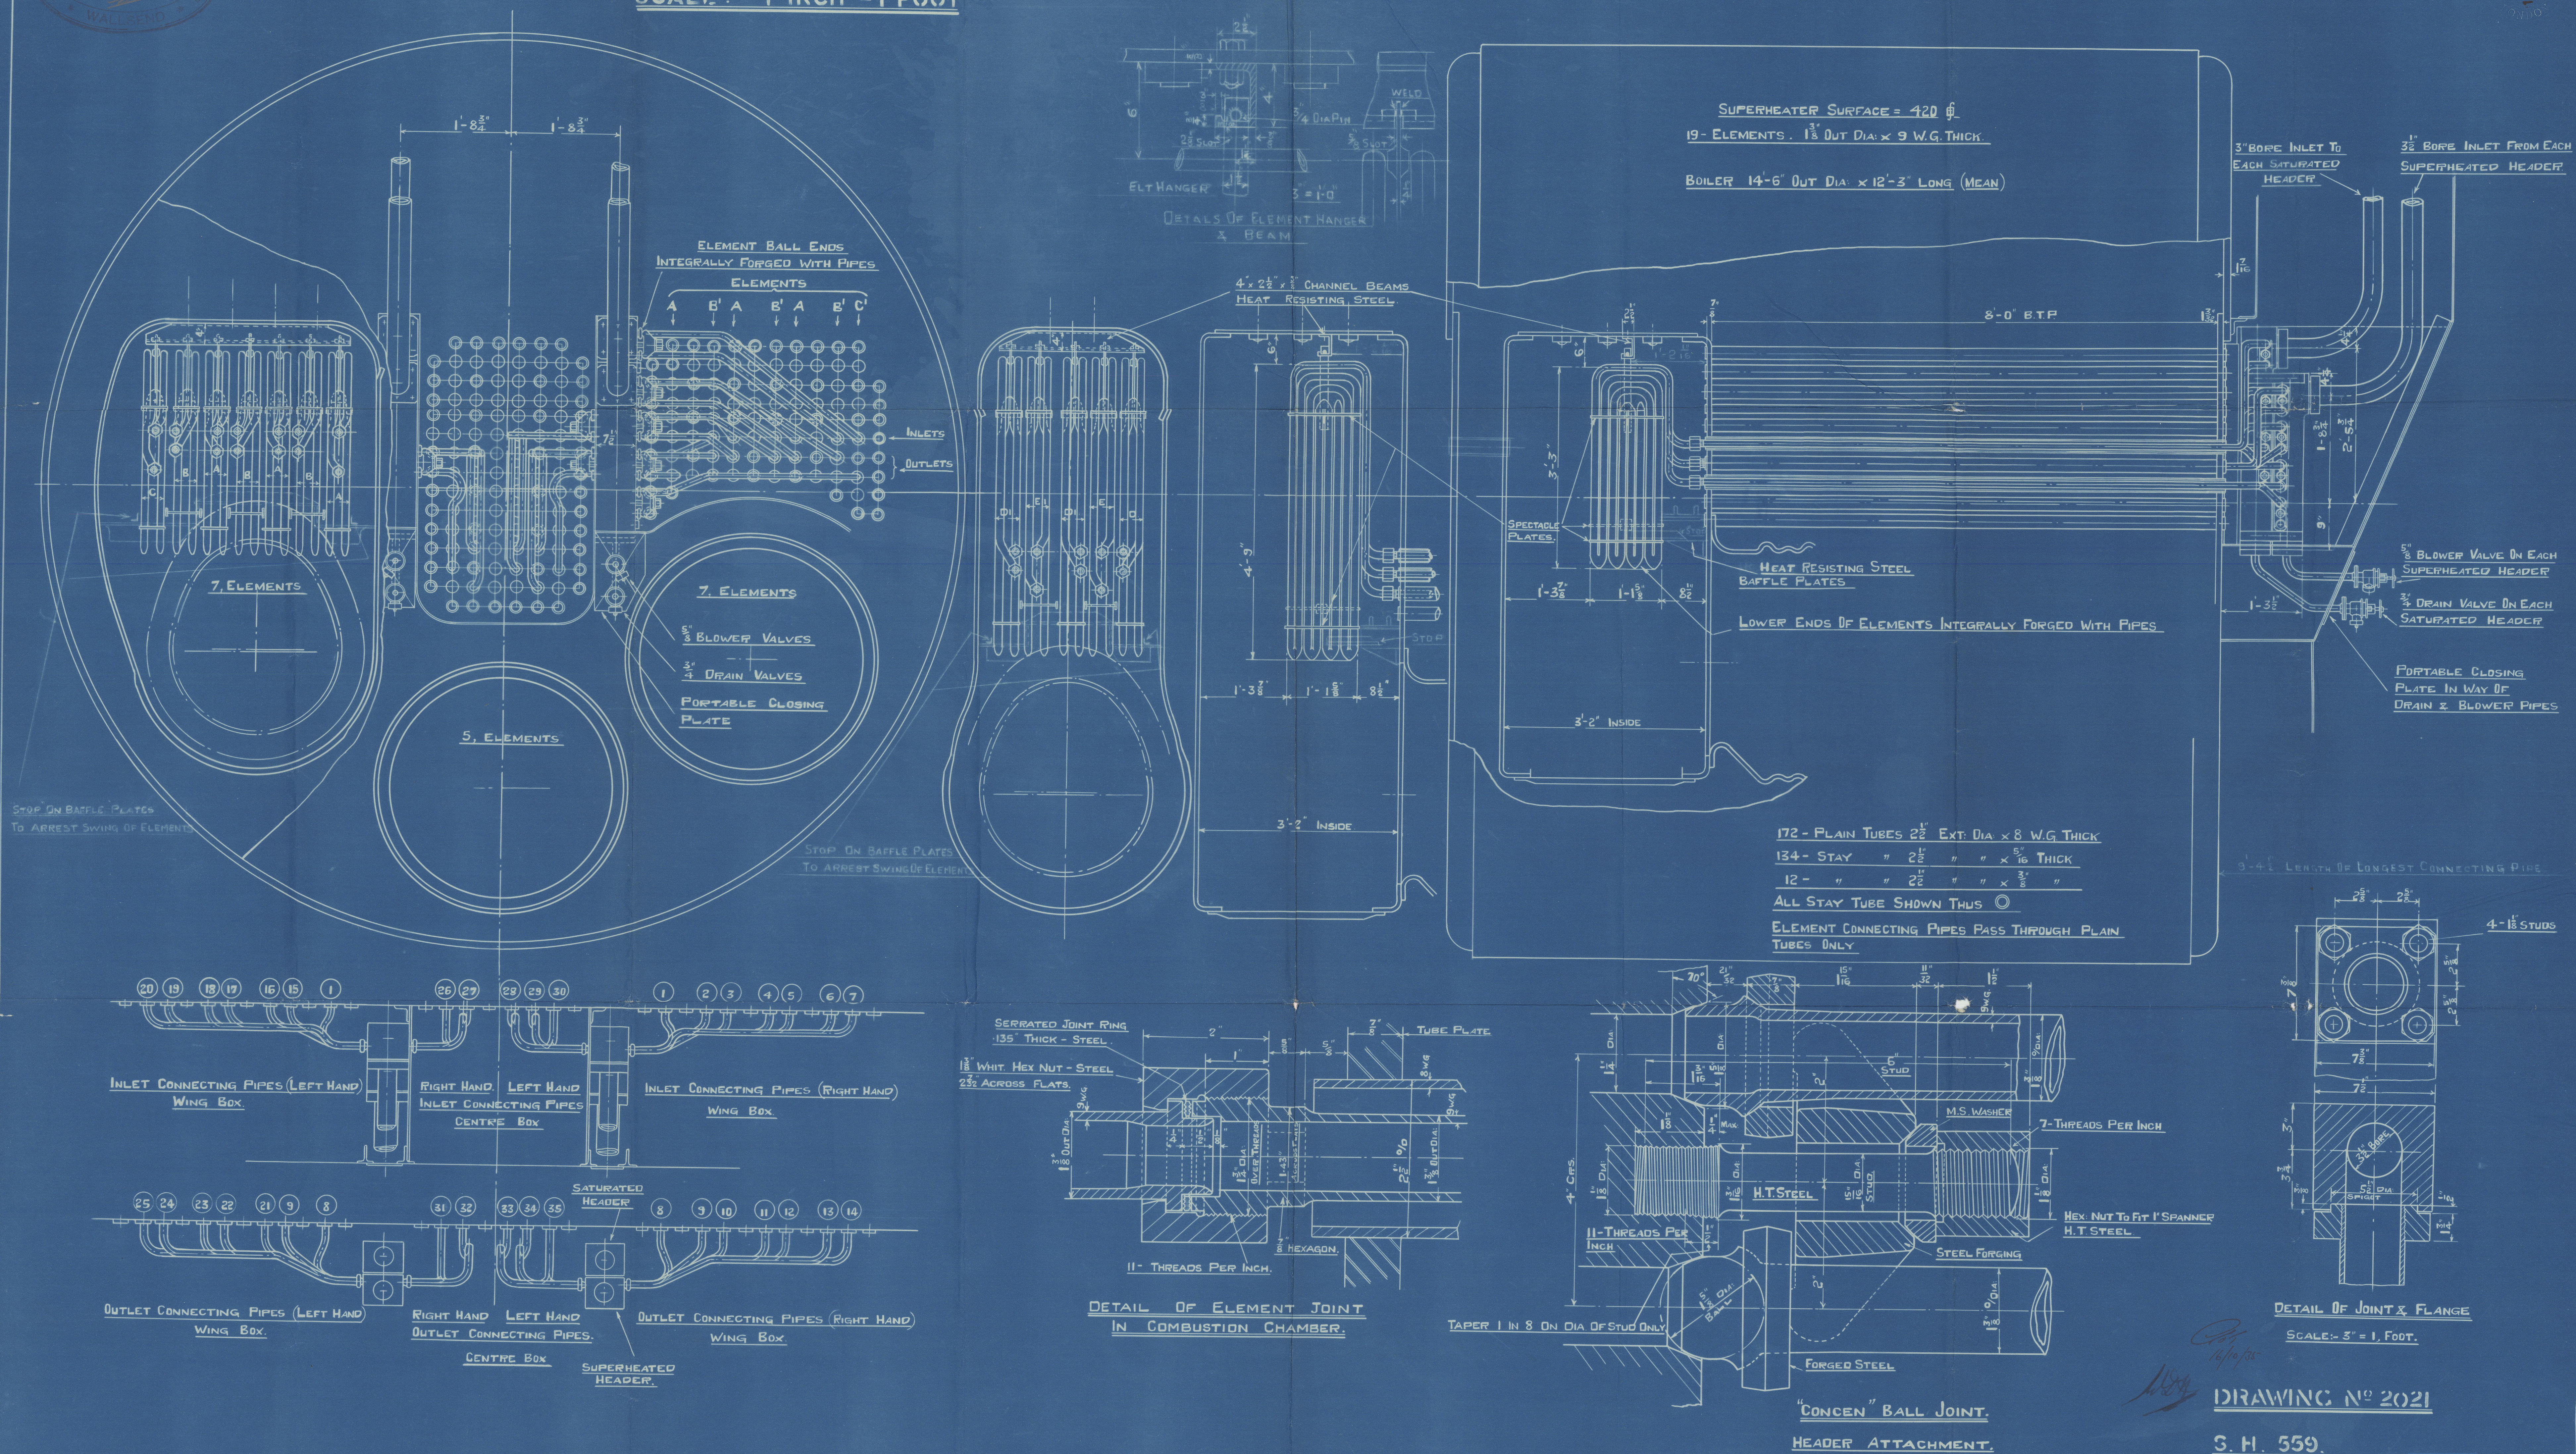

14/10/35  
W.S.  
DRAWING NO 2021  
S. H. 559.



The North Eastern Marine Eng. Co. Ltd.  
Combustion Chamber  
Superheaters S.H. 559

In  
The Wallsend Shipway Main Boilers 919

Swan Hunters Ship No 1513

SS "HOPESTAR"

NEWCASTLE ON TYNE.

Report No. 93528.

(14)



© 2020

Lloyd's Register

Approved 17.10.35

0104-0140