

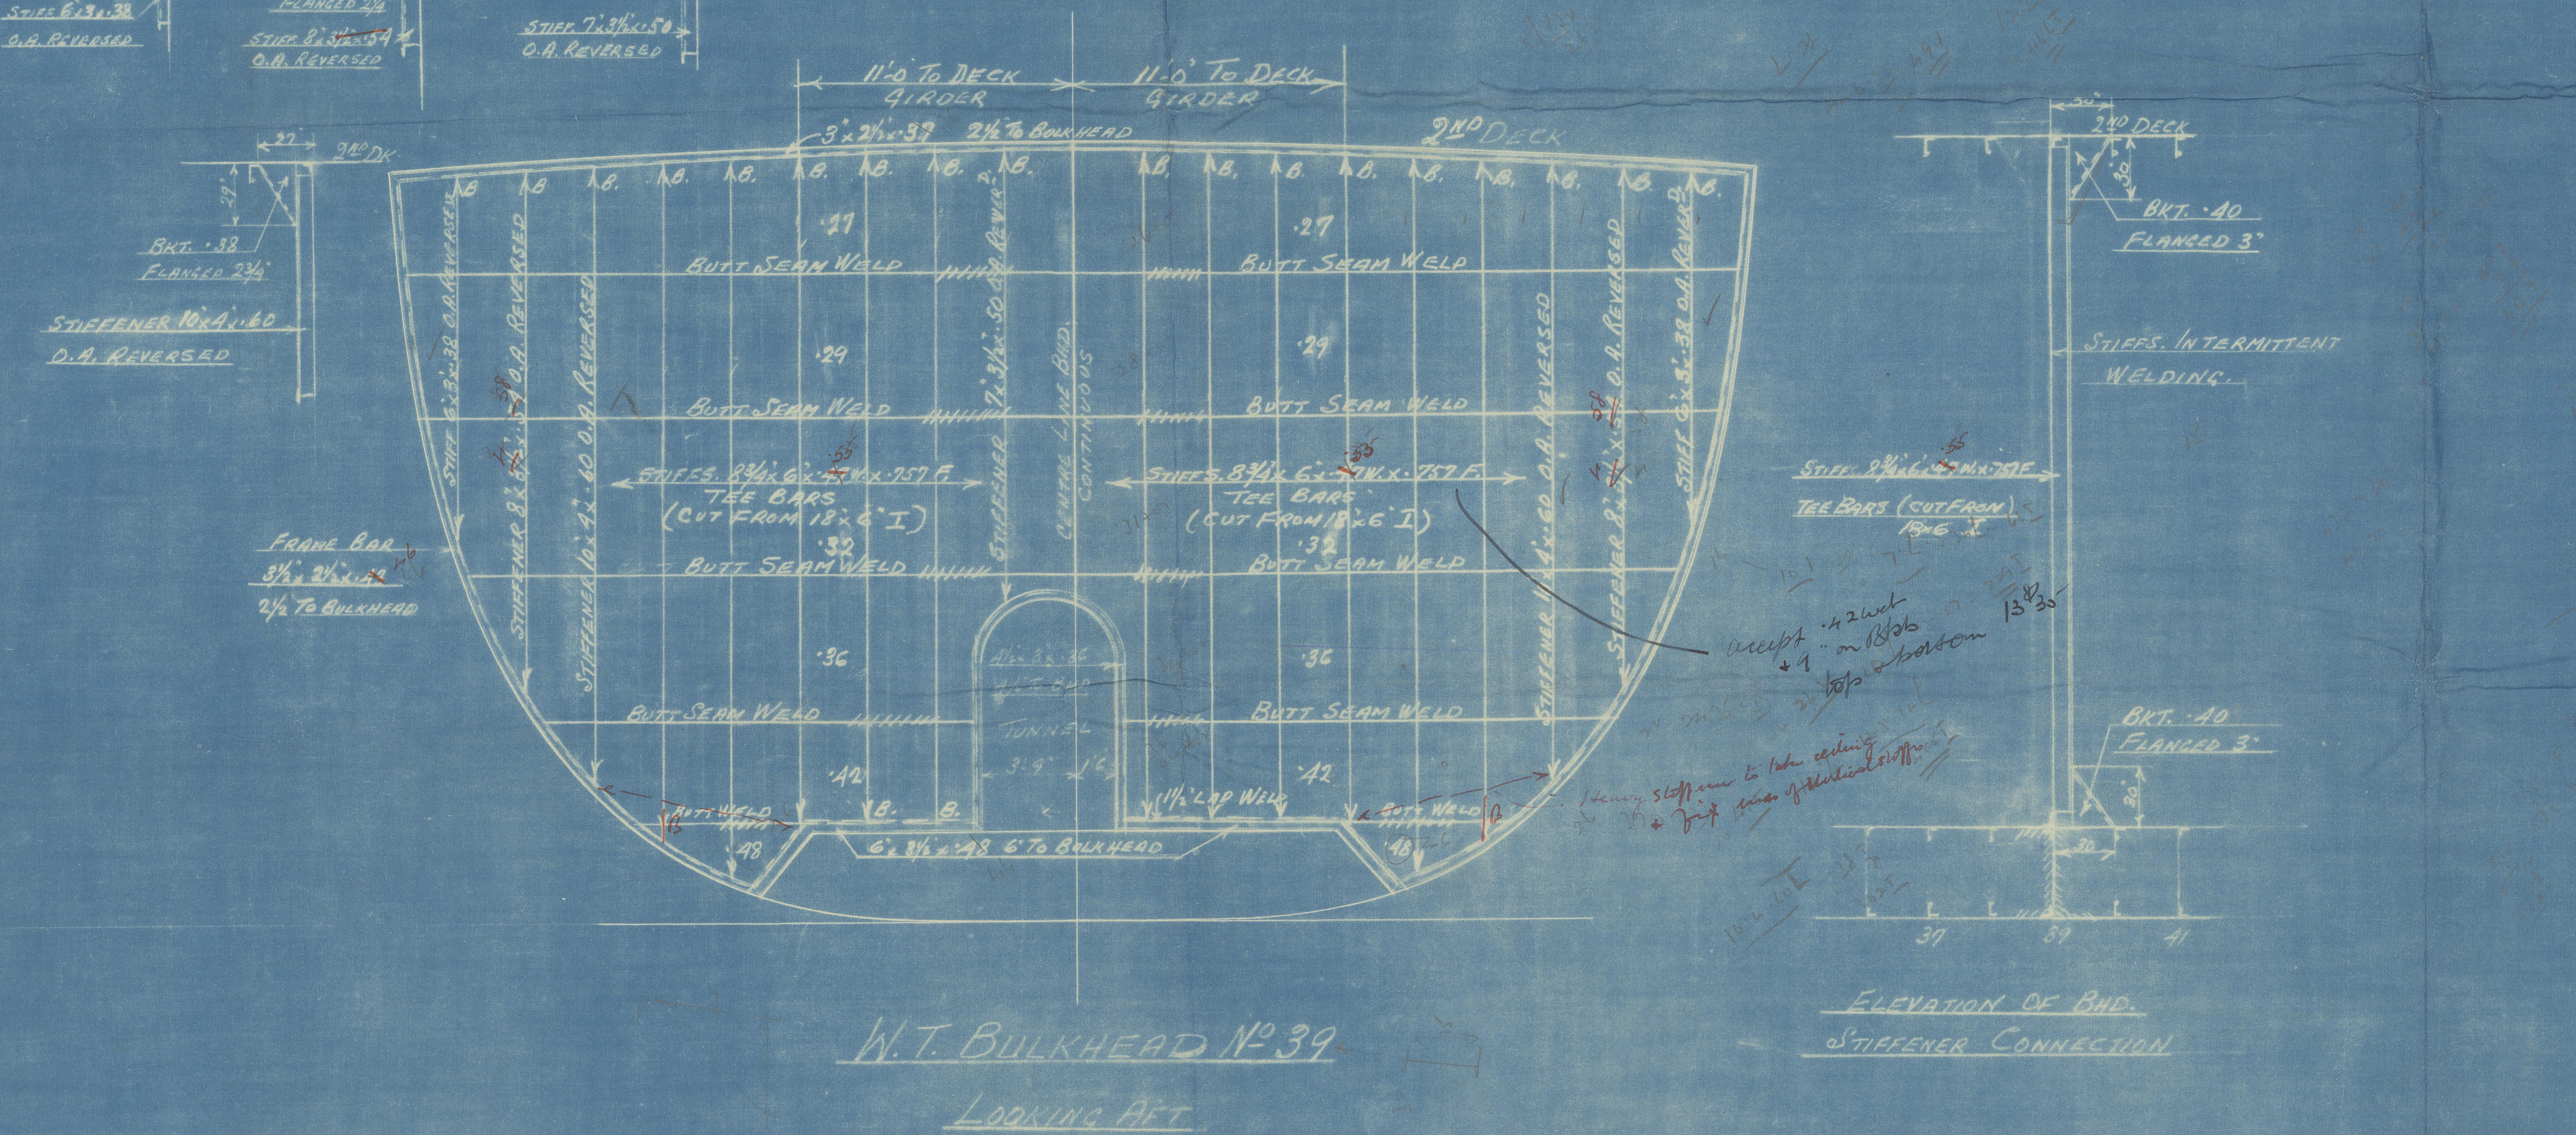
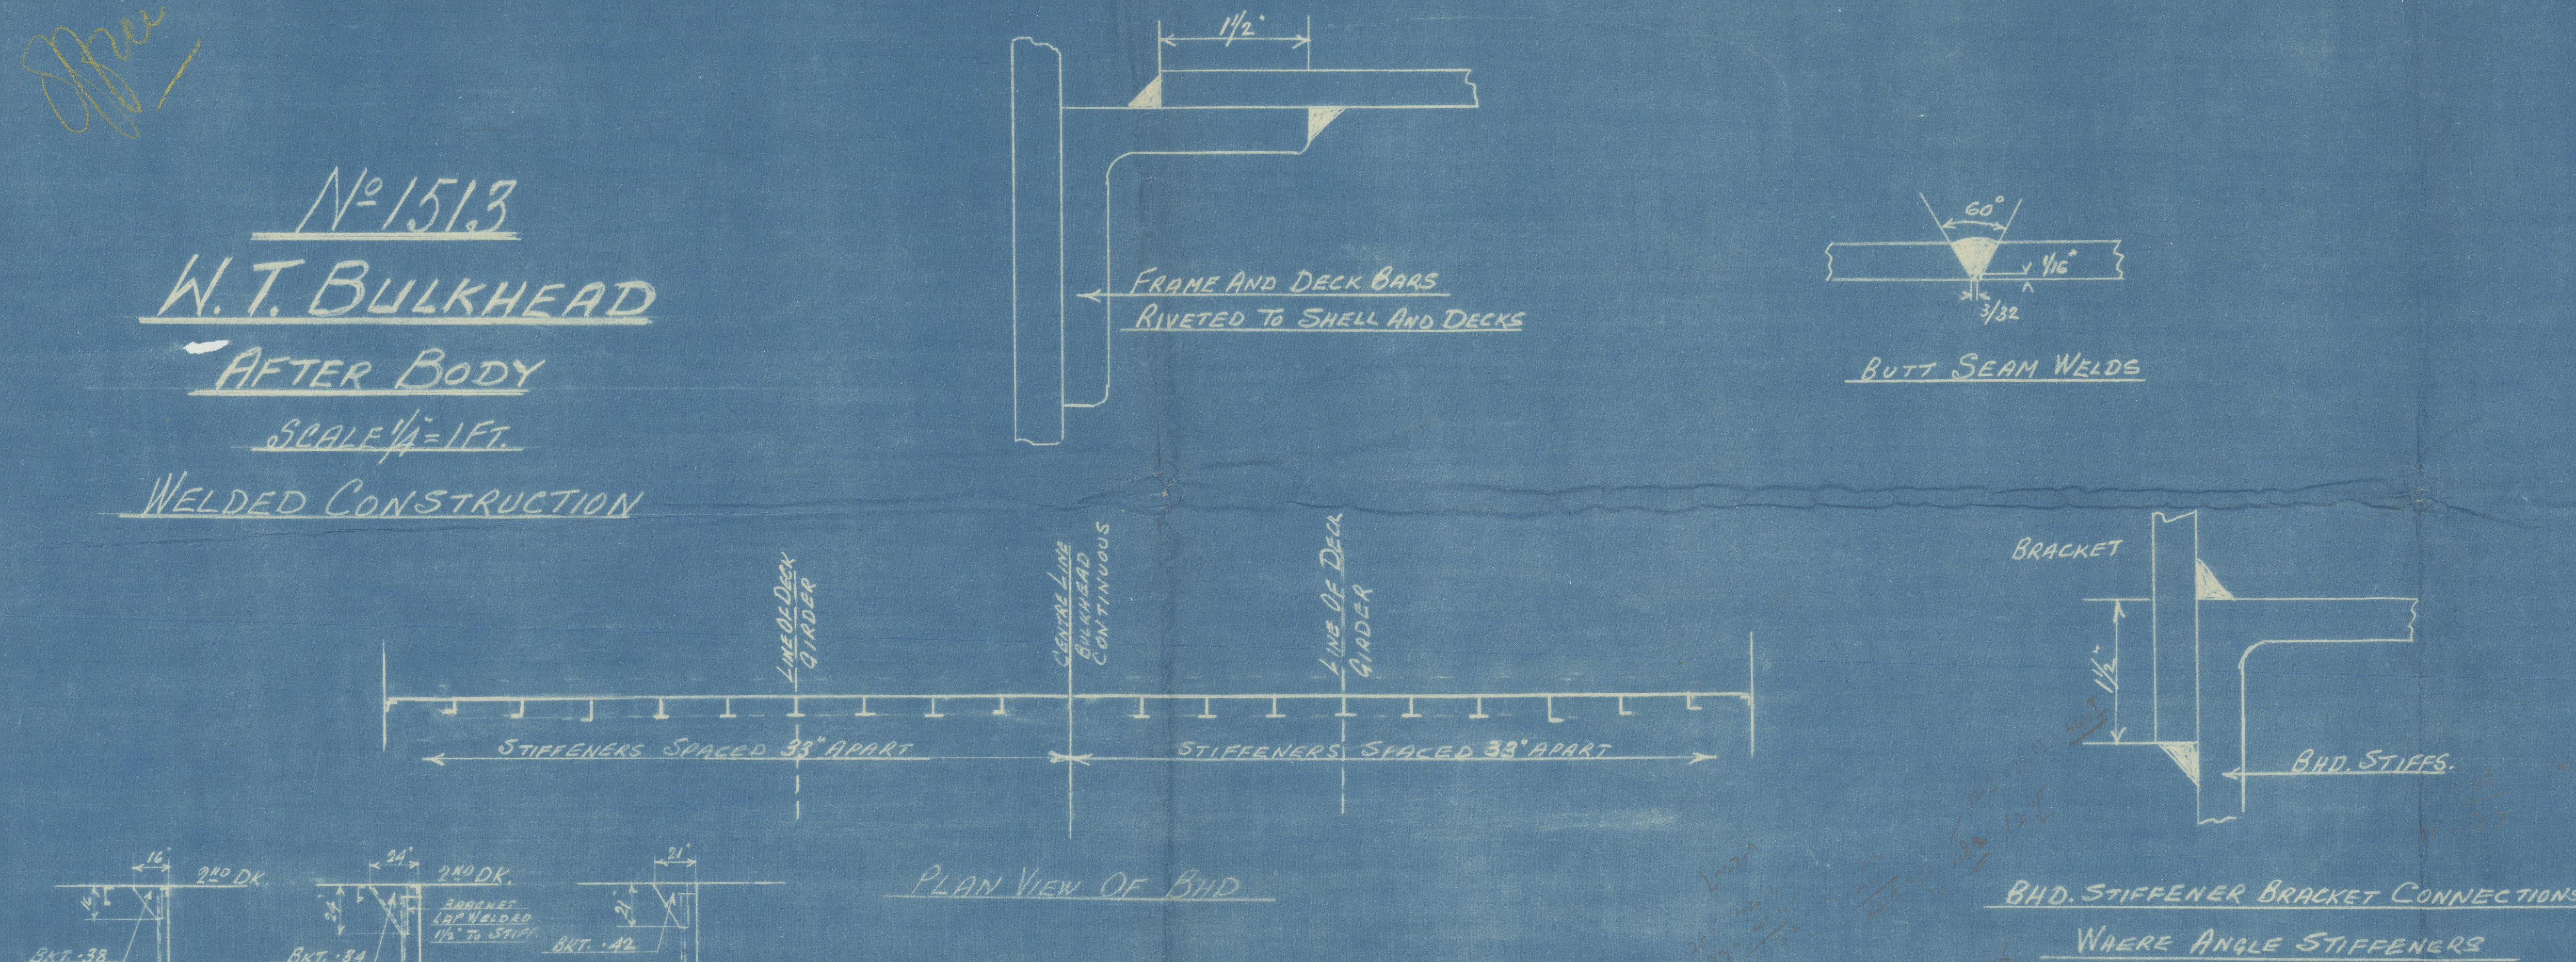


11/1


N^o 1513
W.T. BULKHEAD
AFTER BODY
SCALE 1/4" = 1 FT.
WELDED CONSTRUCTION

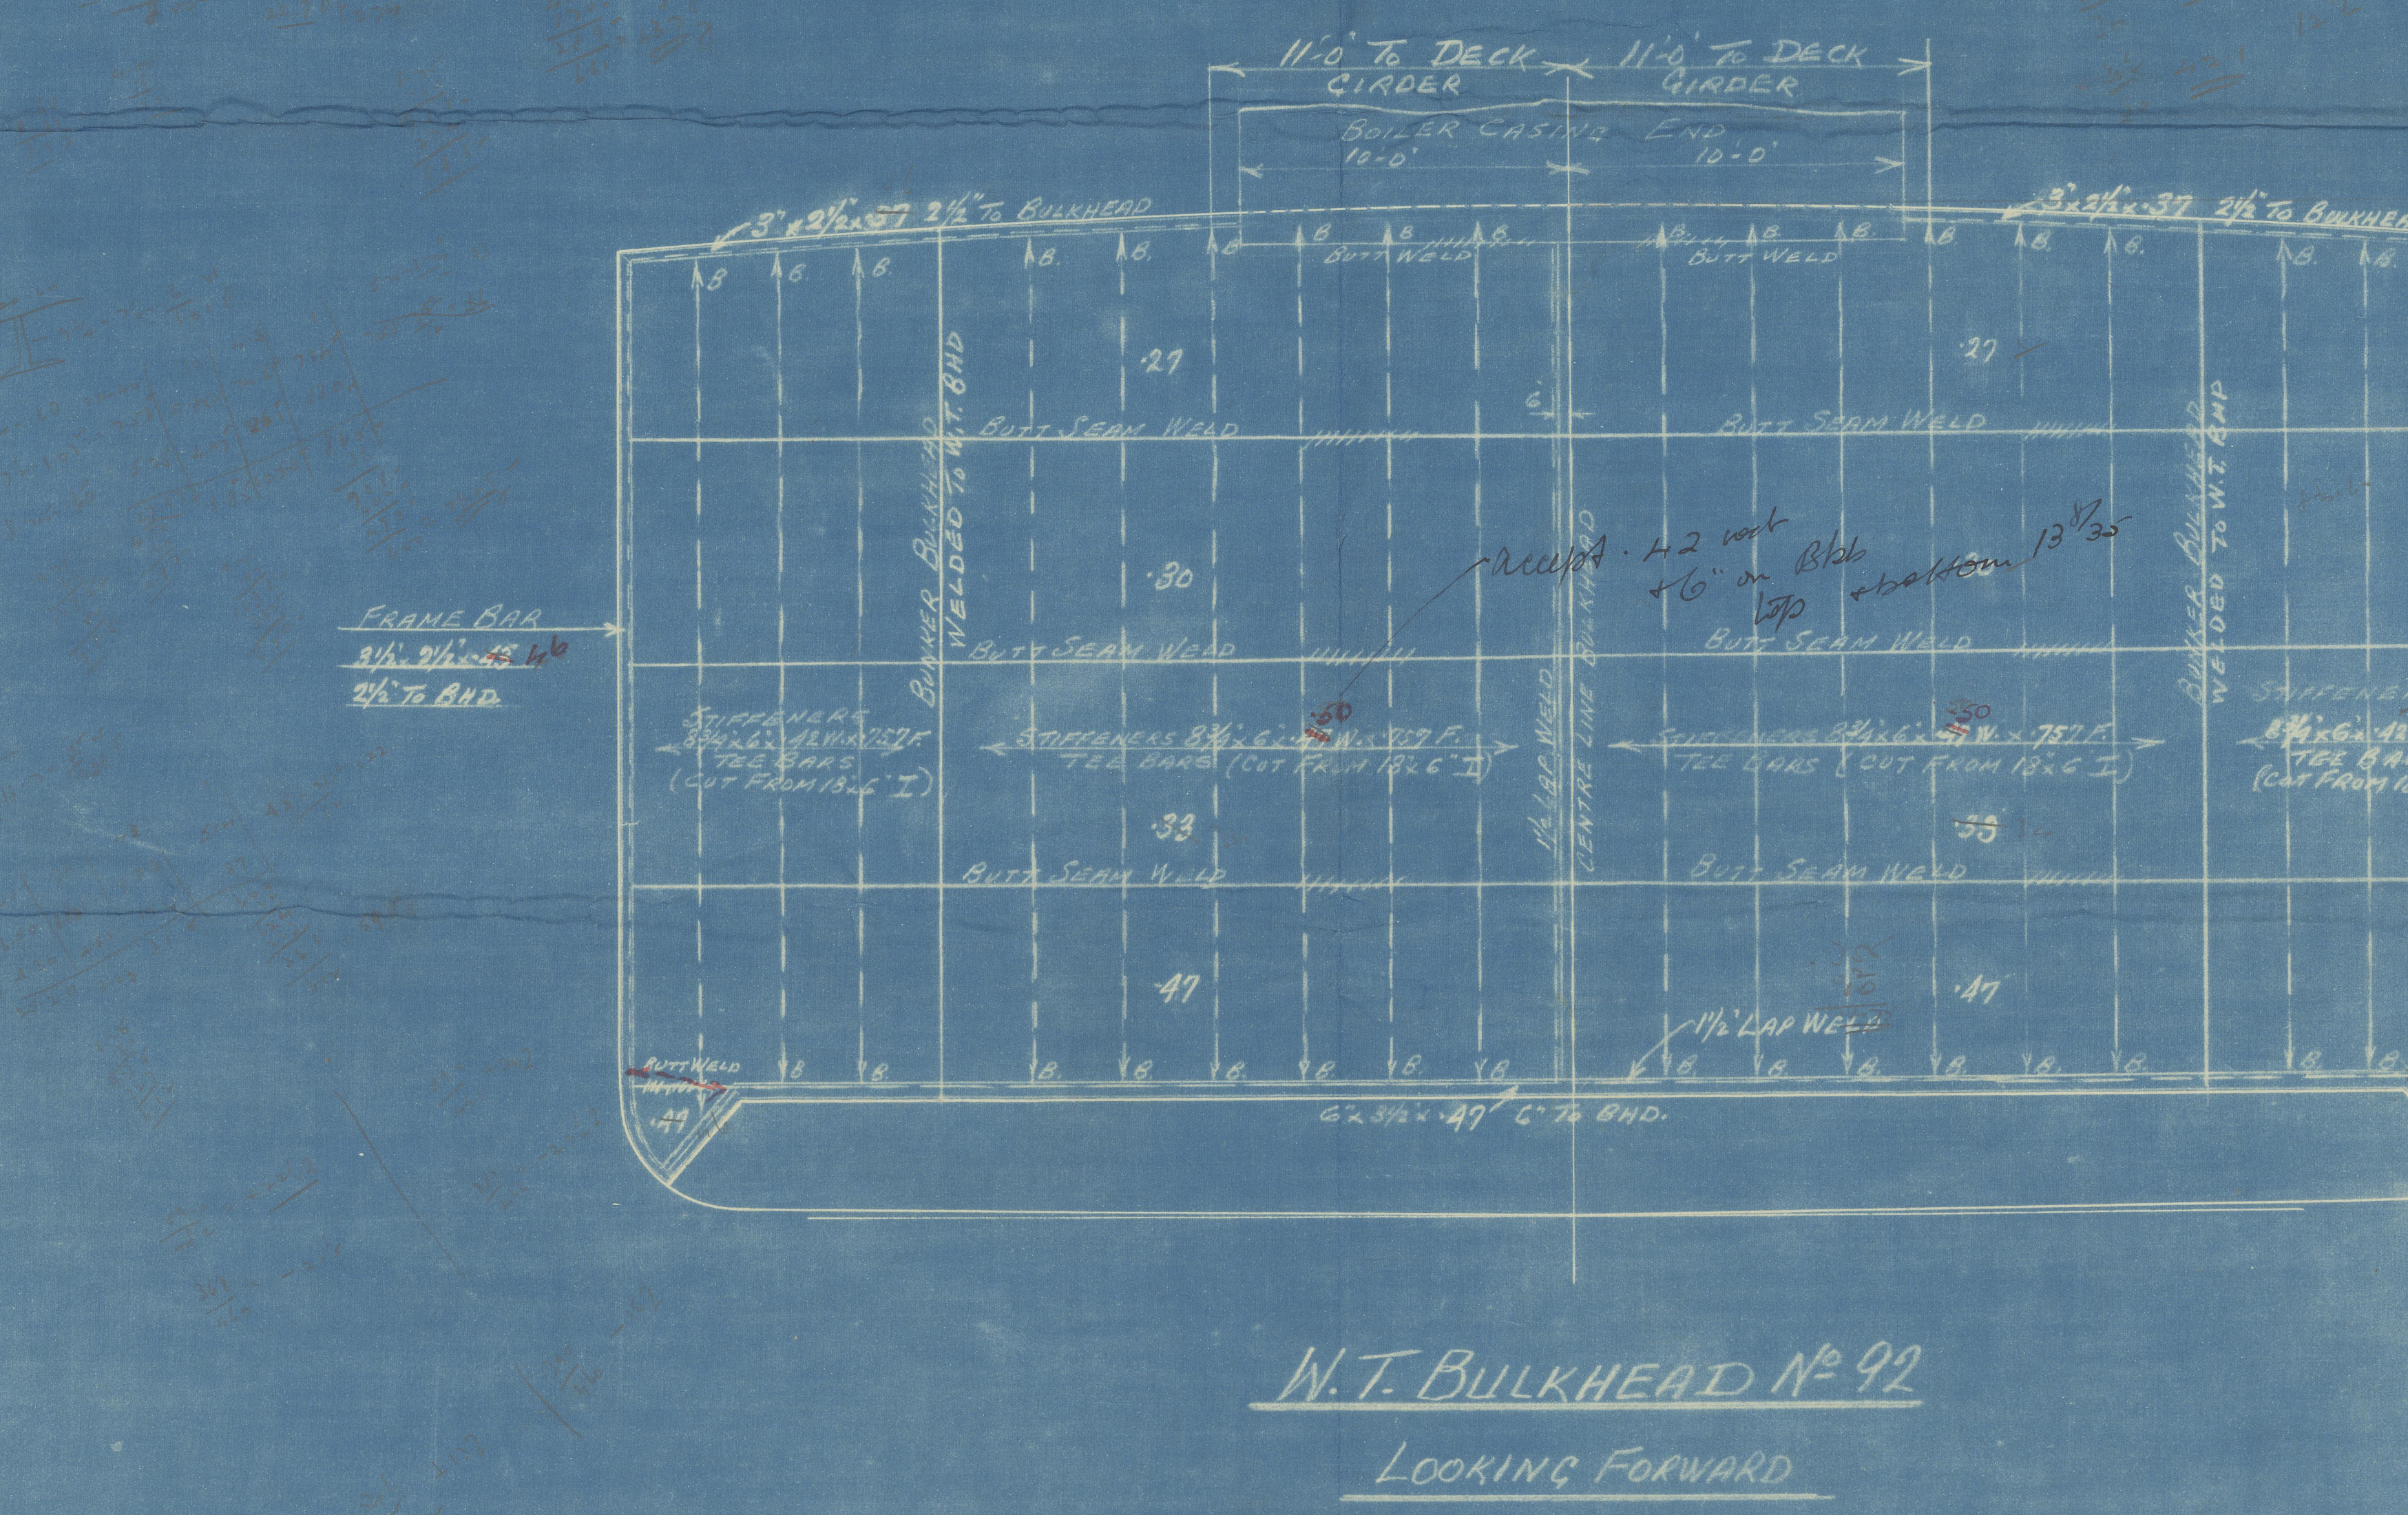

N^o 1513
W.T. BULKHEADS
FORE BODY
SCALE 1/4" = 1 FT.
WELDED CONSTRUCTION

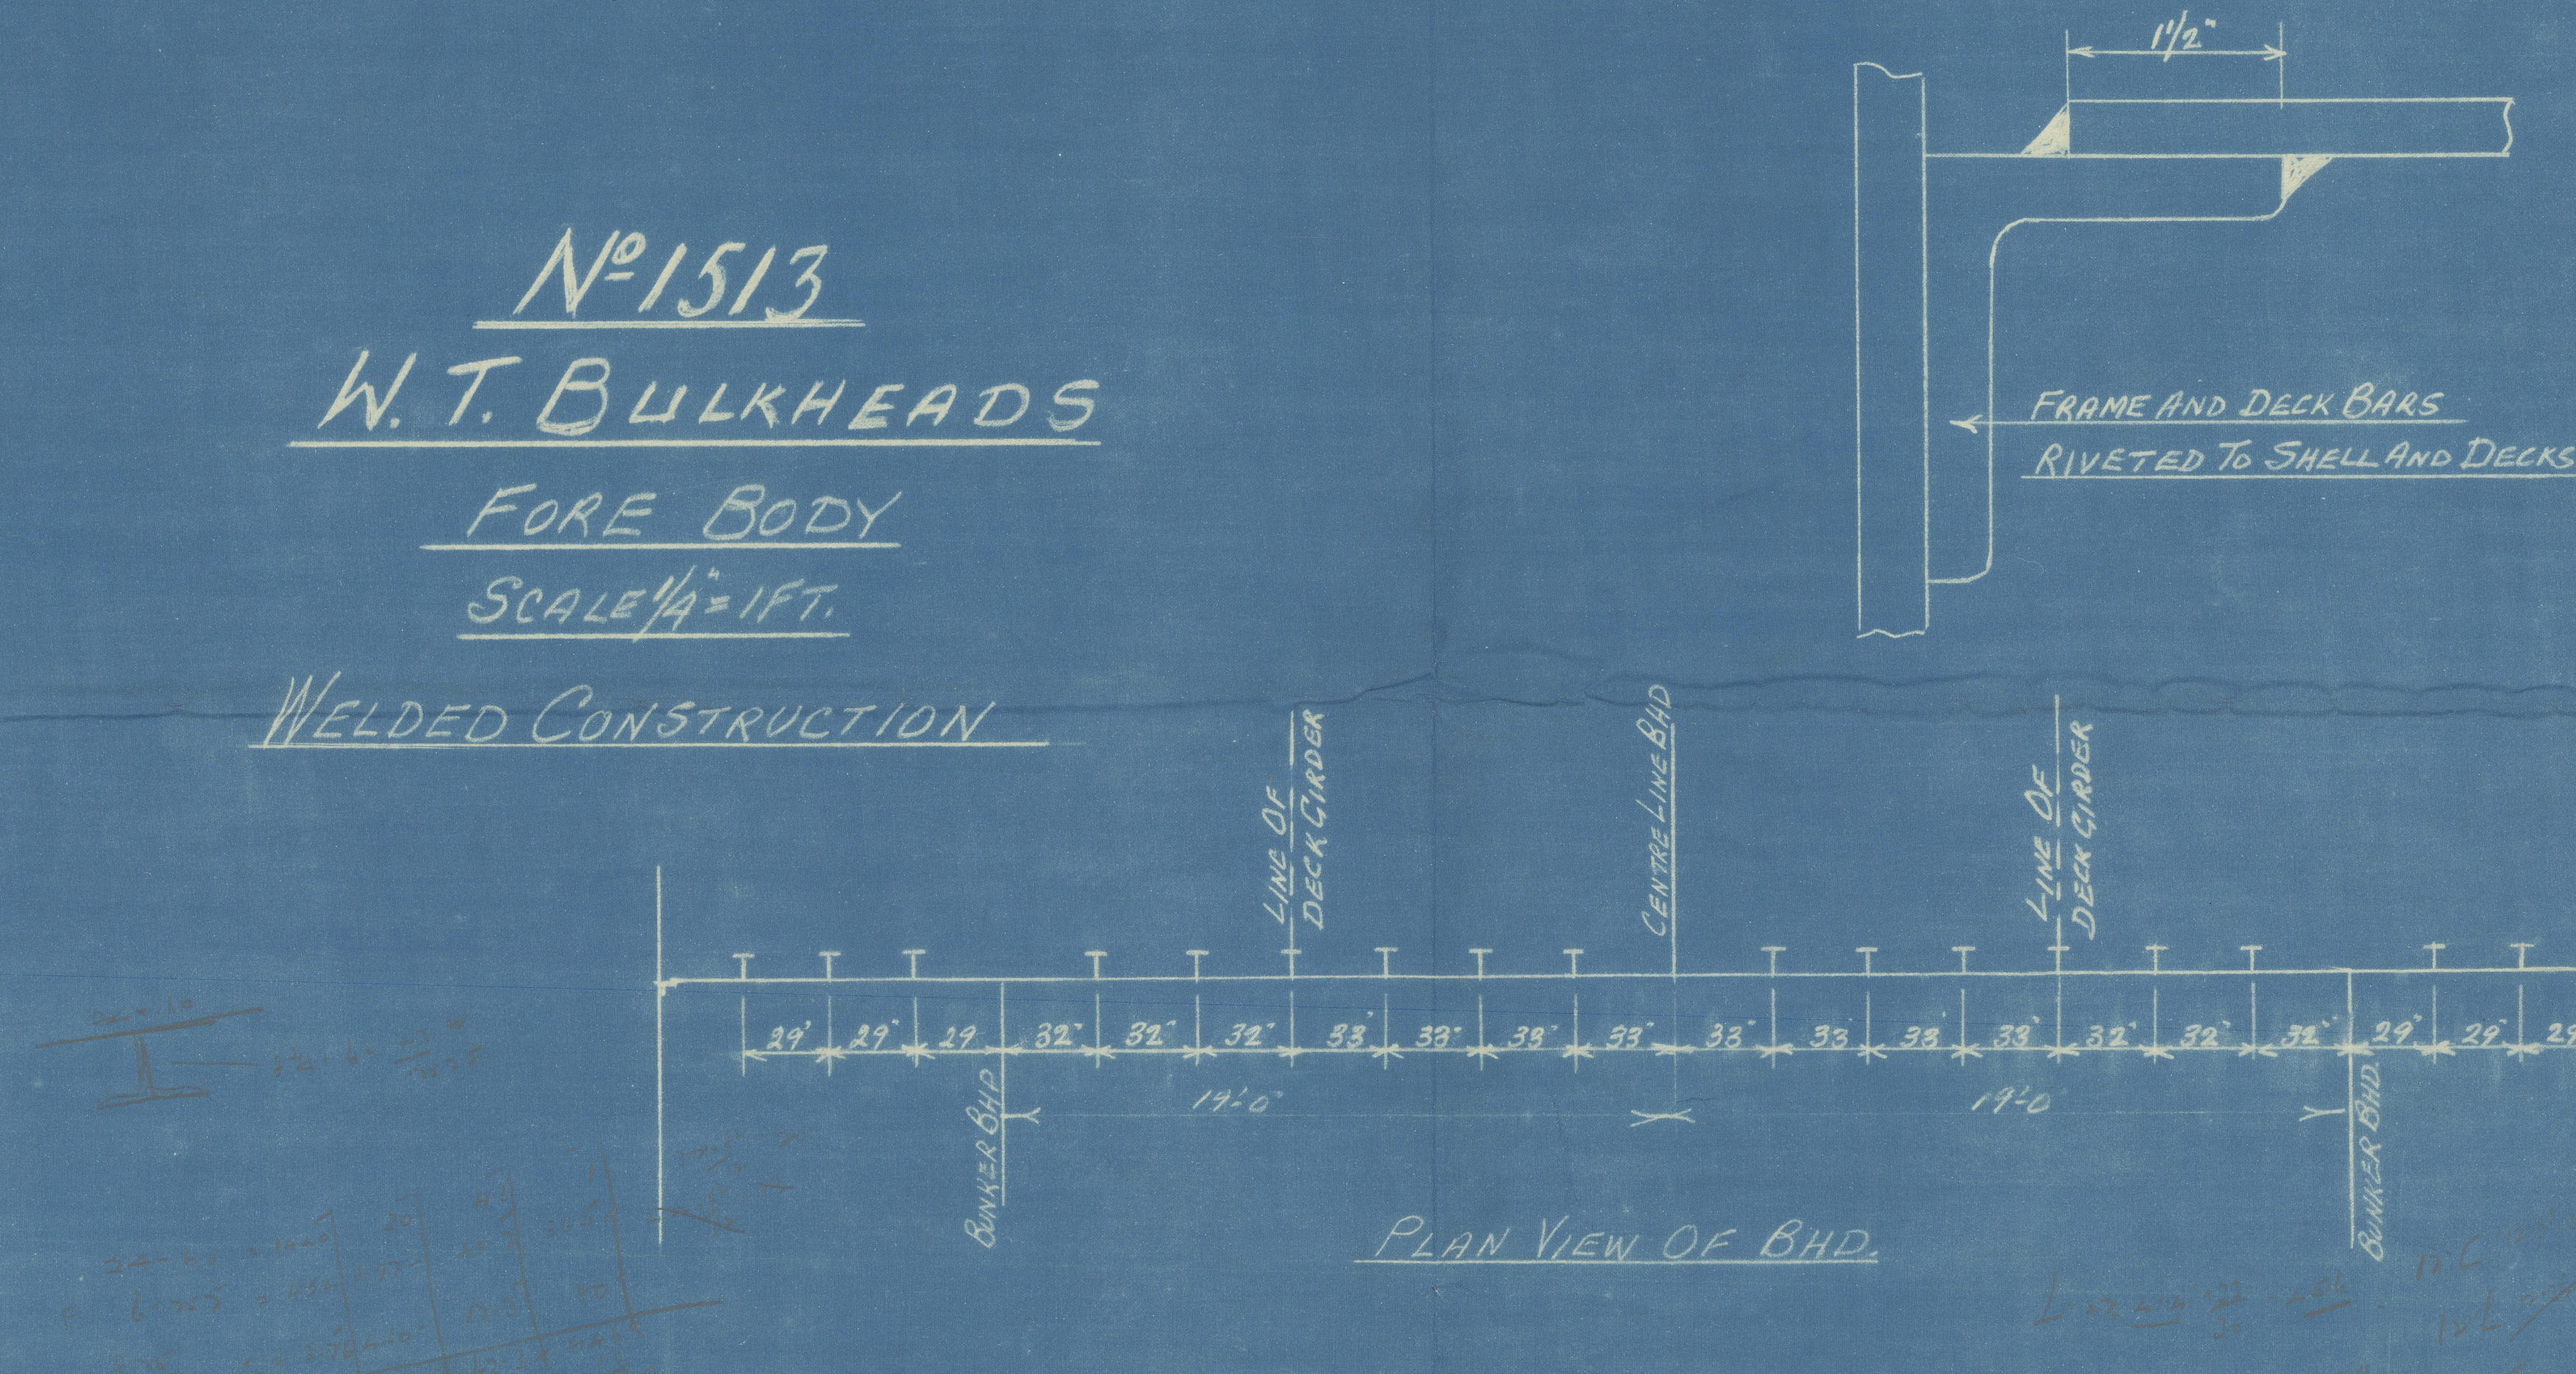

N^o 1513
W.T. BULKHEADS
FORE BODY
SCALE 1/4" = 1 FT.
WELDED CONSTRUCTION

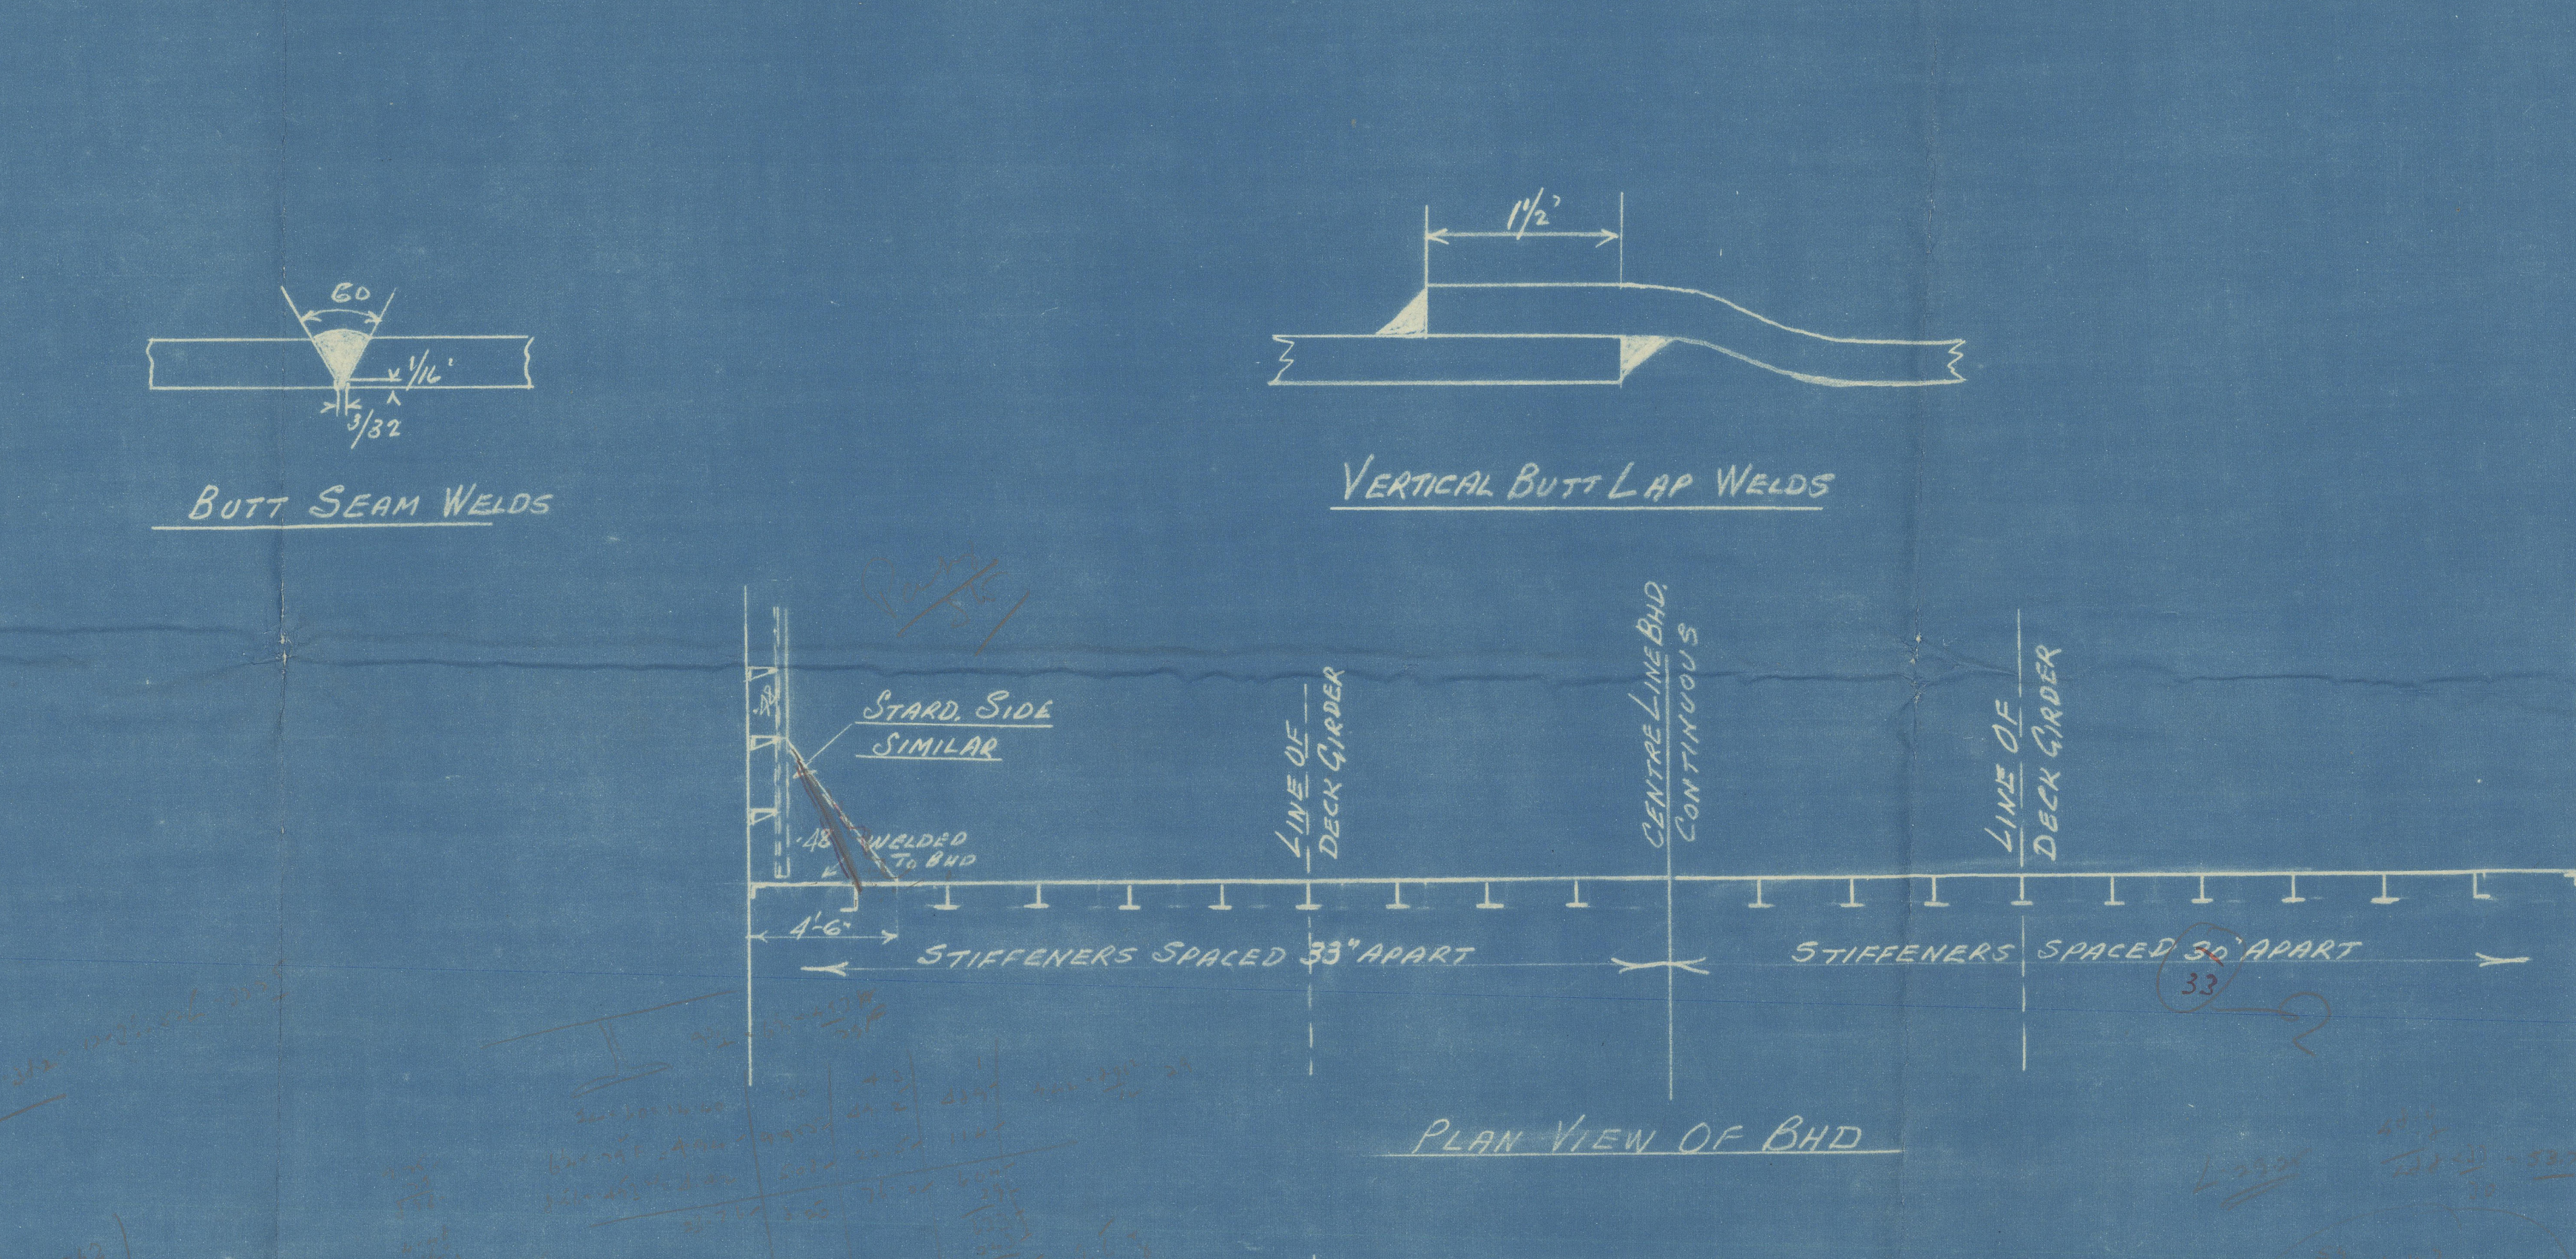

N^o 1513
W.T. BULKHEADS
FORE BODY
SCALE 1/4" = 1 FT.
WELDED CONSTRUCTION



Hooper

(31)

(9)

GEN BOX NO

~~70~~

SH & WR

1573

W.T. Bhd

After body



© 2020

Lloyd's Register
Foundation