
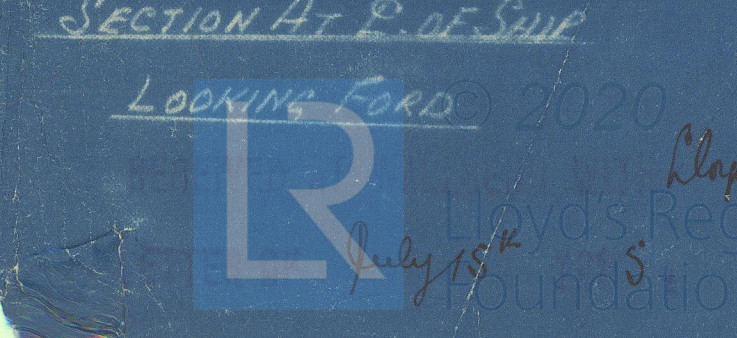
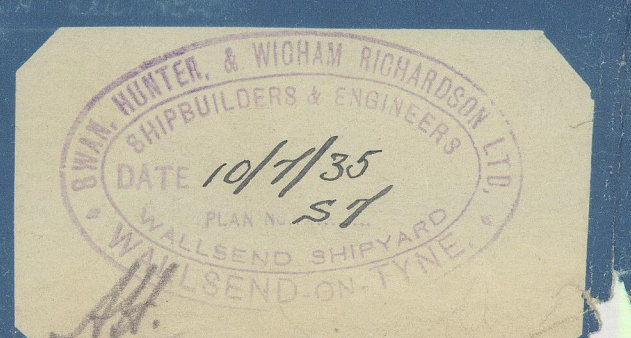
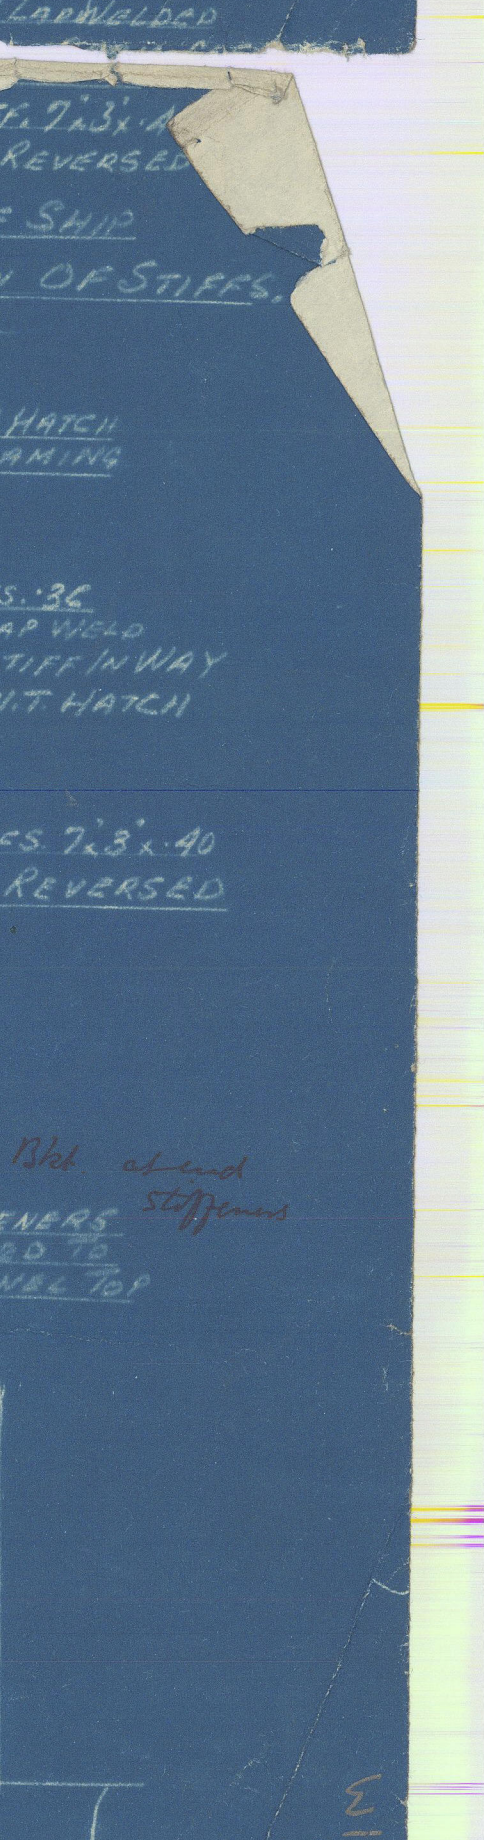
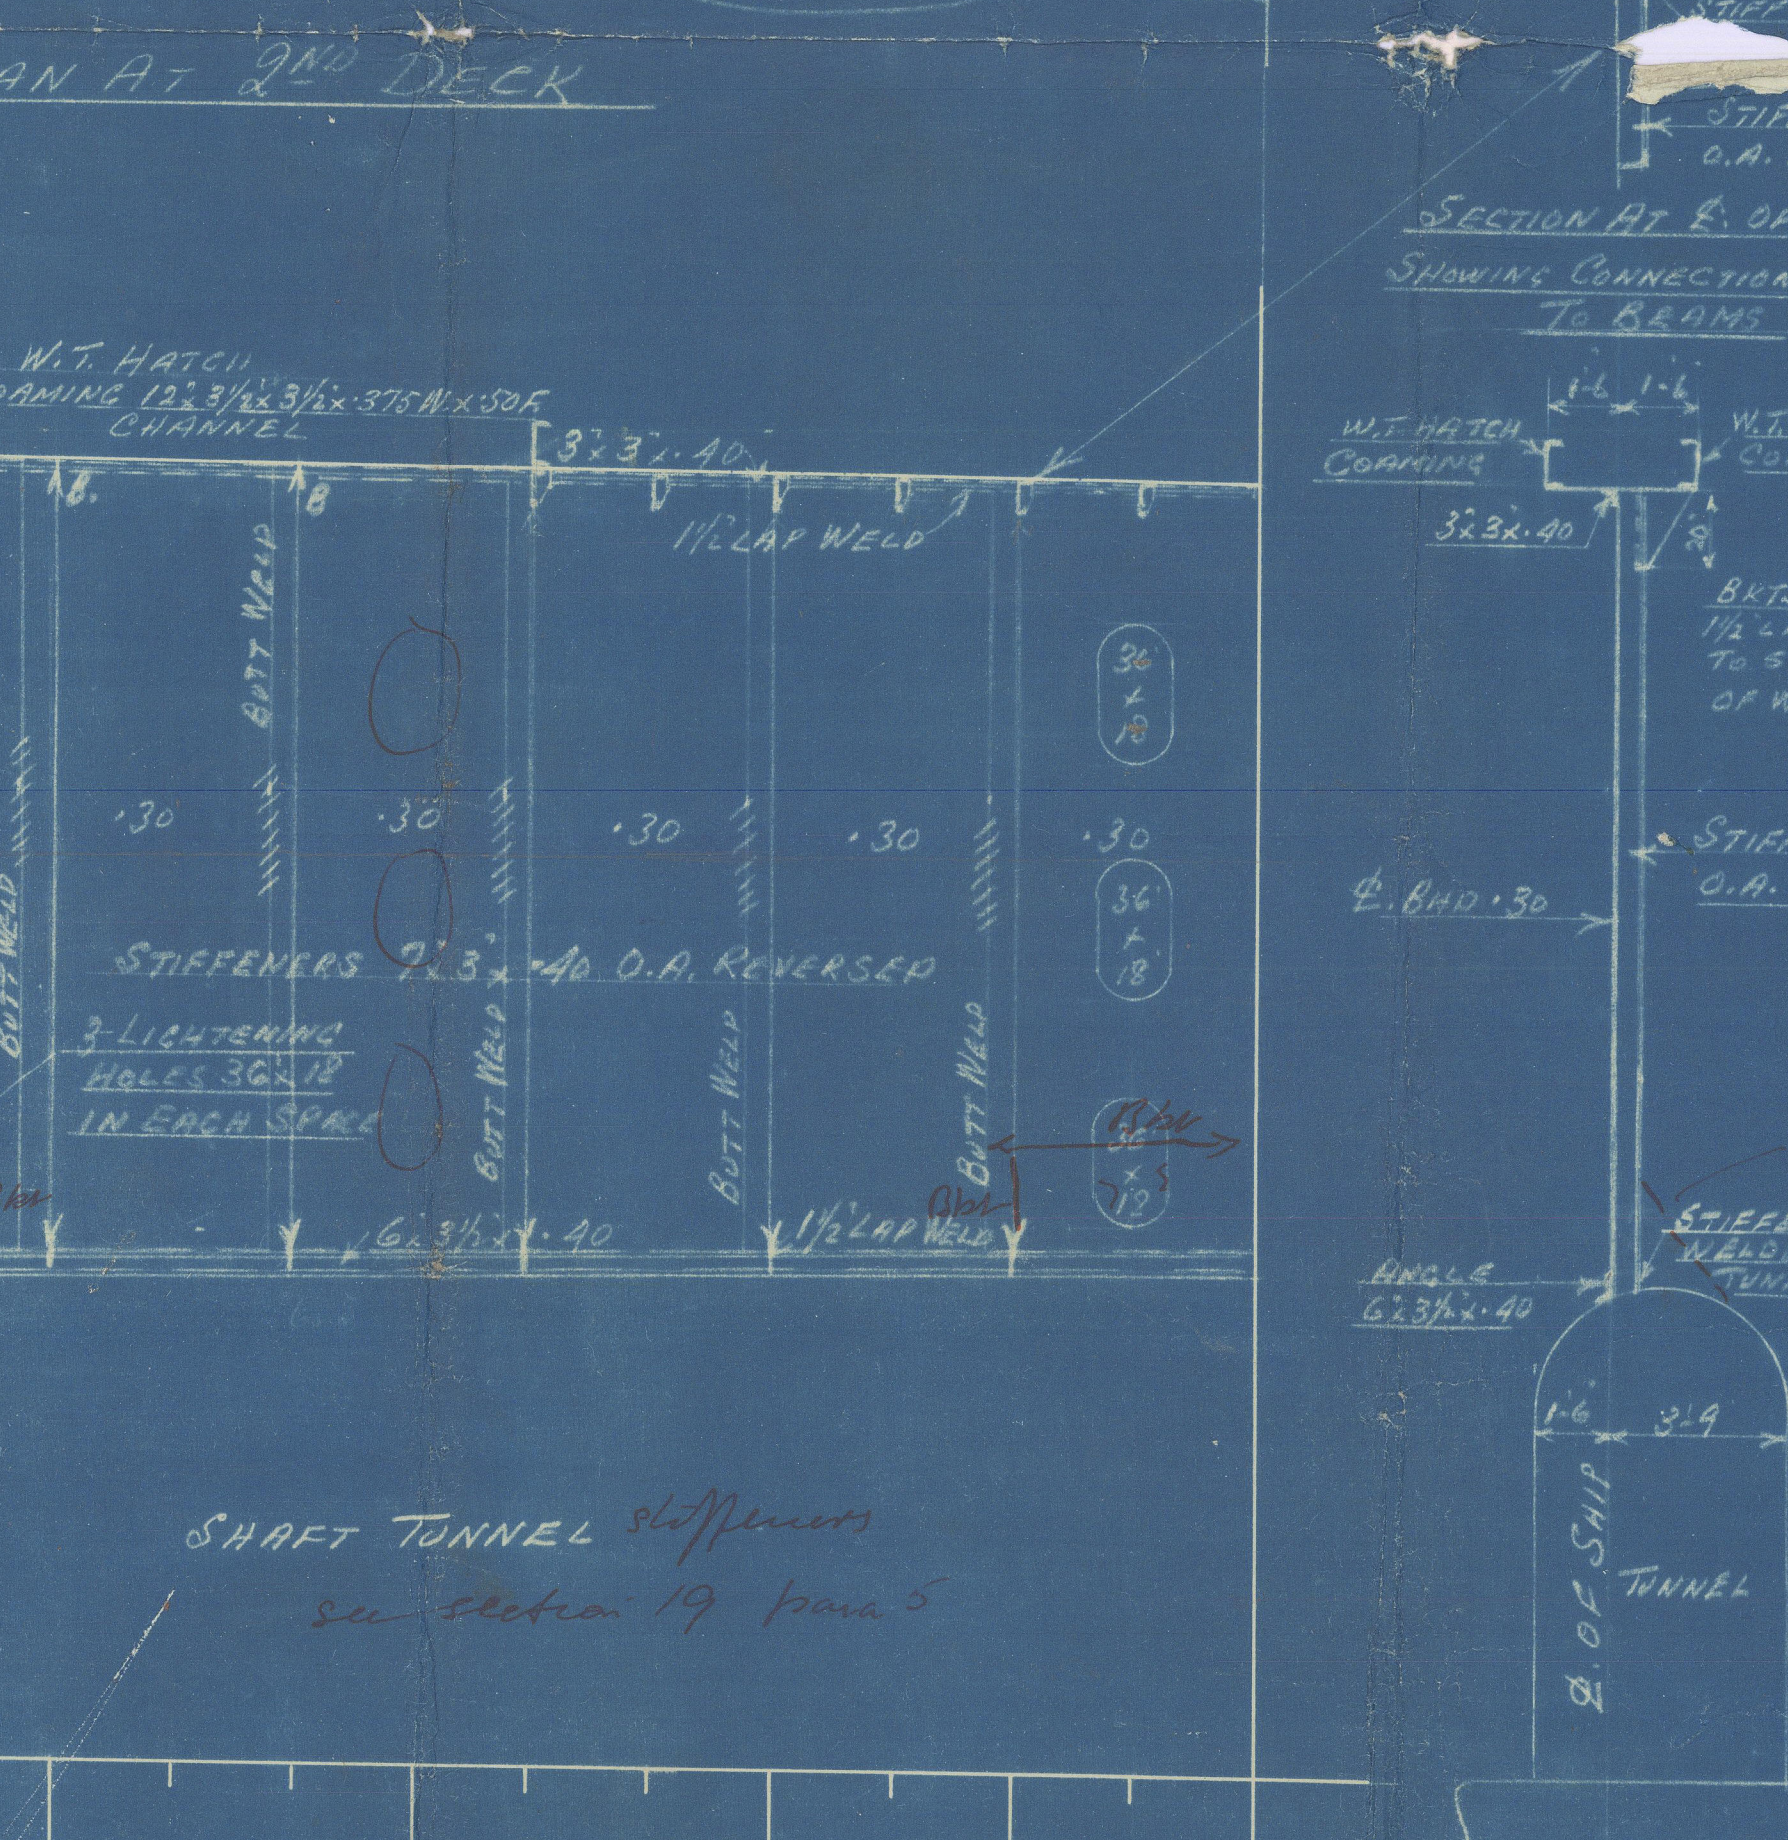
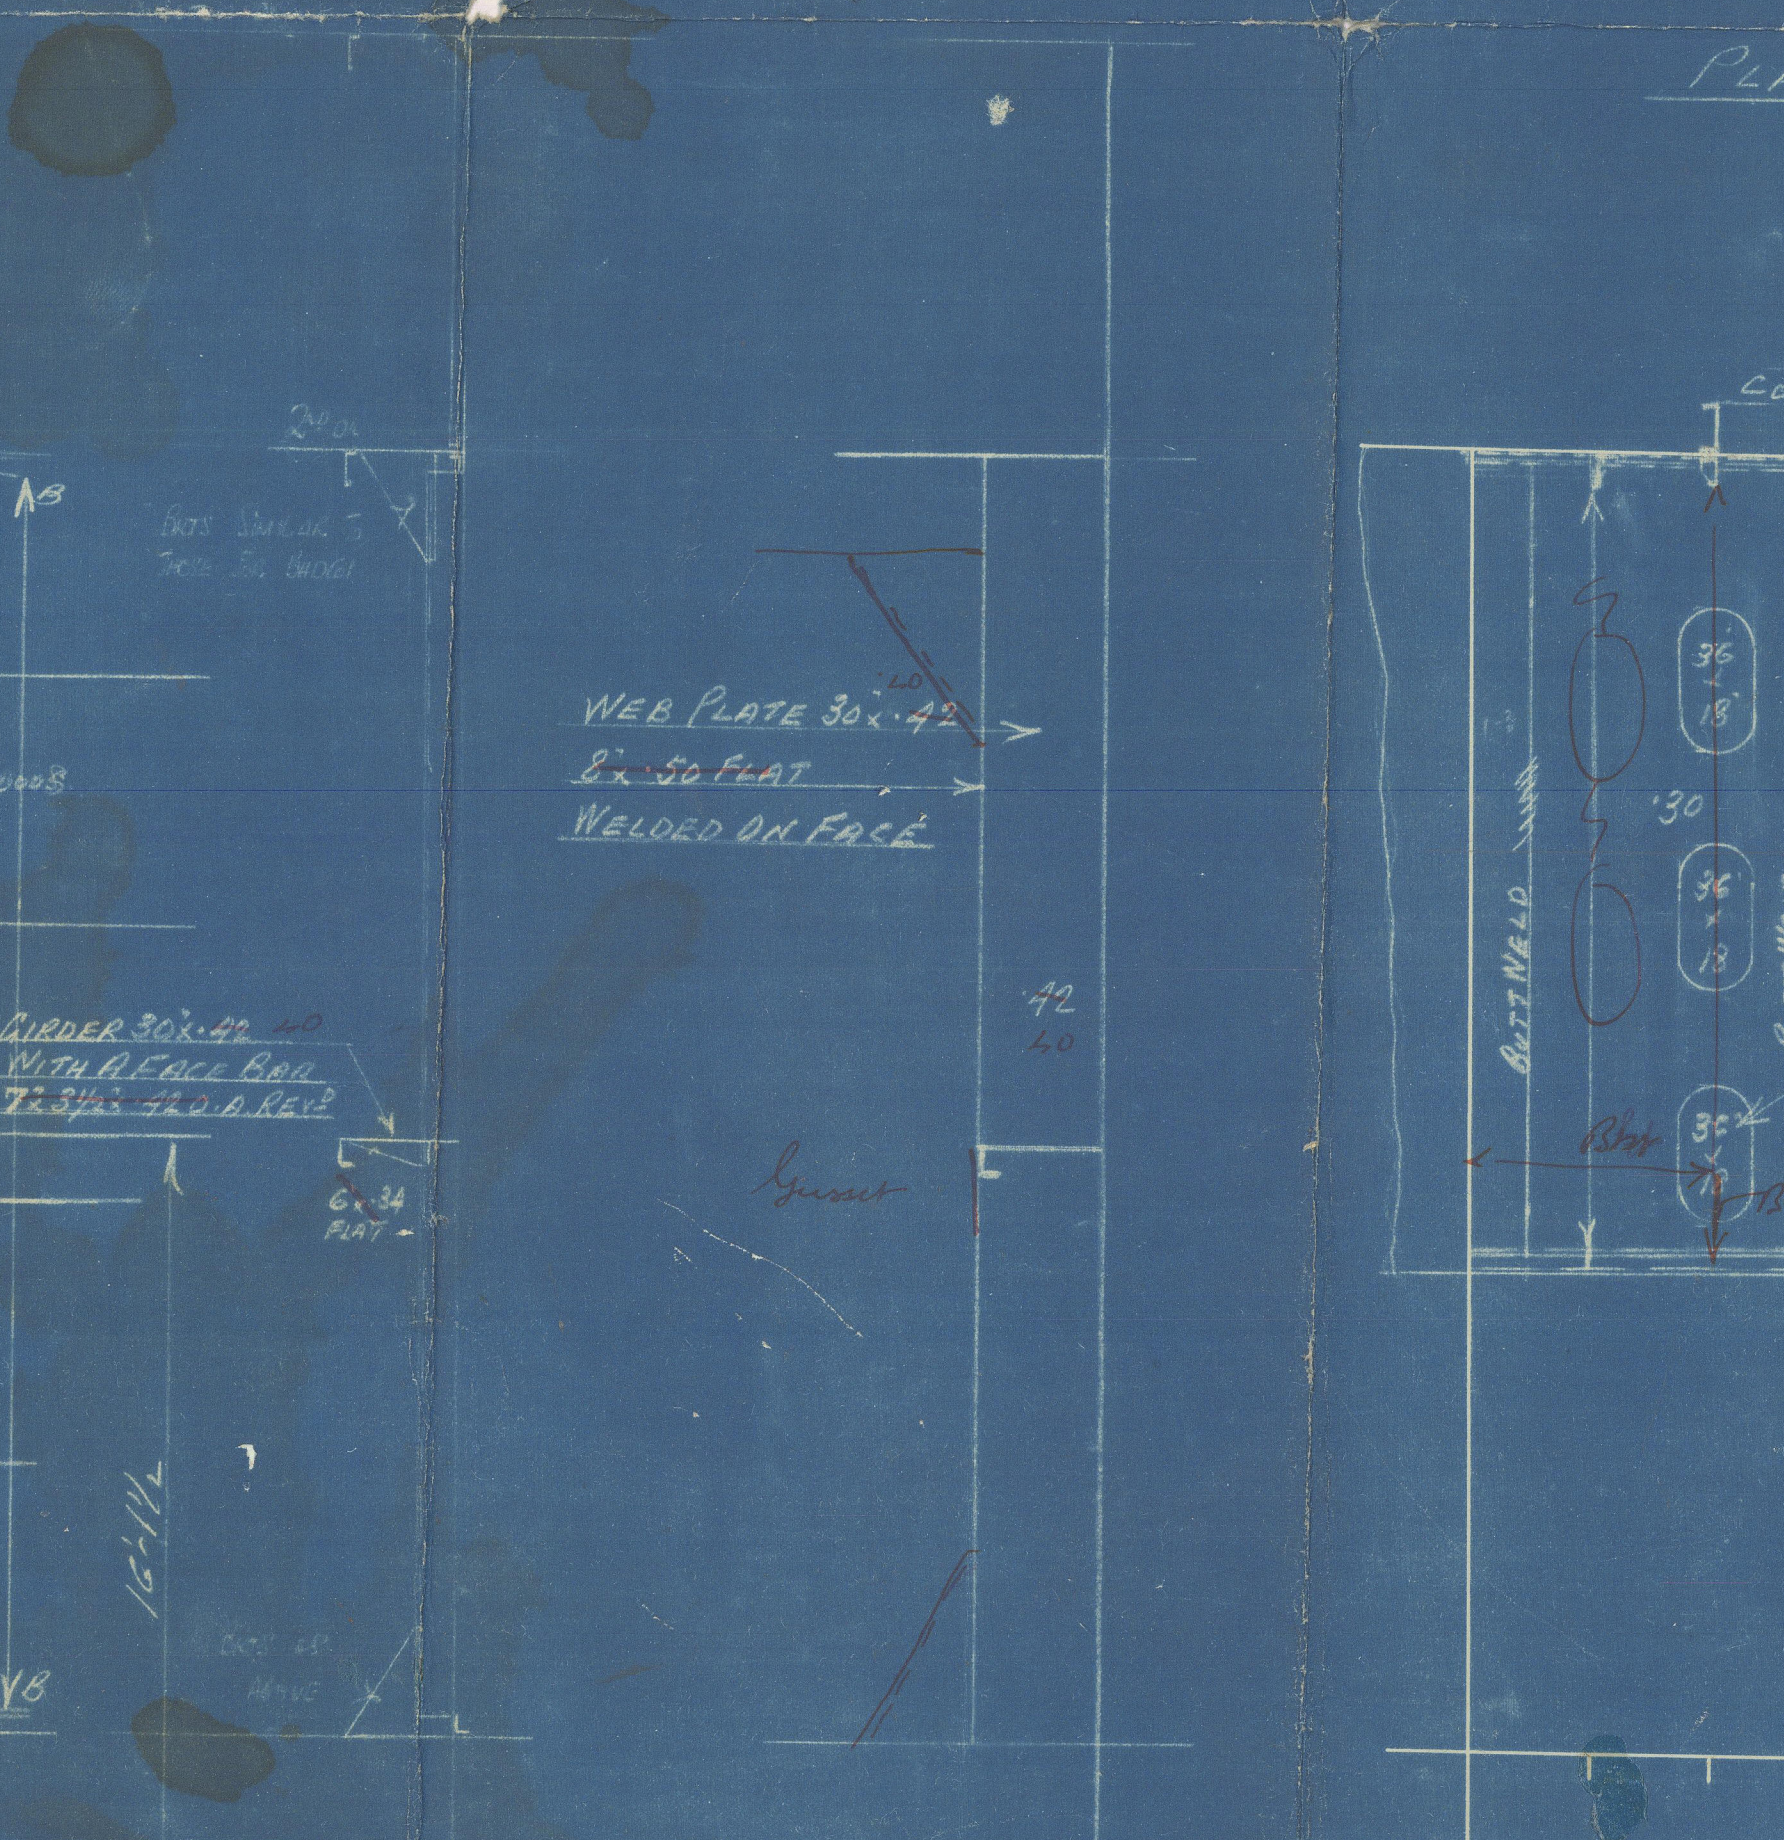
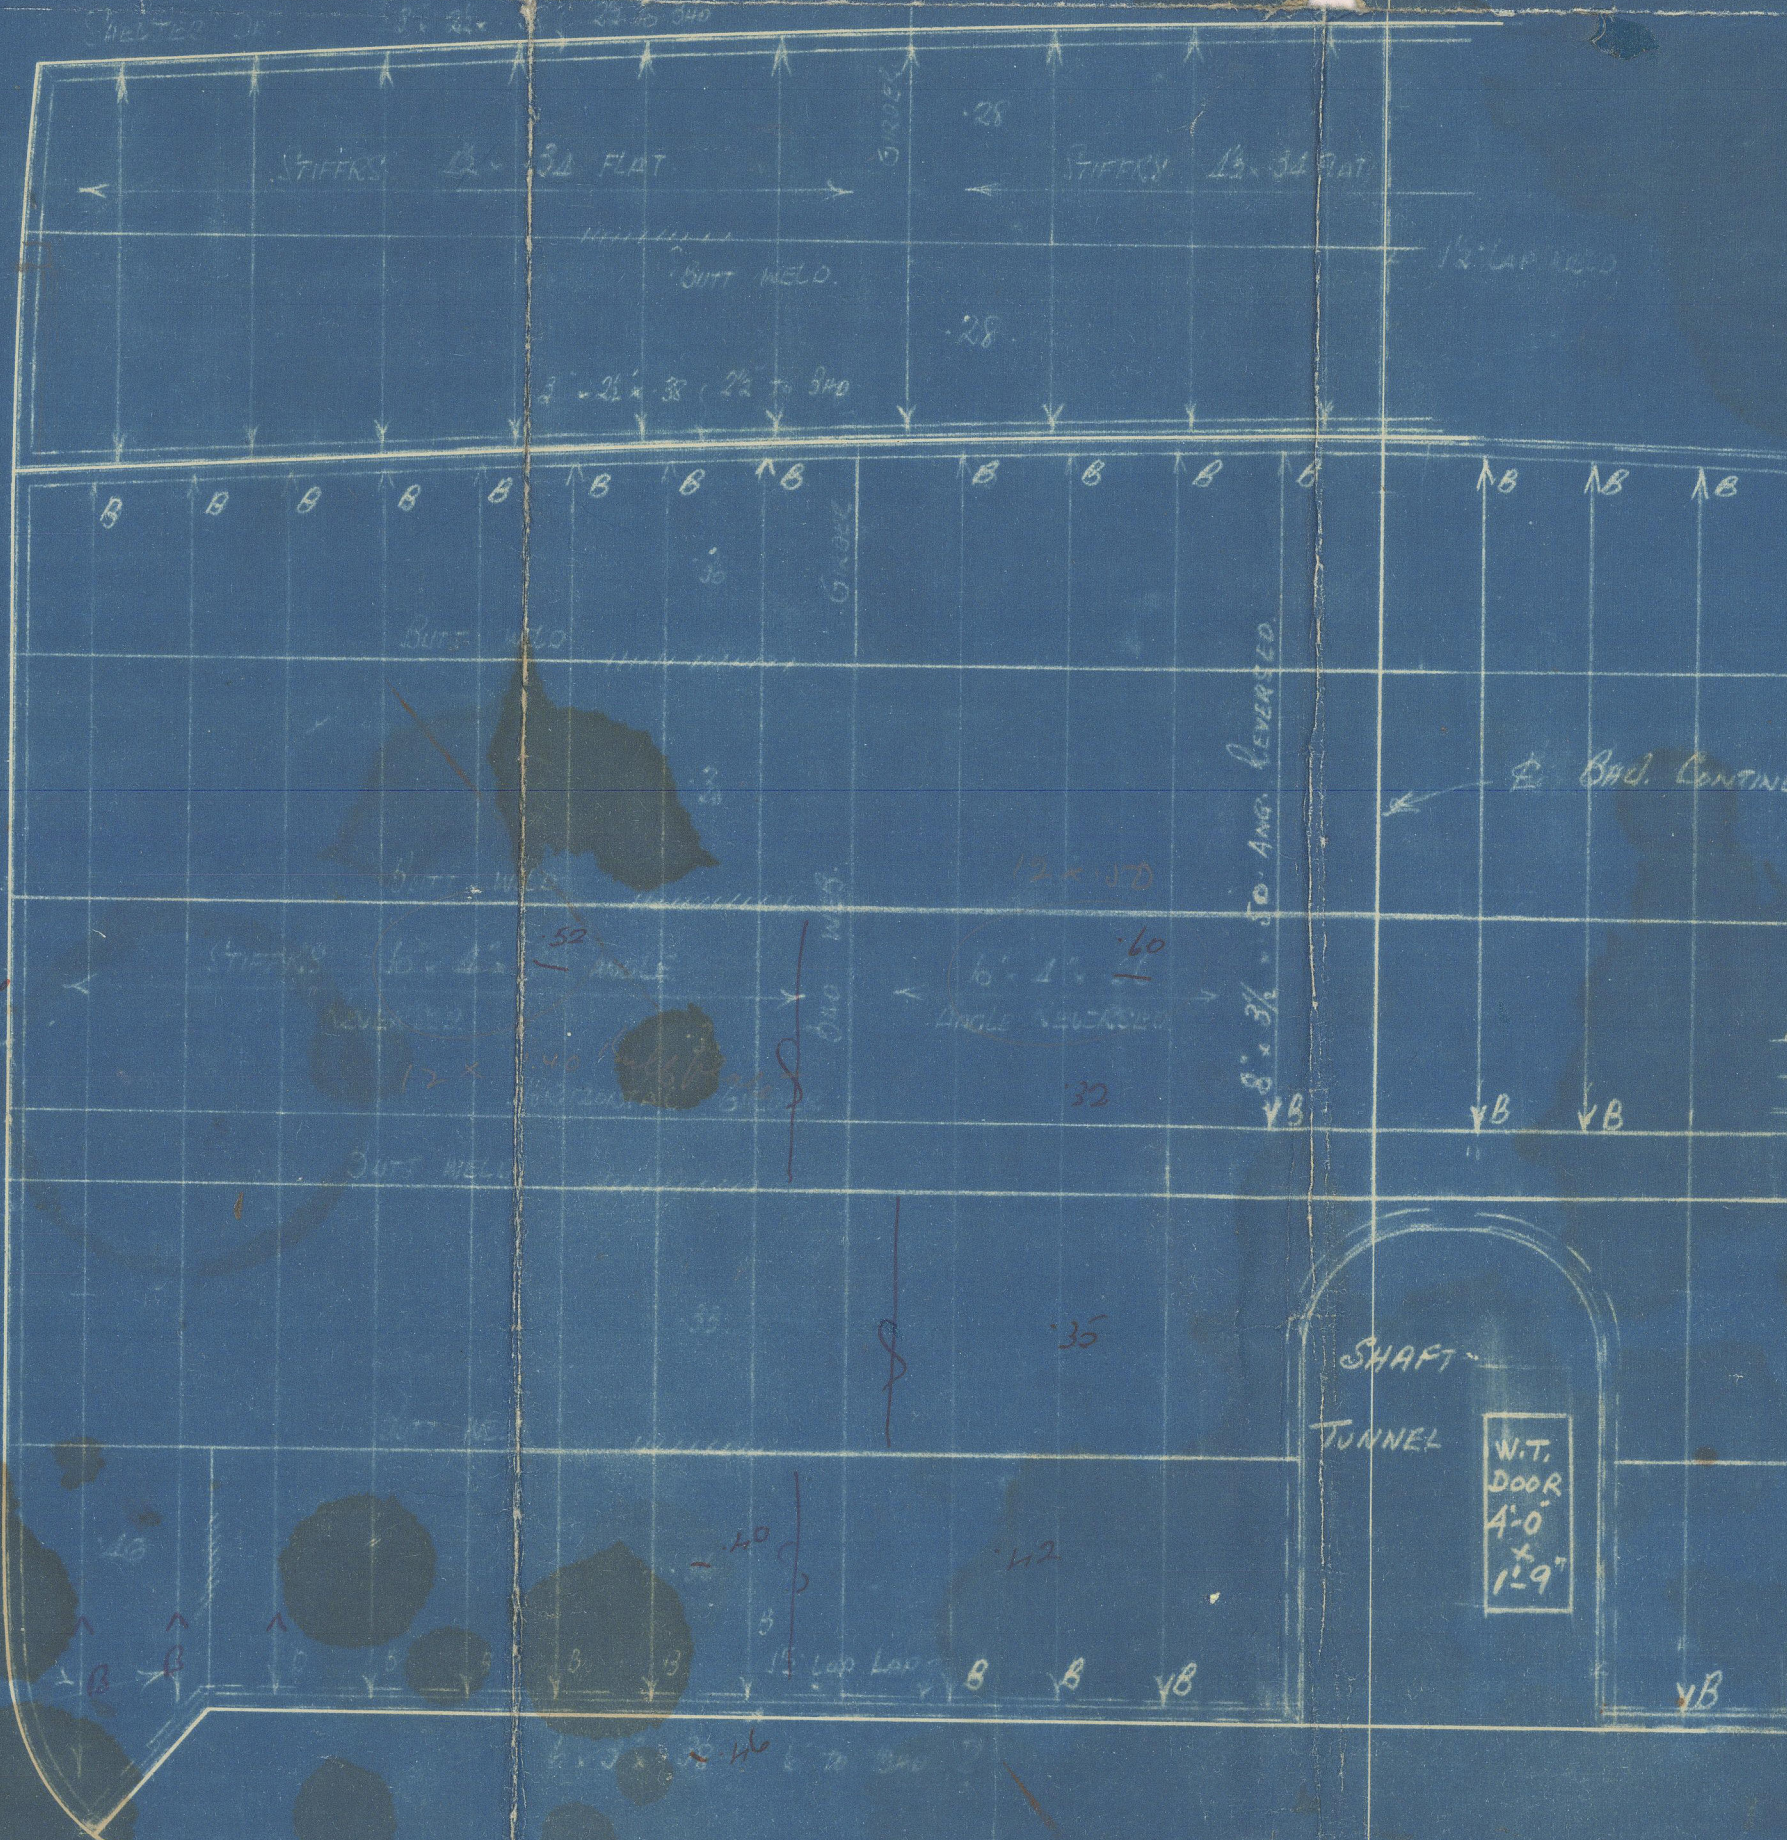
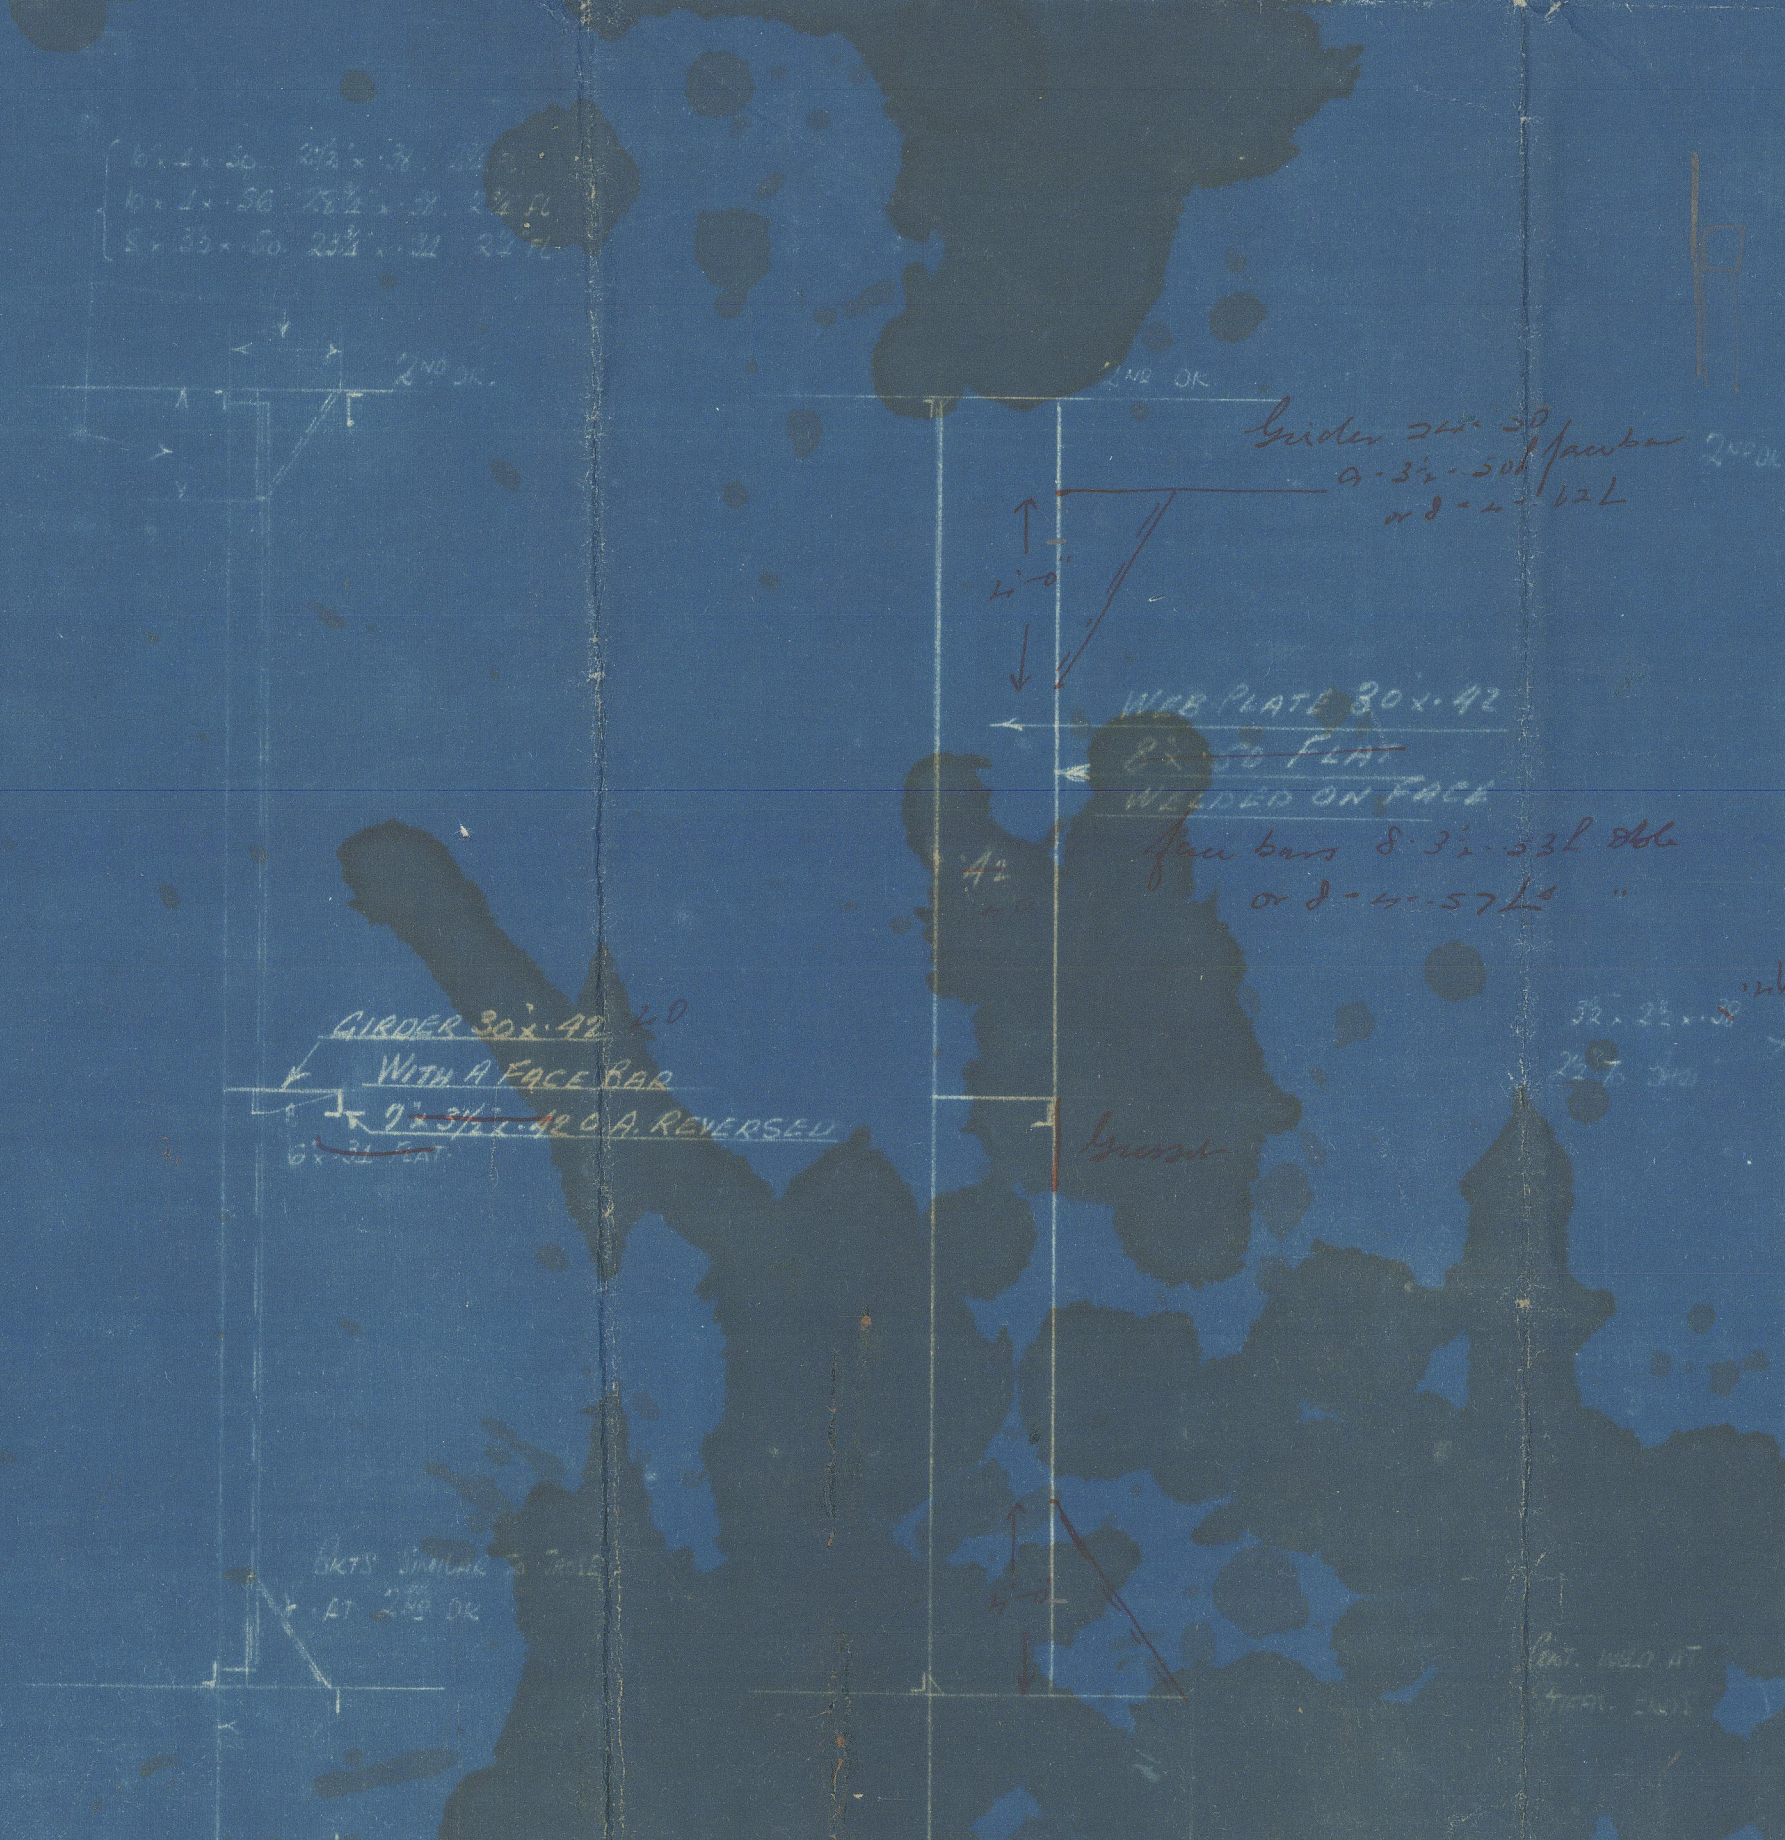
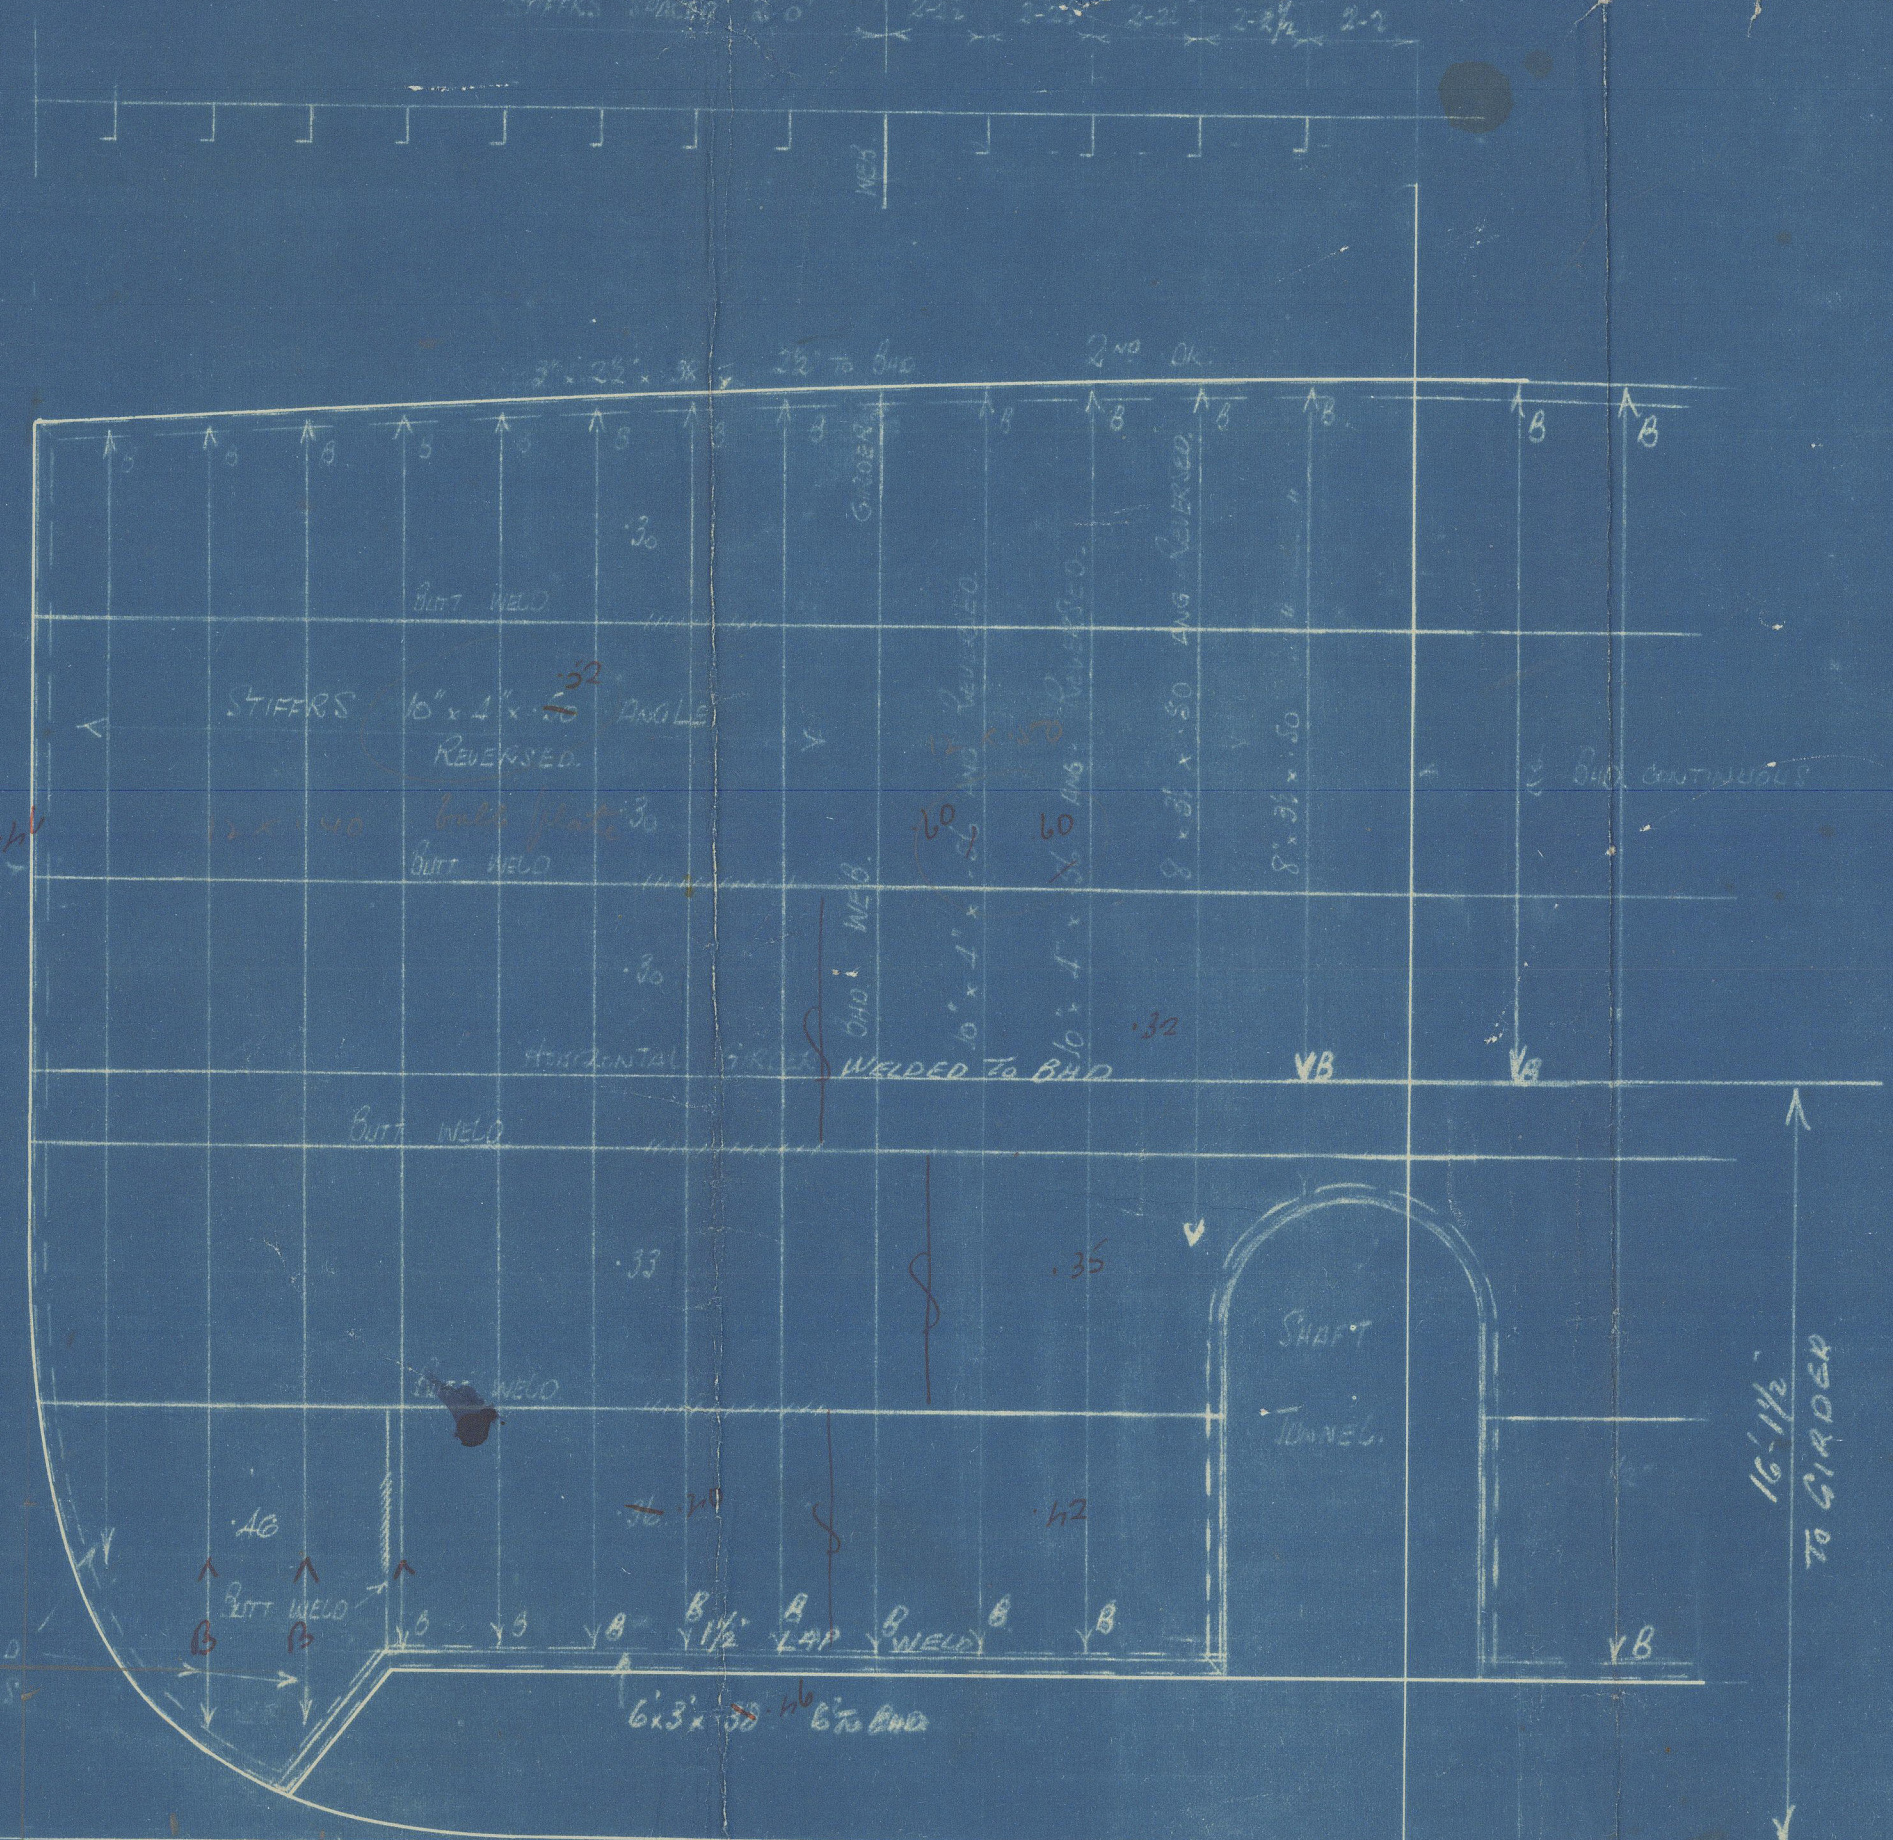
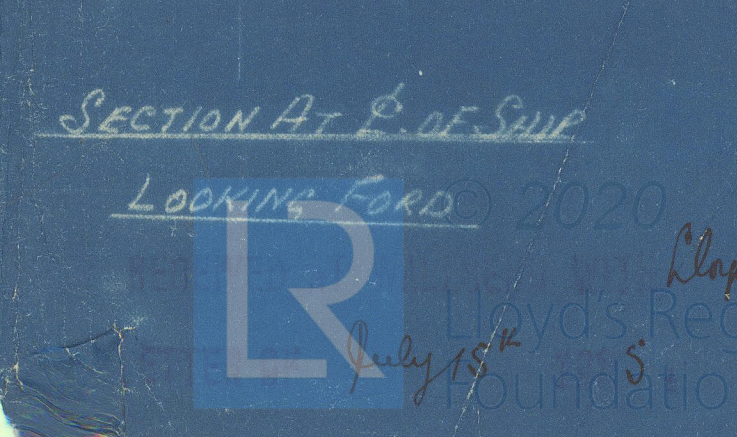
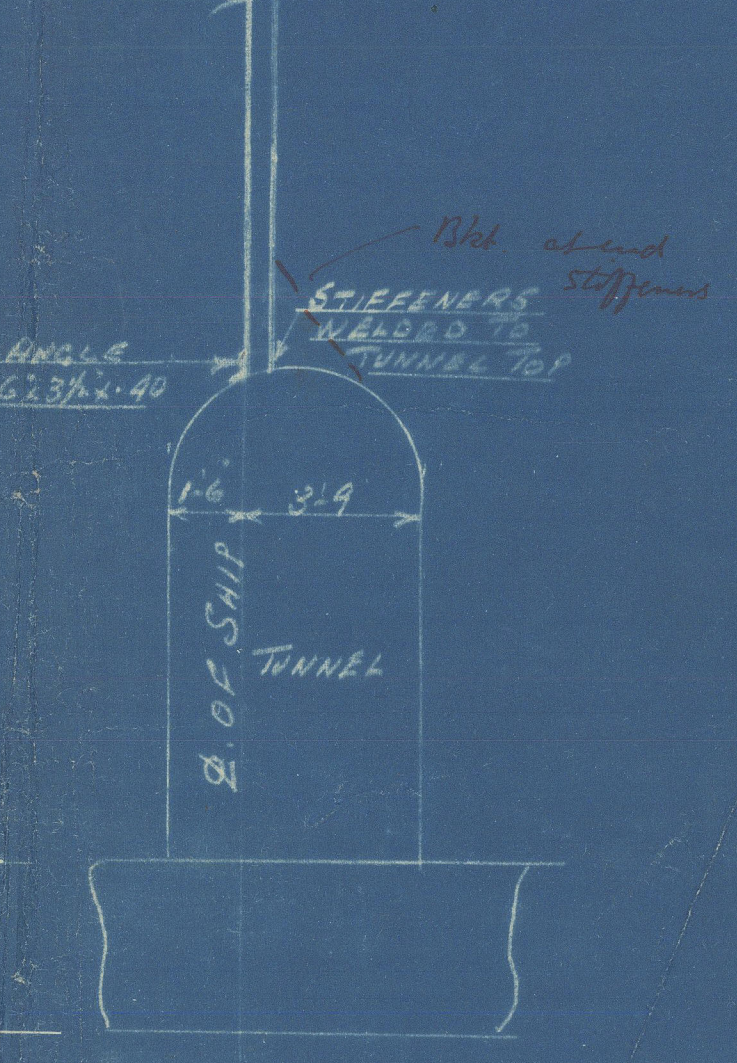
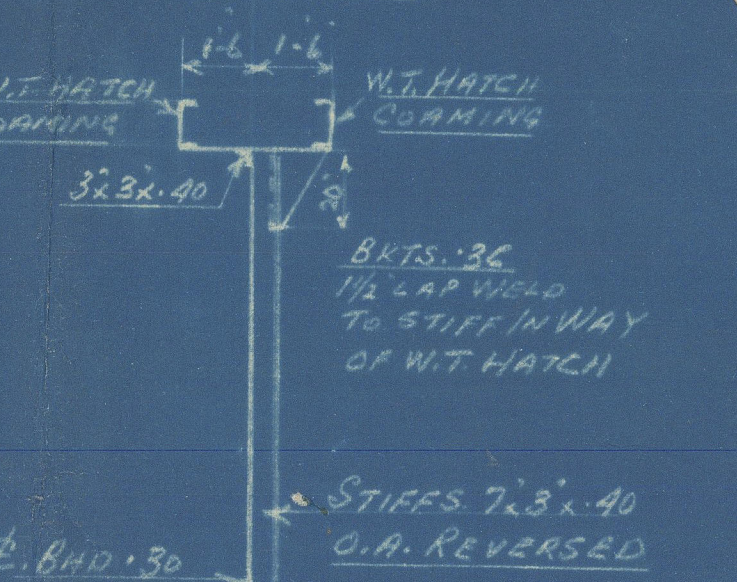
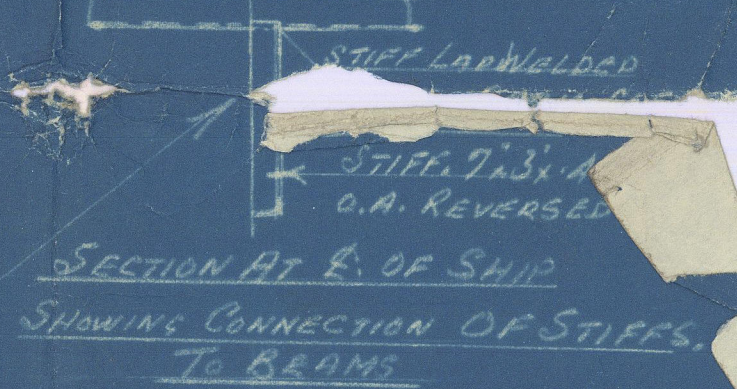


15-7-35

N^o 1513

PLAN OF DEEP TANK

SCALE 1/4" = 1 FT.

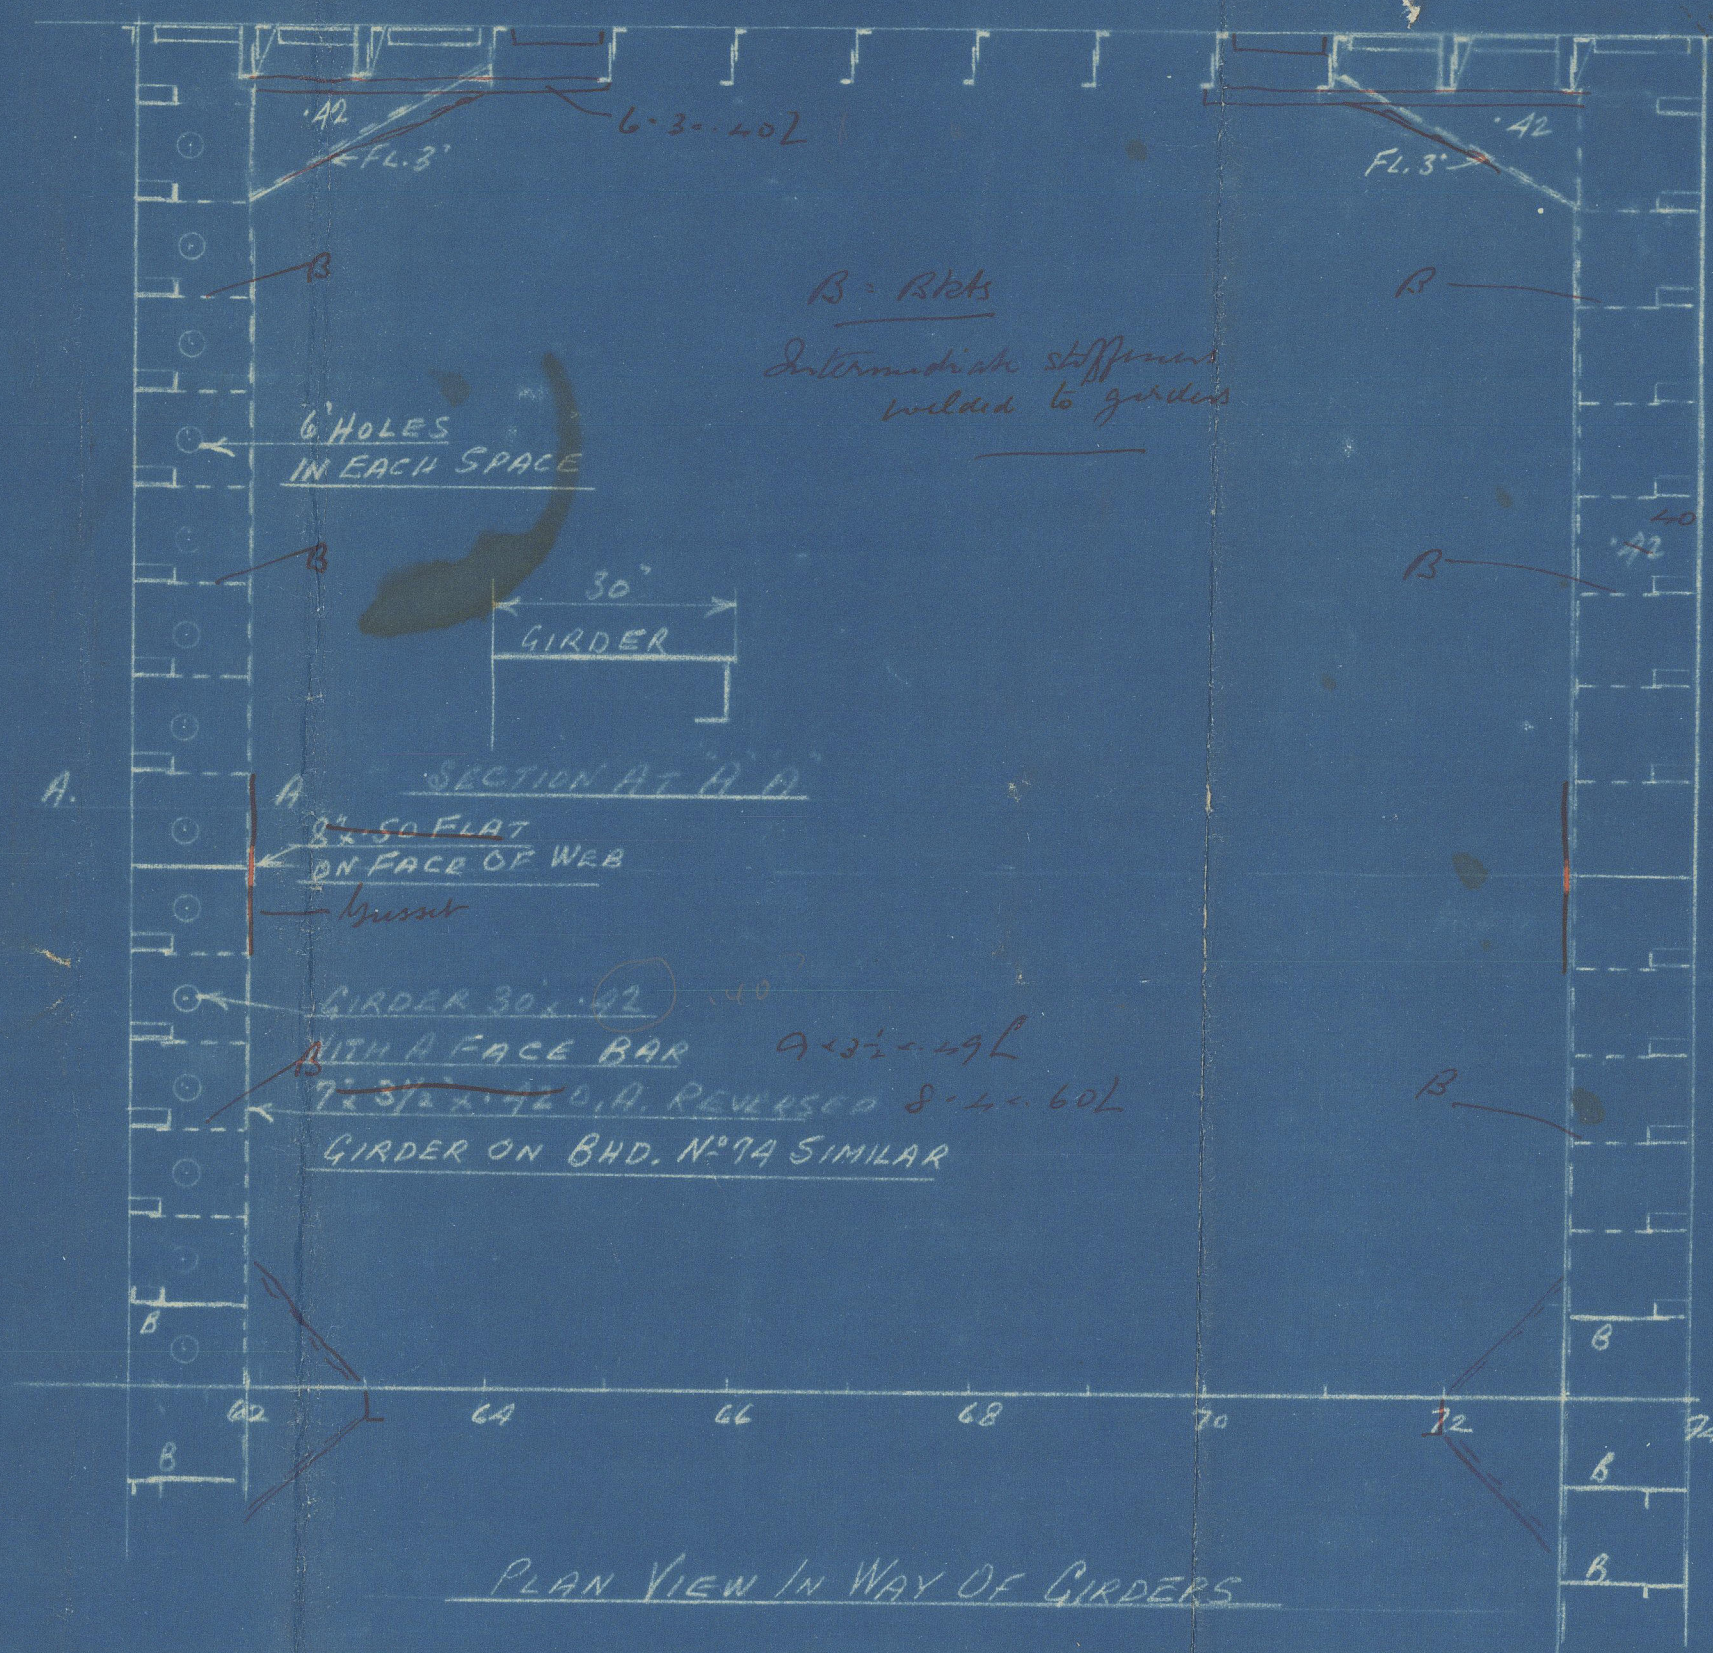

Swan (9) Ew.
Hunters No 1513

Deep Tank.


See also plan No 27



SS "HOPESTAR"

NEWCASTLE ON TYNE.

Report No. 93528

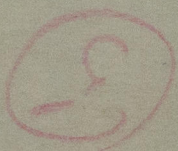

© 2020

W1014-0183

Foundation