

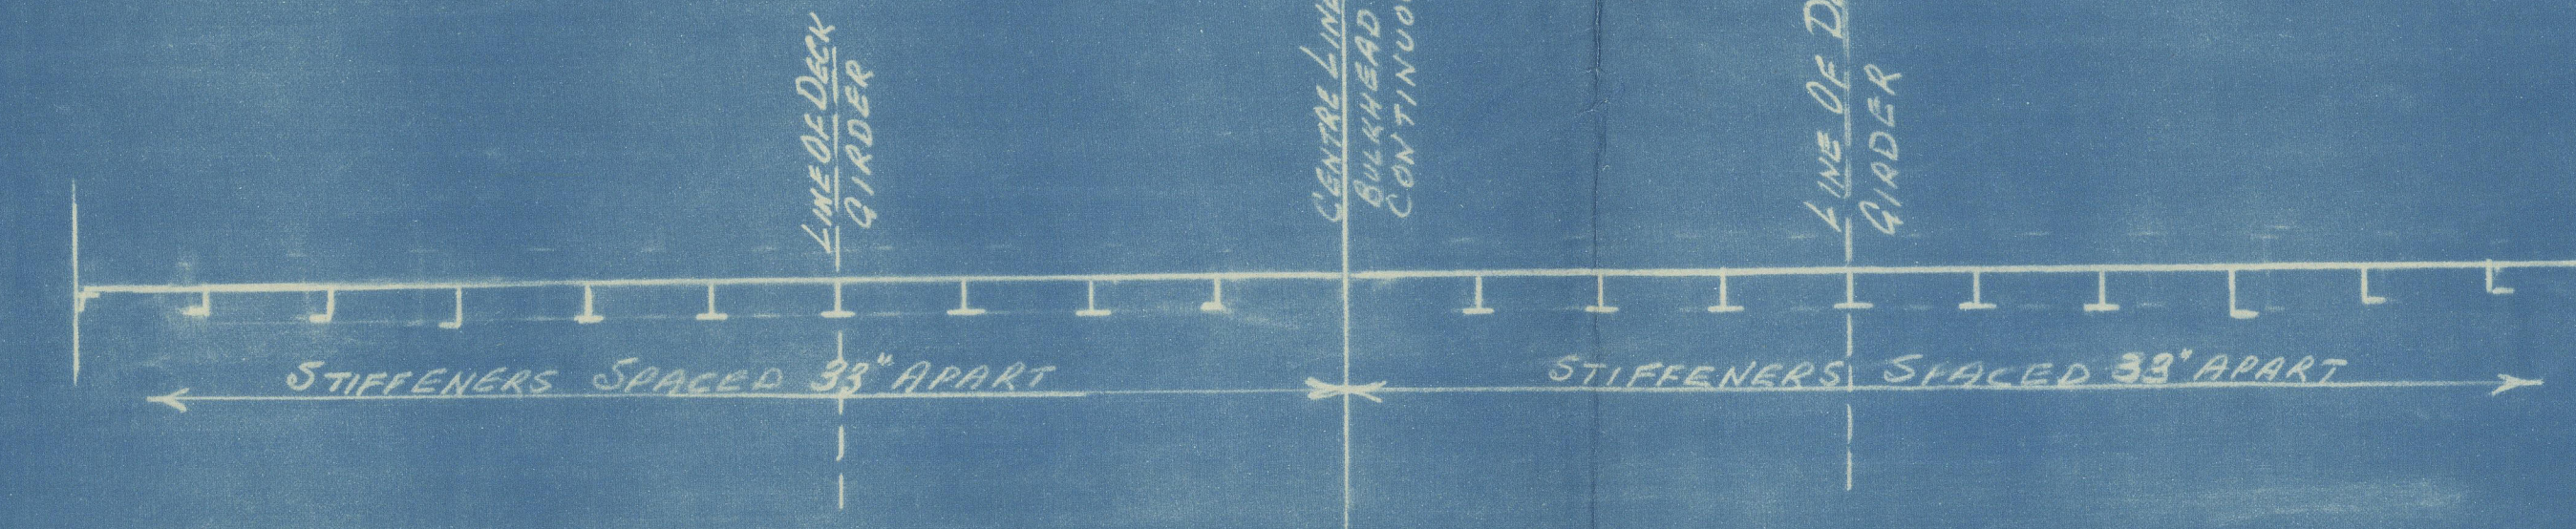
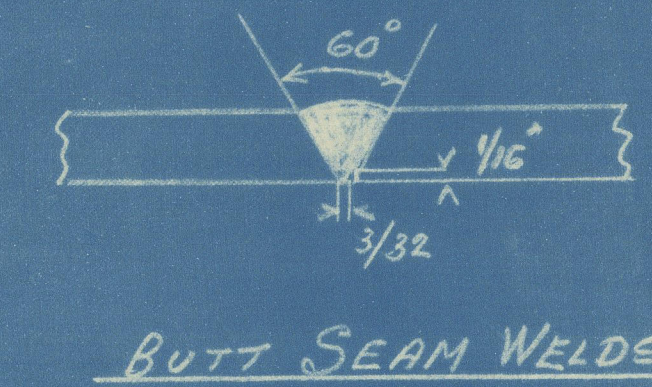


15735


N^o 1513
W.T. BULKHEAD
AFTER BODY
SCALE 1/4" = 1 FT.
WELDED CONSTRUCTION

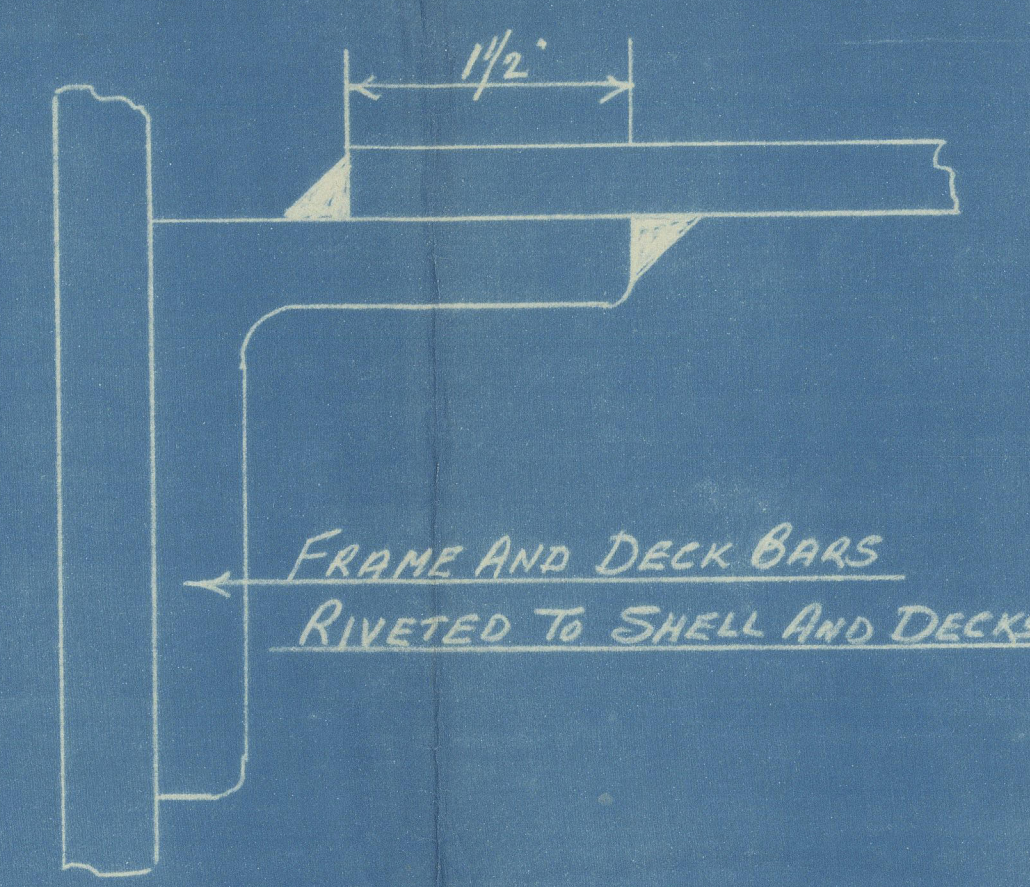

PLAN VIEW OF BHD

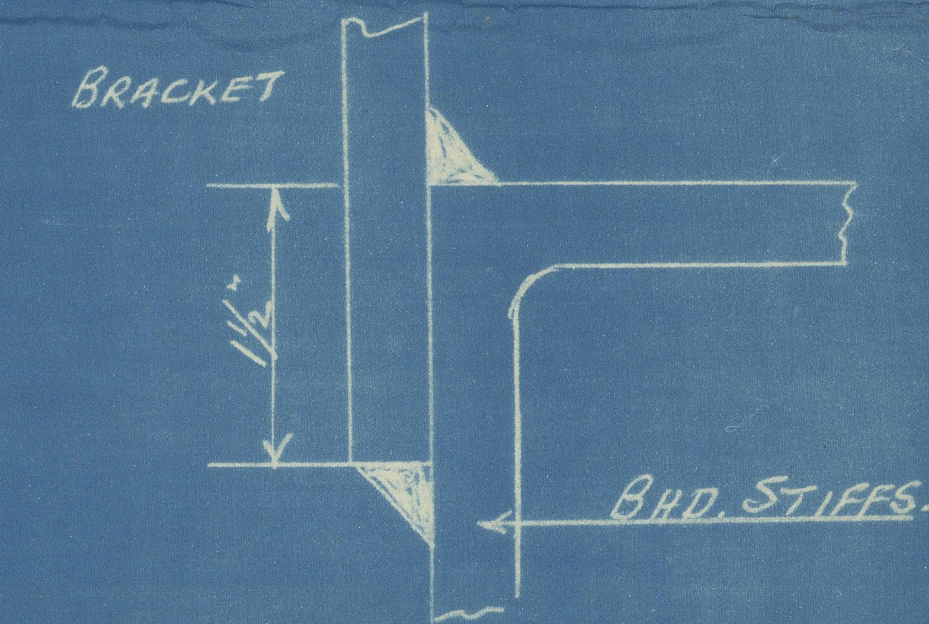





BHD STIFFENER BRACKET CONNECTIONS
WHERE ANGLE STIFFENERS

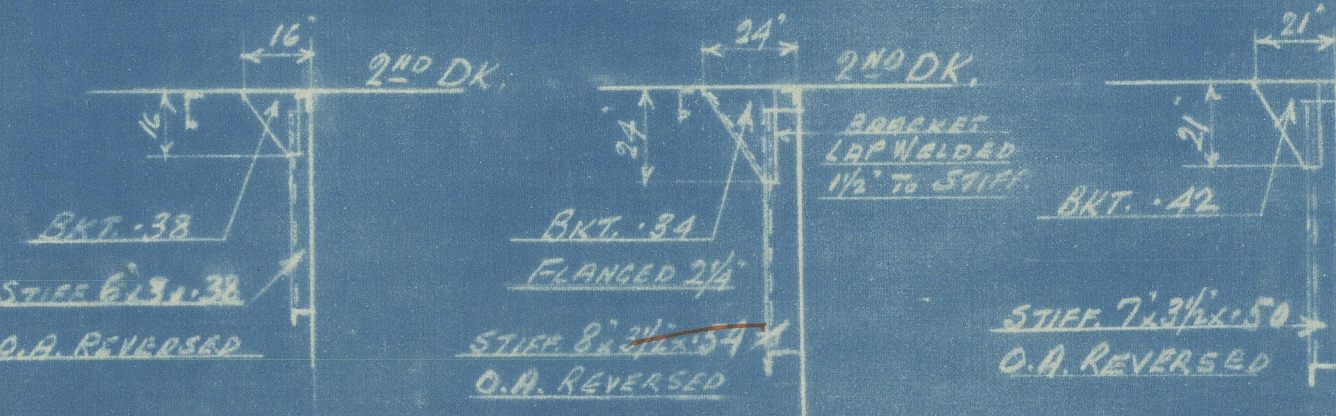


W.T. BULKHEAD N^o 39
LOOKING AFT

ELEVATION OF BHD.
STIFFENER CONNECTION


N^o 1513
W.T. BULKHEADS
FORE BODY
SCALE 1/4" = 1 FT.
WELDED CONSTRUCTION

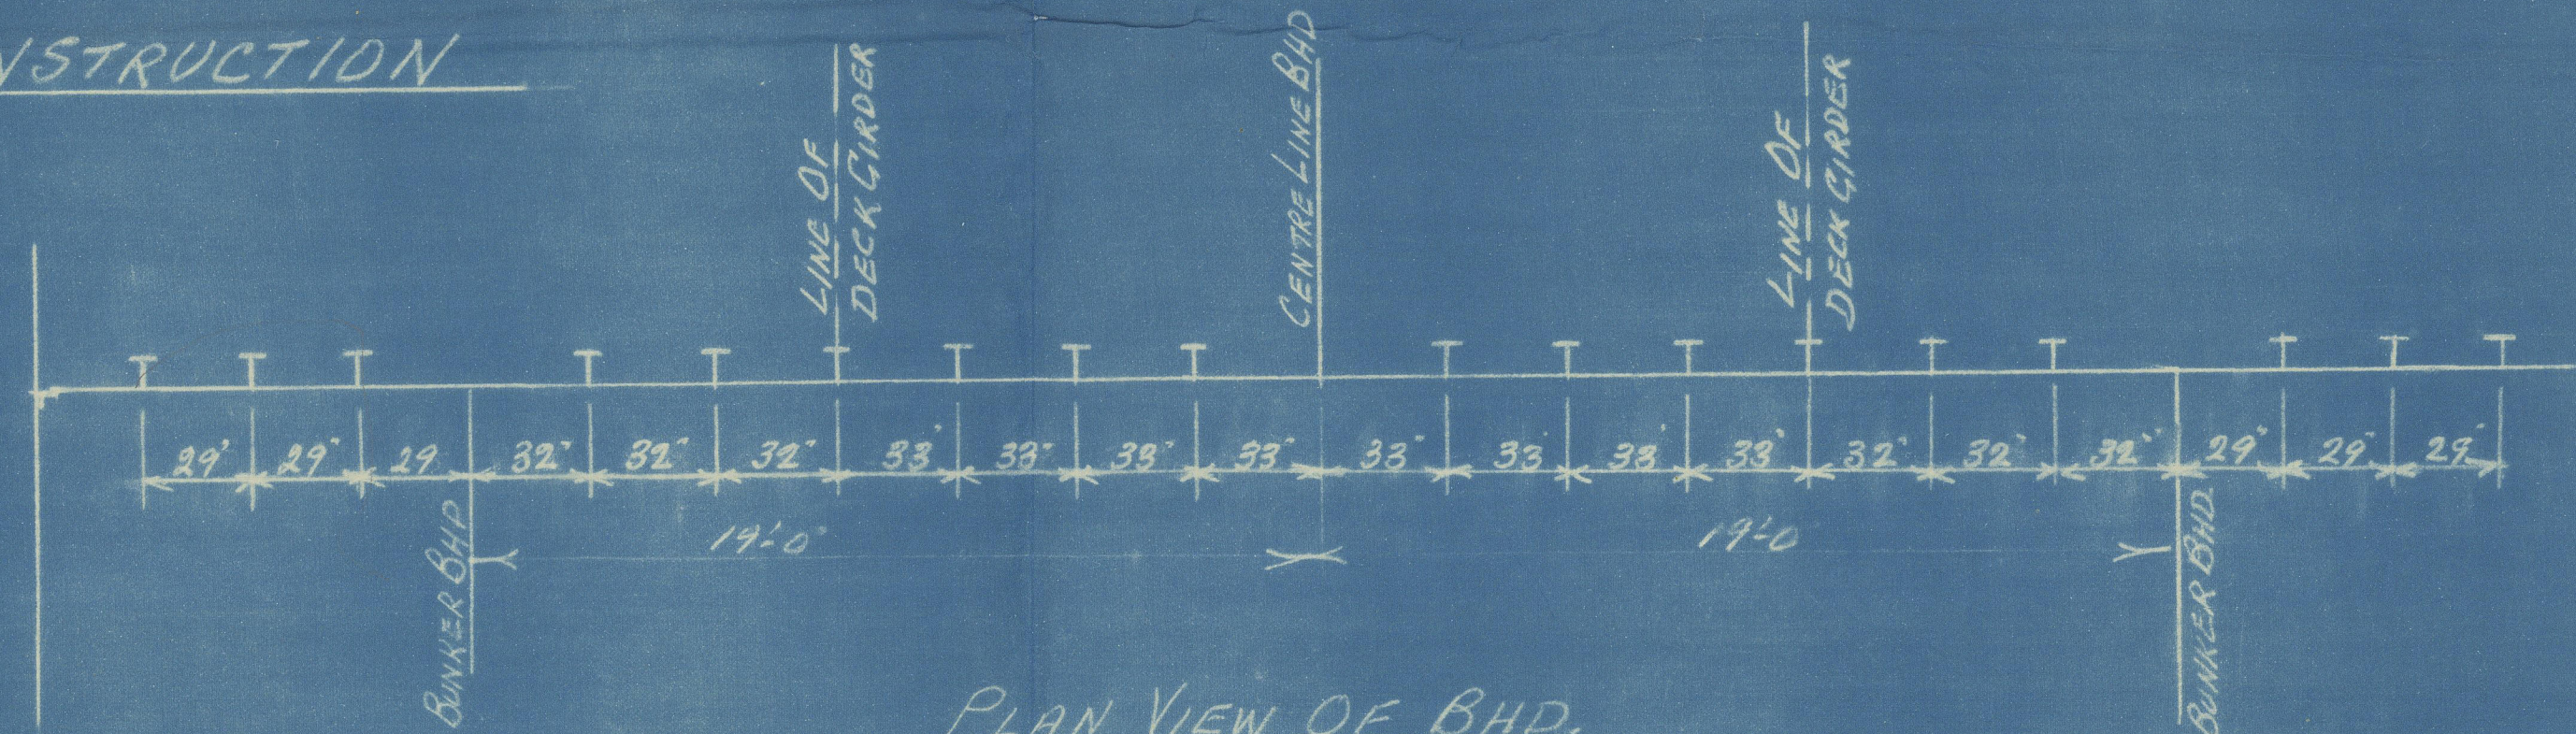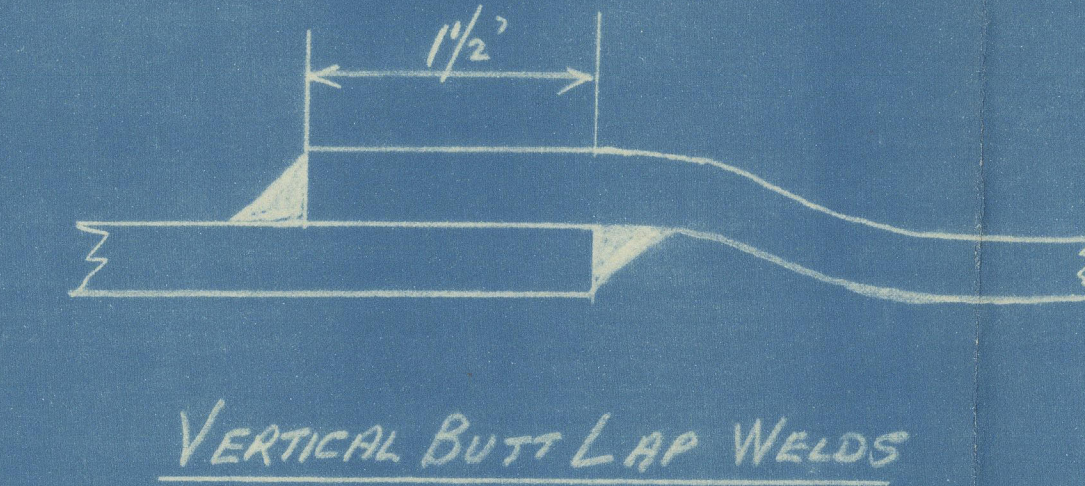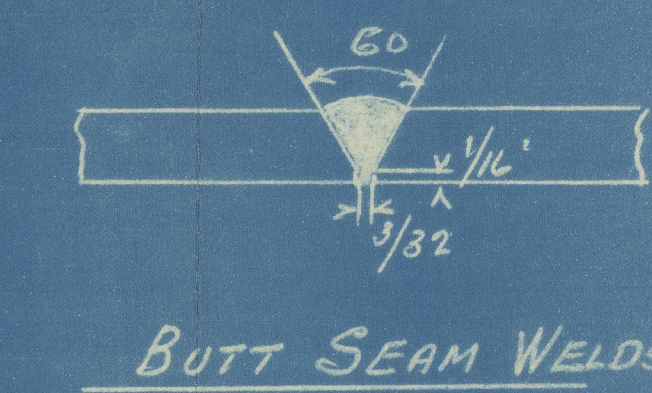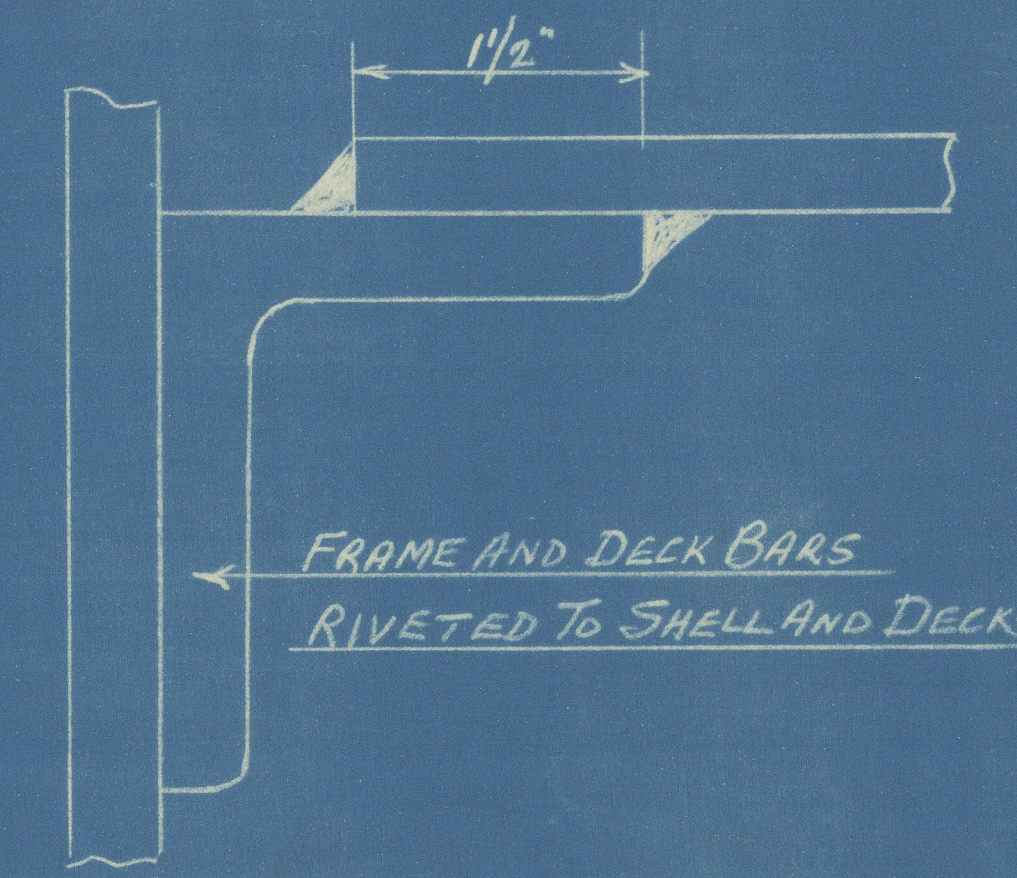


PLAN VIEW OF BHD

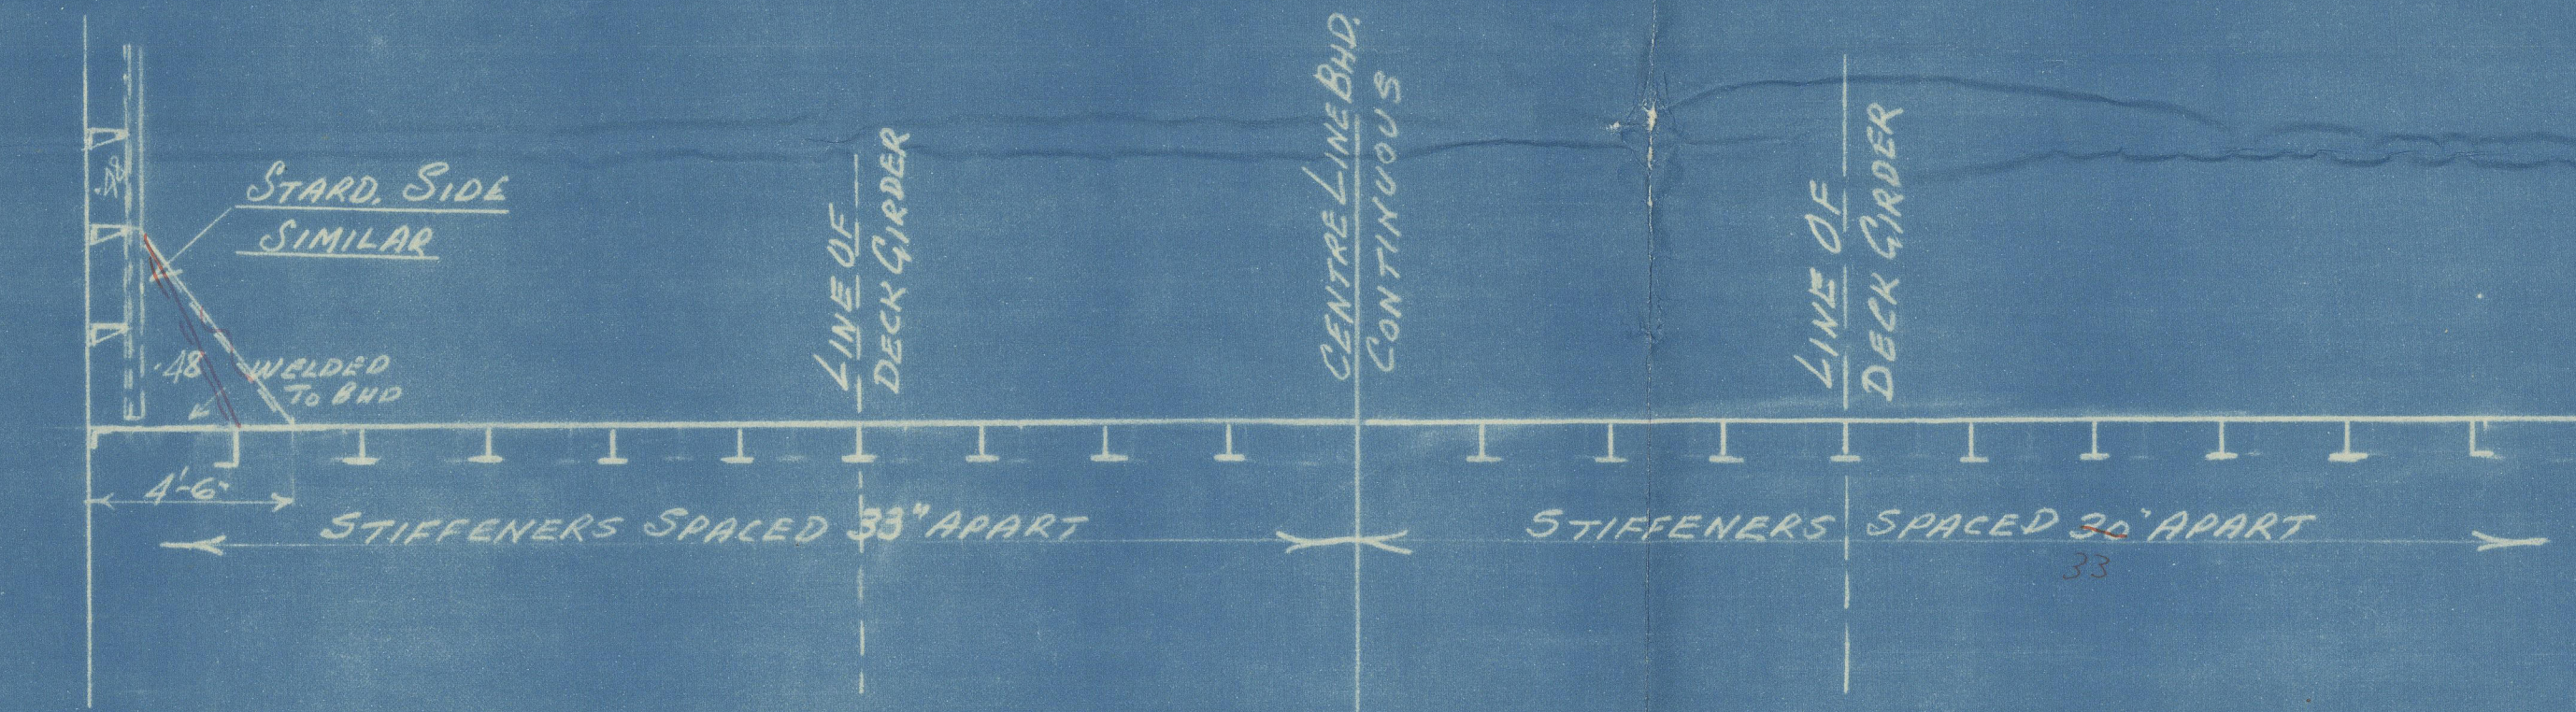


PLAN VIEW OF BHD

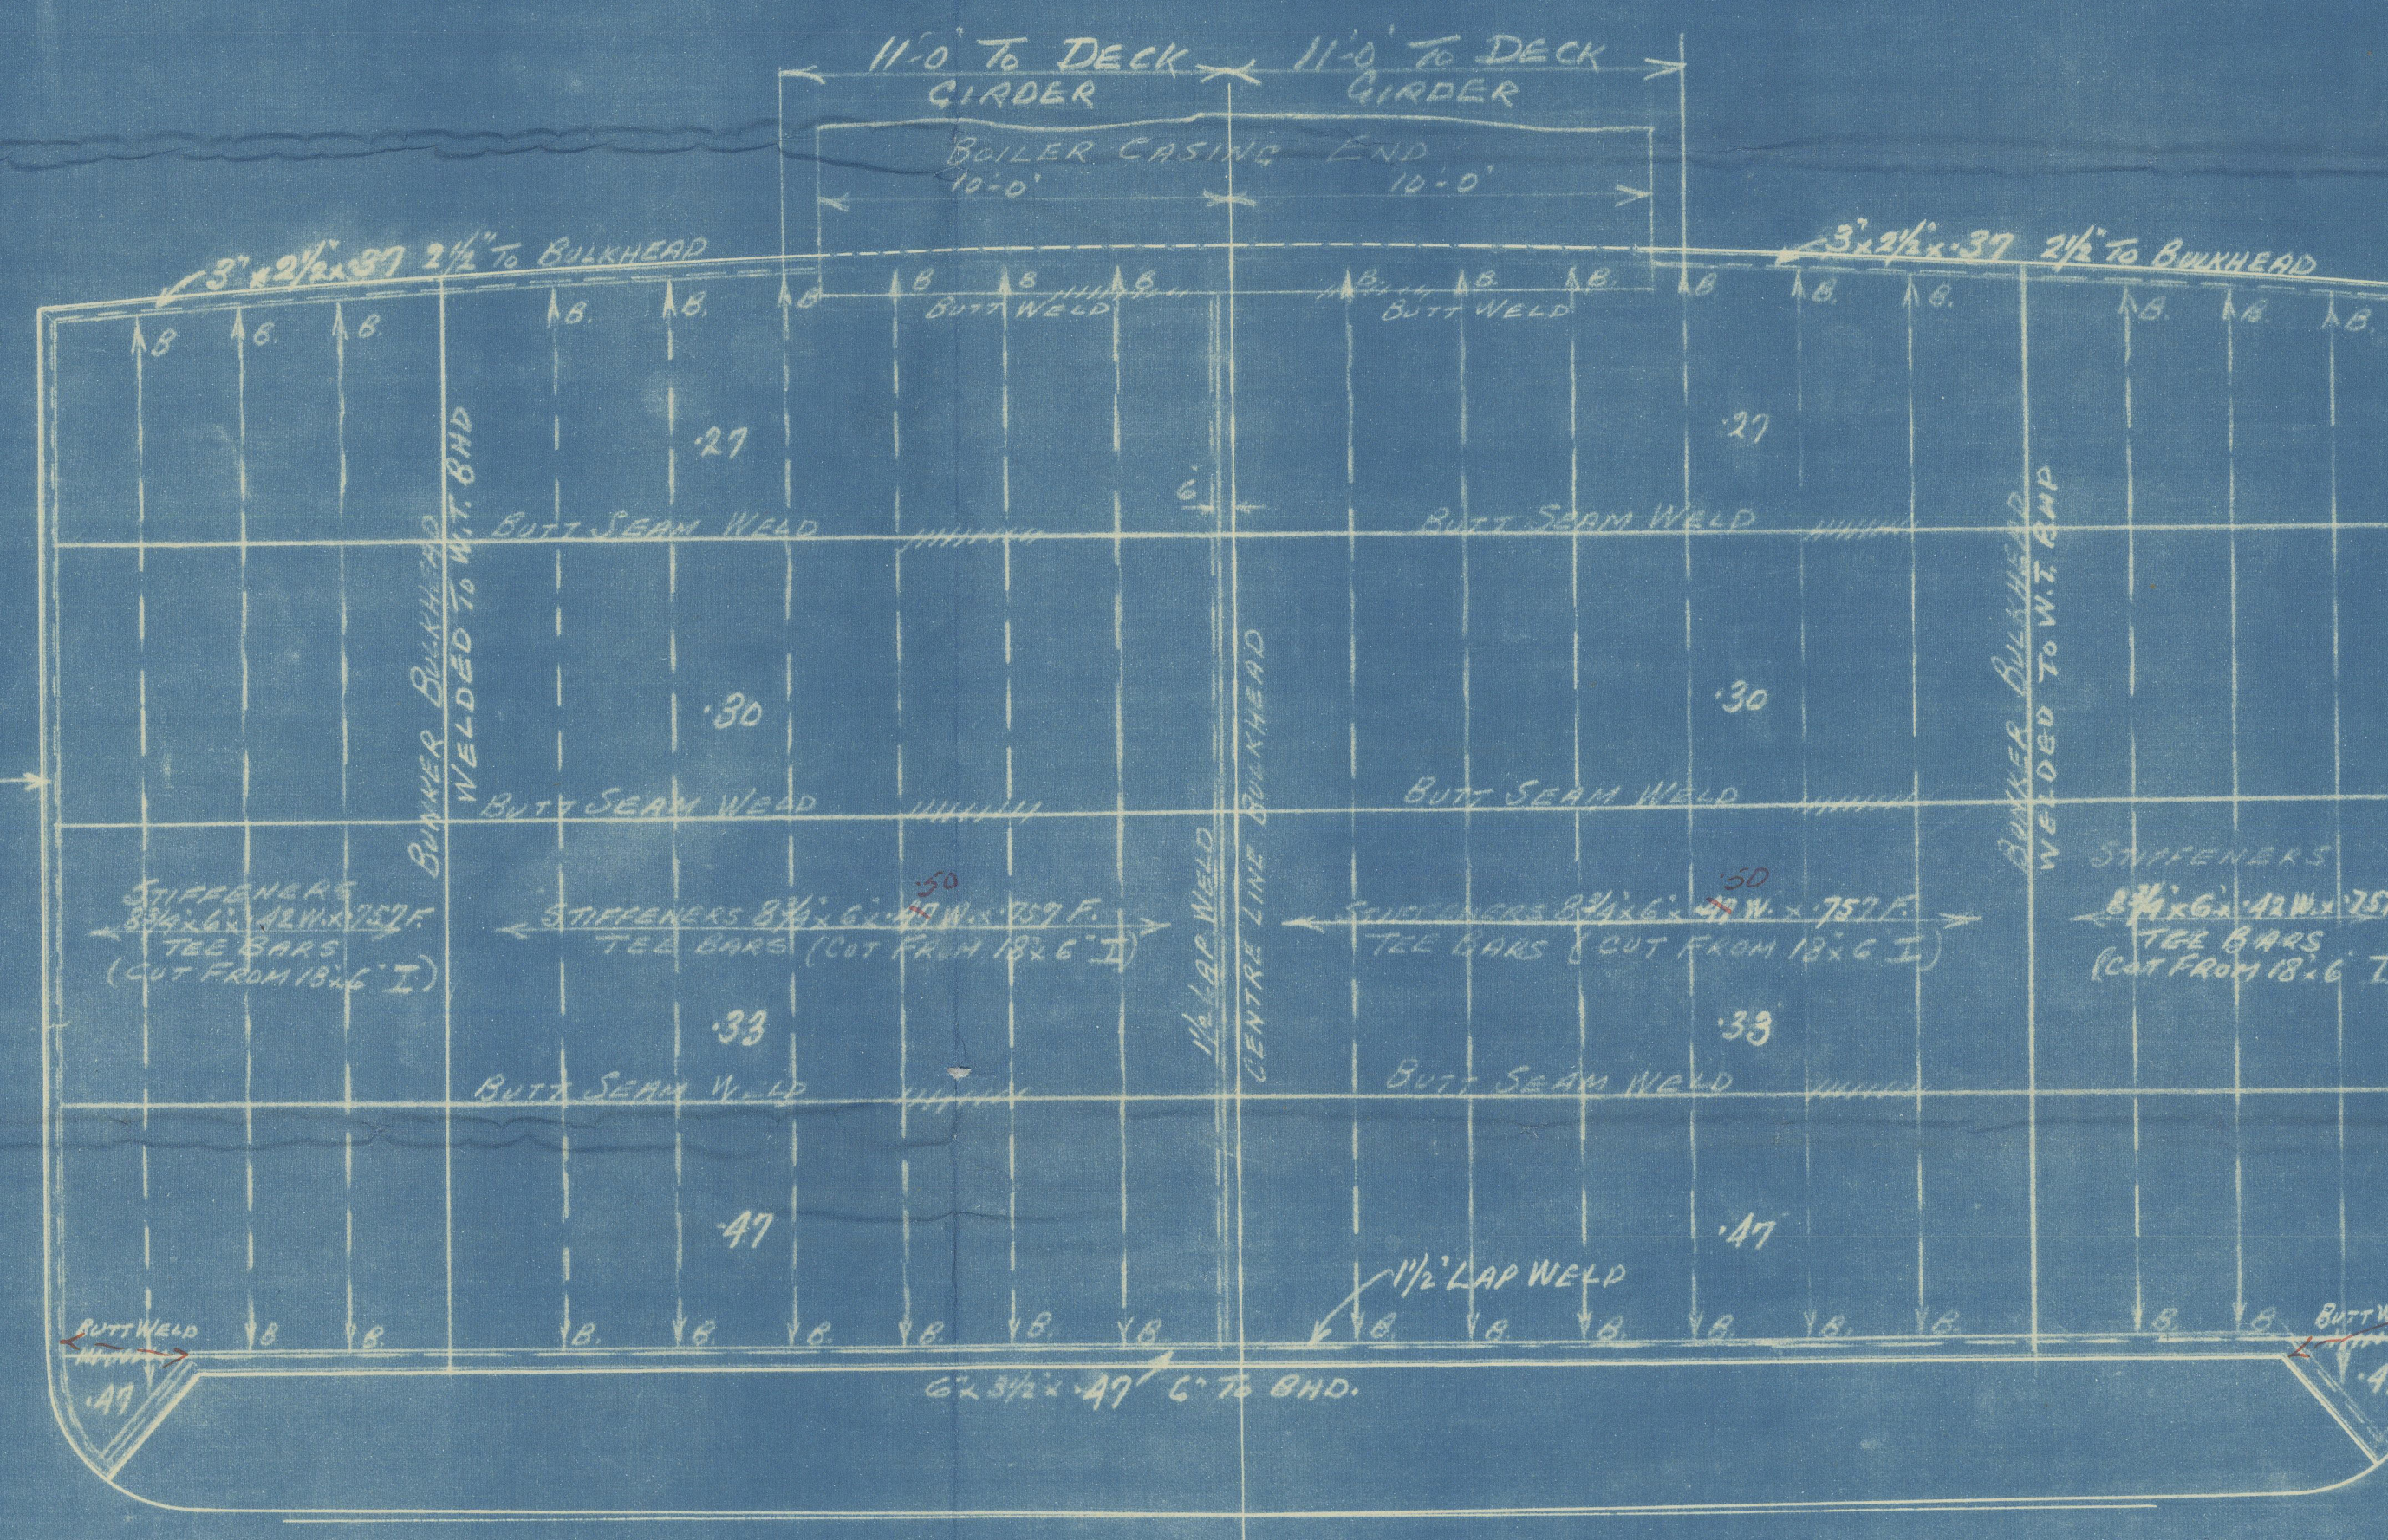


W.T. BULKHEAD N^o 92
LOOKING FORWARD

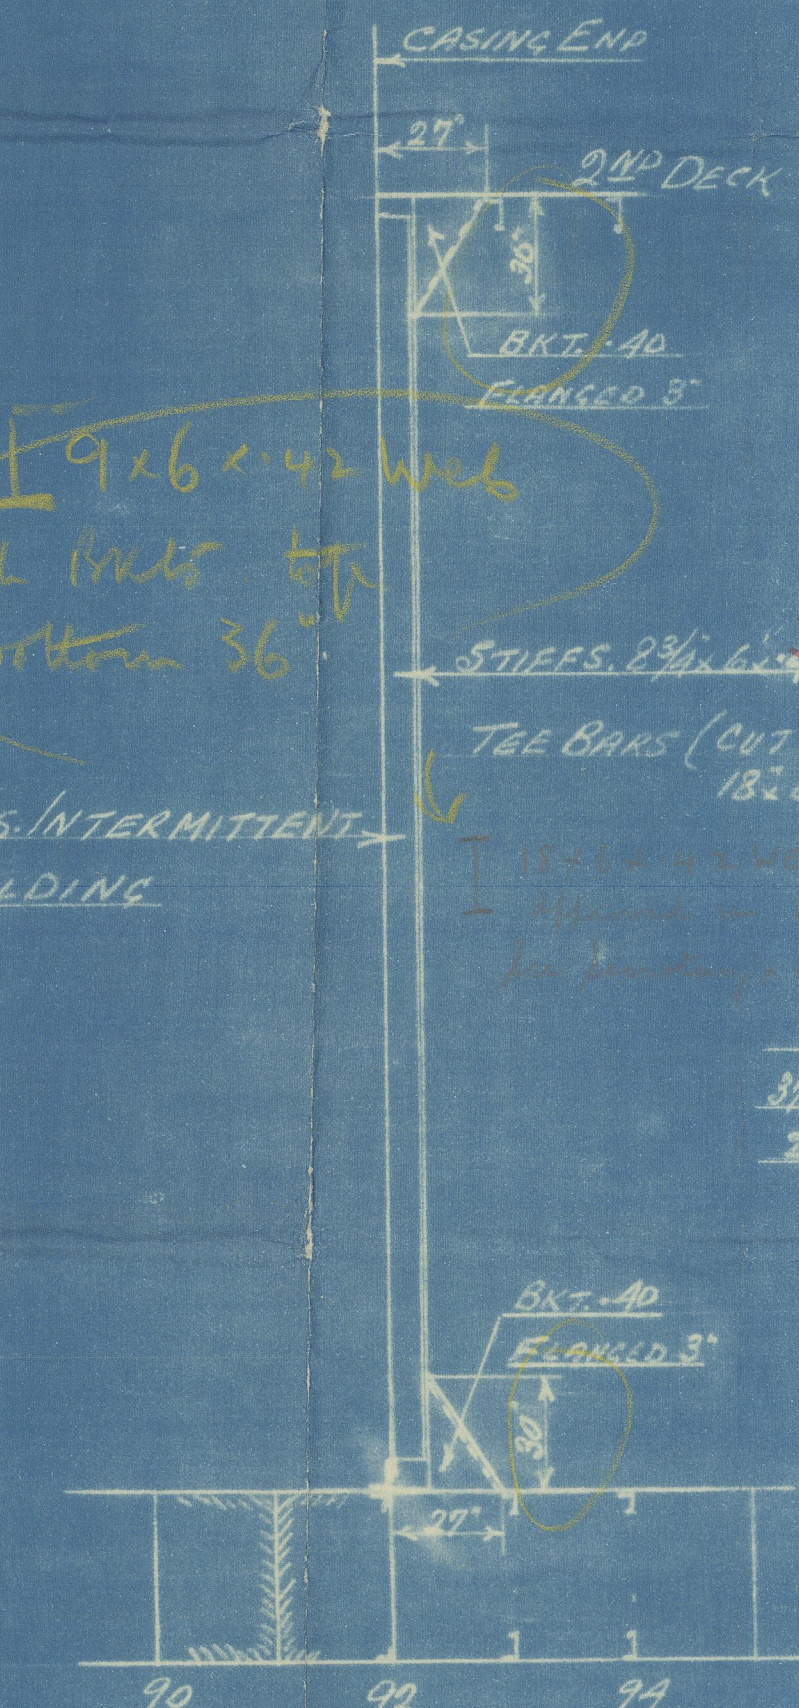

ELEVATION OF BHD.
STIFFENER CONNECTION

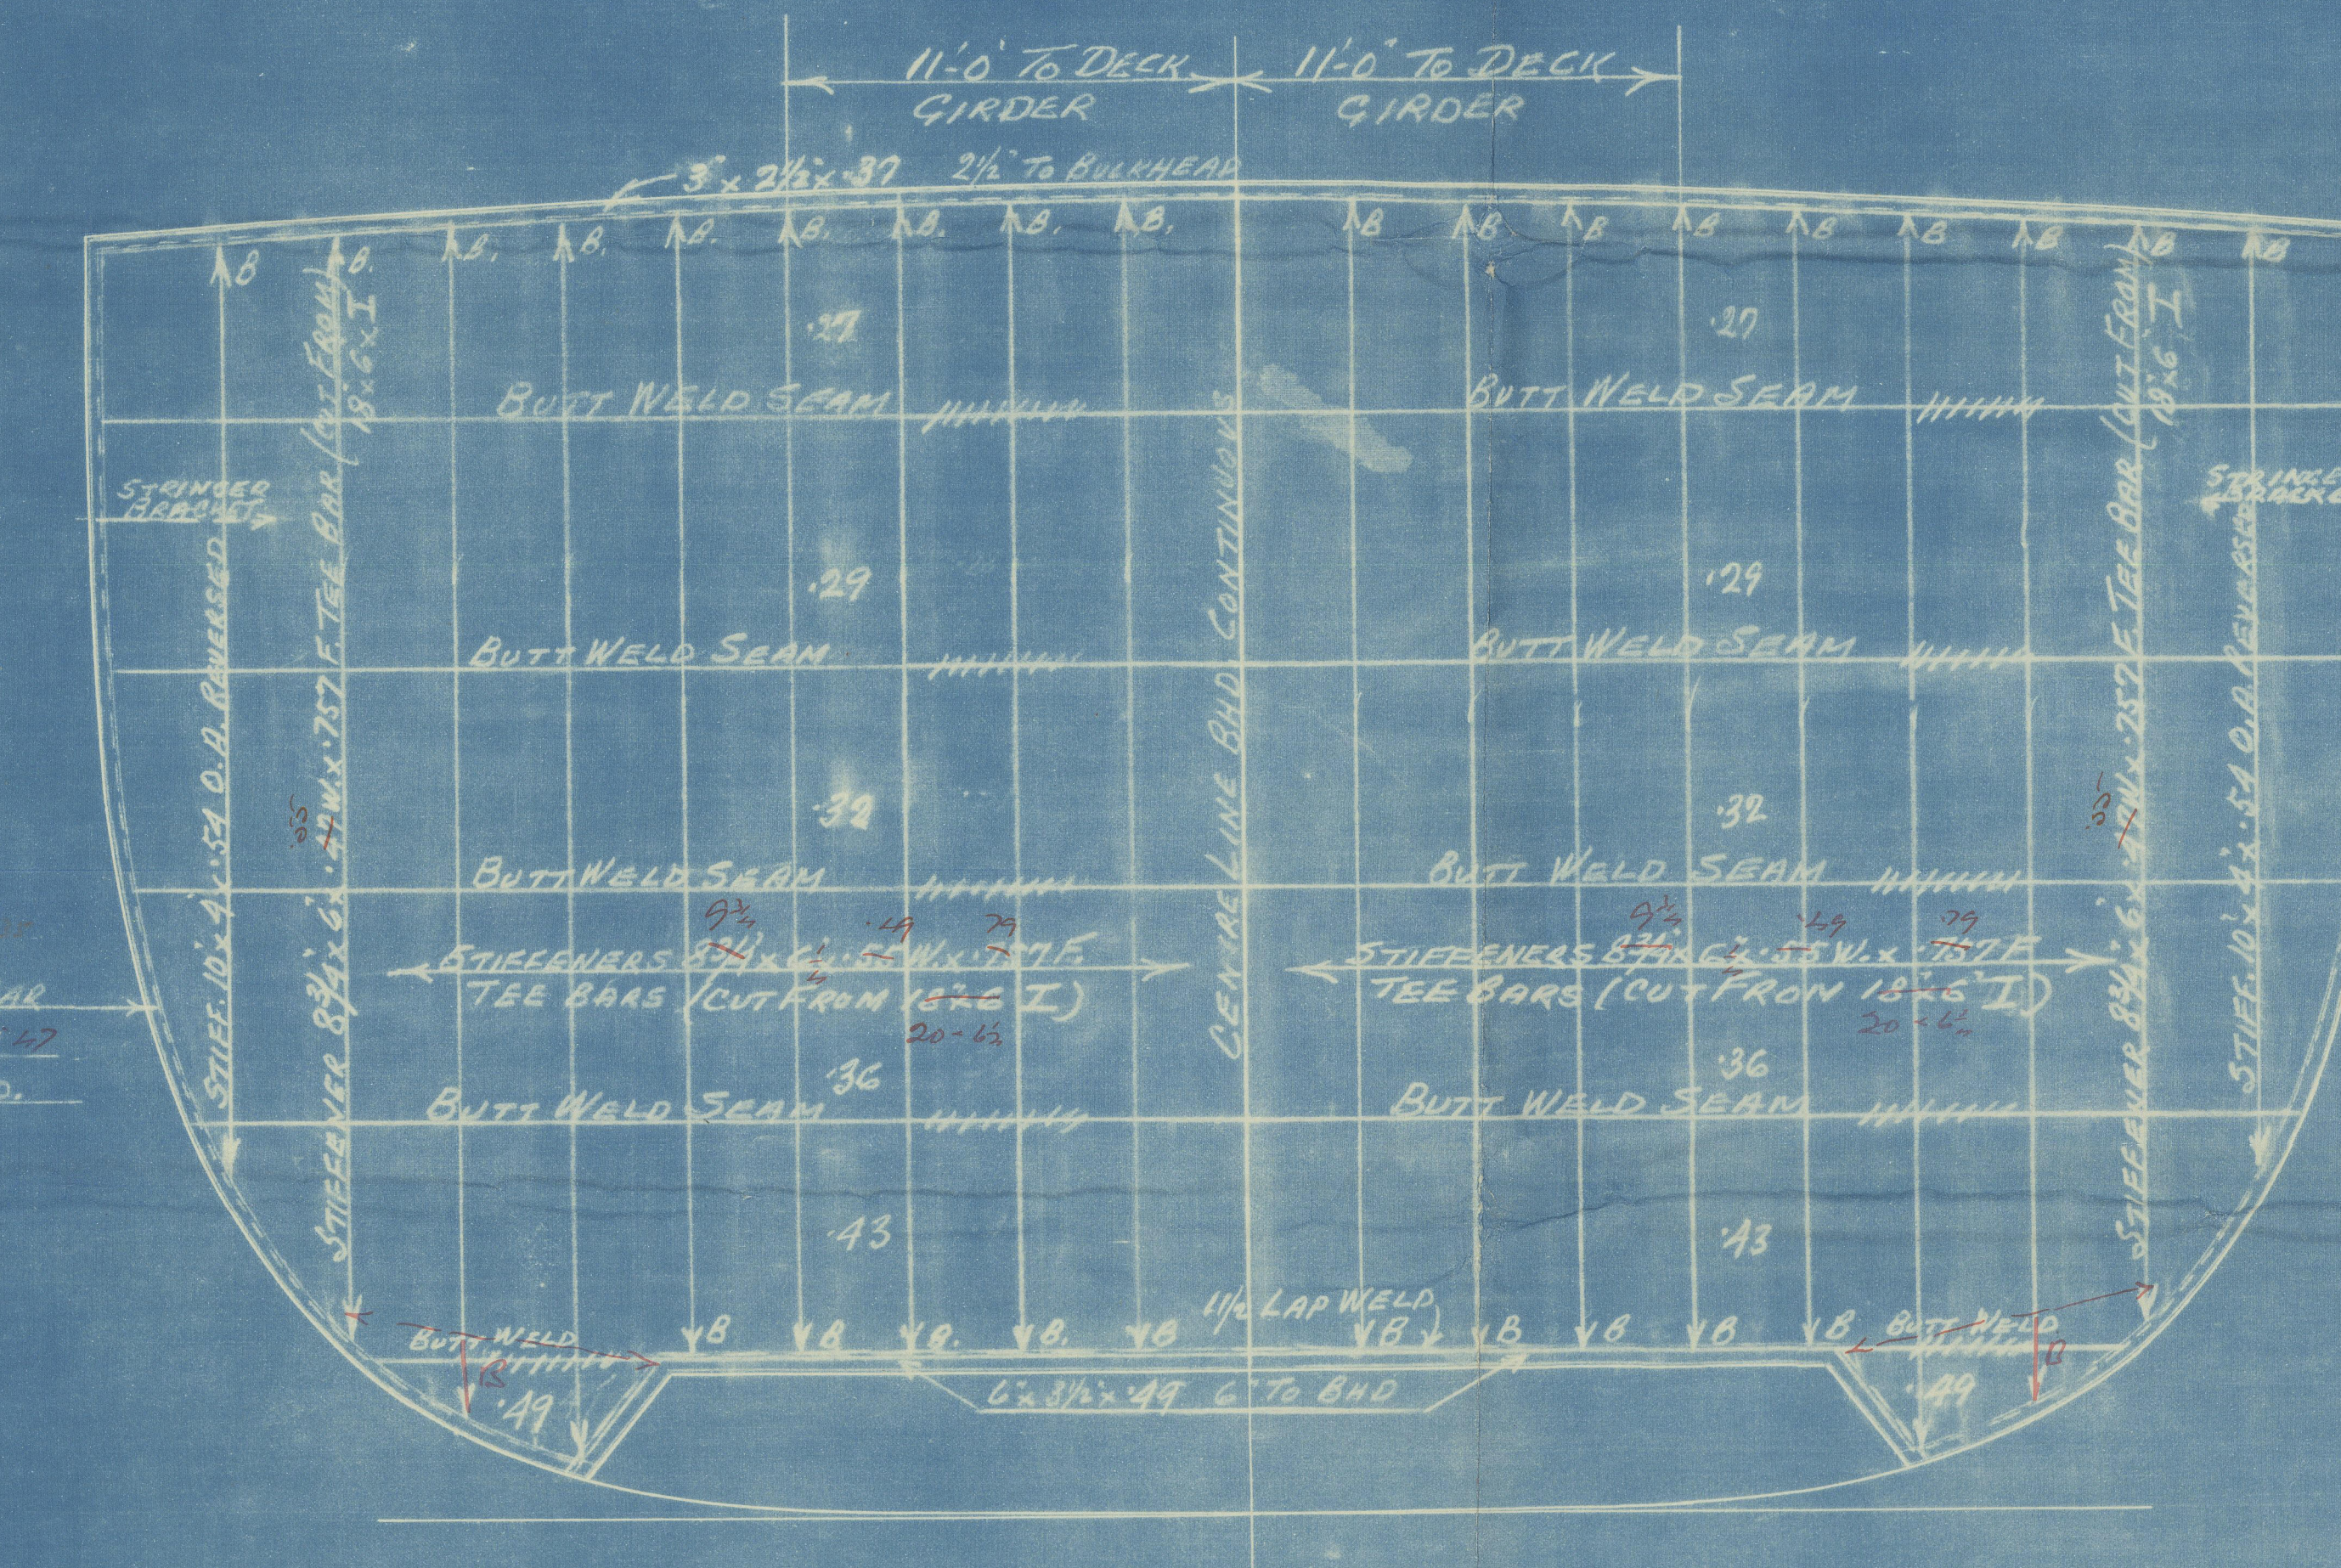


W.T. BULKHEAD N^o 134
LOOKING FORWARD

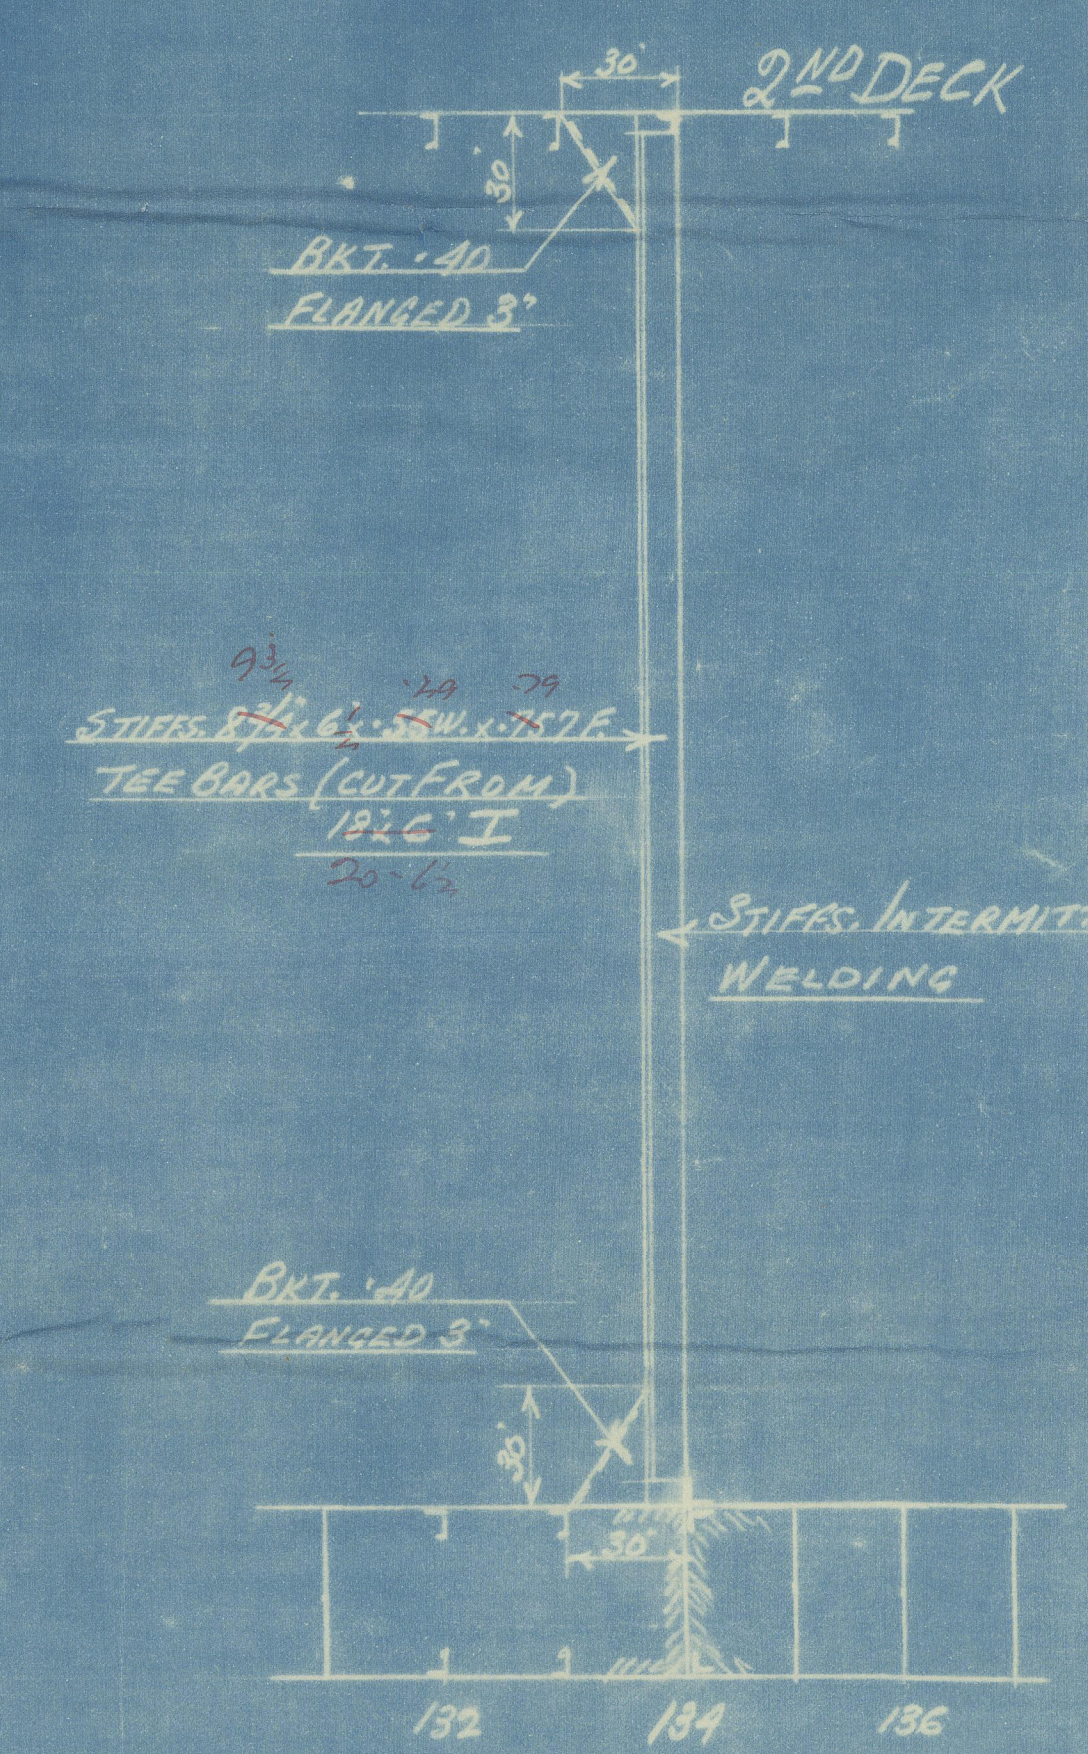

ELEVATION OF BHD.
STIFFENER CONNECTION


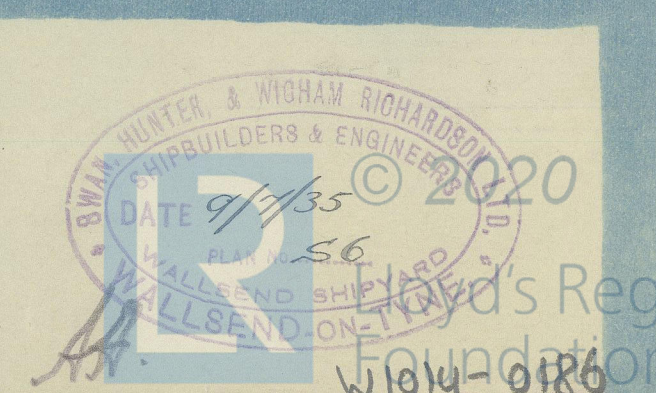

(6)

Swan Hunters No 1513

Trans. Bulks. E.W.

SS HOPESTAR

NEWCASTLE ON TYNE.

Report No. 93528.



© 2020

Lloyd's Register
Foundation

W104-0186