

N^o 1513

AFTER PEAK W.T. BULKHEAD

SCALE 1/4" = 1 FT.

WELDED CONSTRUCTION


Nº 1513

FORE PEAK W.T. BULKHEAD

SCALE $\frac{1}{4}'' = 1 \text{ FT.}$

WELDED CONSTRUCTION

PLAN VIEW OF BULKHEAD

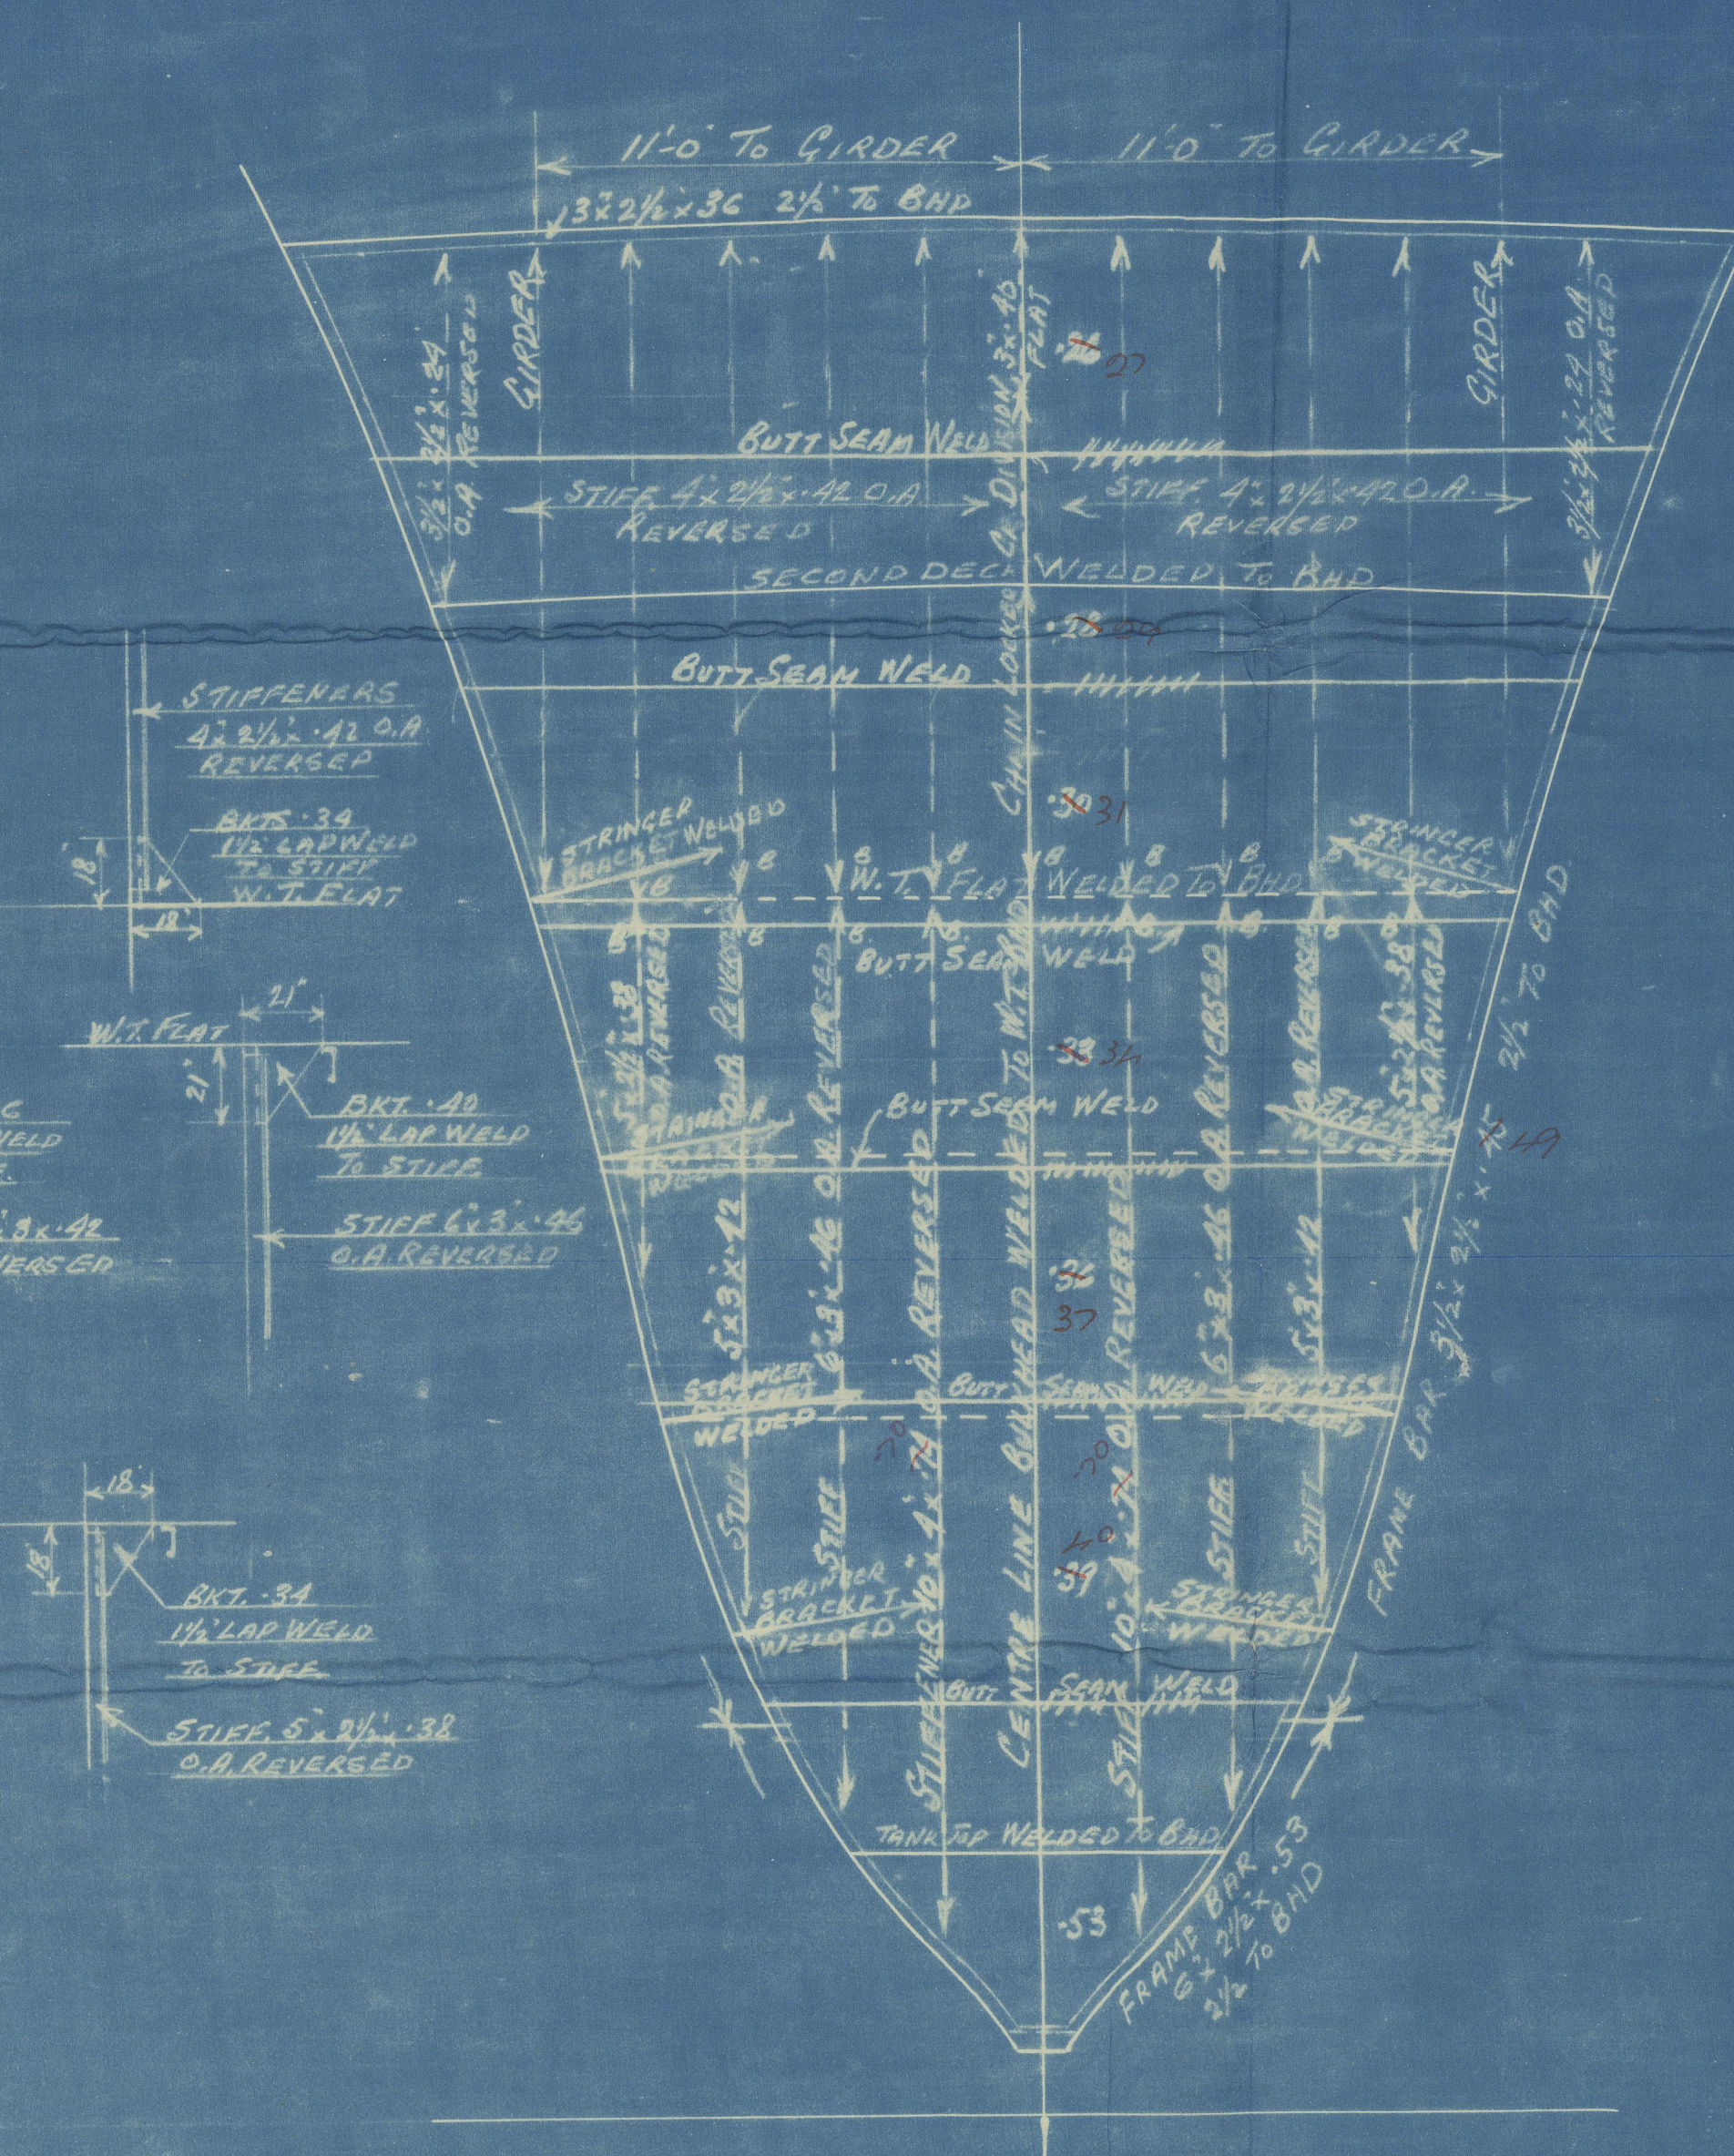

W. T. BULKHEAD N^o 161

LOOKING FORWARD

NOTE. HEIGHT OF OVERFLOW PIPE
FOR FORE PEAK 2'-0" ABOVE
FORECASTLE DECK

PLAN VIEW OF CHAIN LOCKER BHD.

CHAIN LOCKER BULKHEAD N^o 164

LOOKING FORWARD




(11)

Ev.

Swan Hunter's No 1513

51

Fore & Aft
Peak Bulb

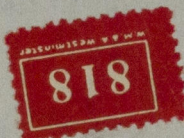

SS HOPESTAR

NEWCASTLE ON TYNE.

Report No. 93528

5151

W1014-0190



FLAT 18
81
30
e Ward
5-2-38