



THE ROBERTS SAFETY WATER TUBE BOILER CO.
REDBANK N.J.

SIZE ~~6' x 8'~~ *6' x 8'*

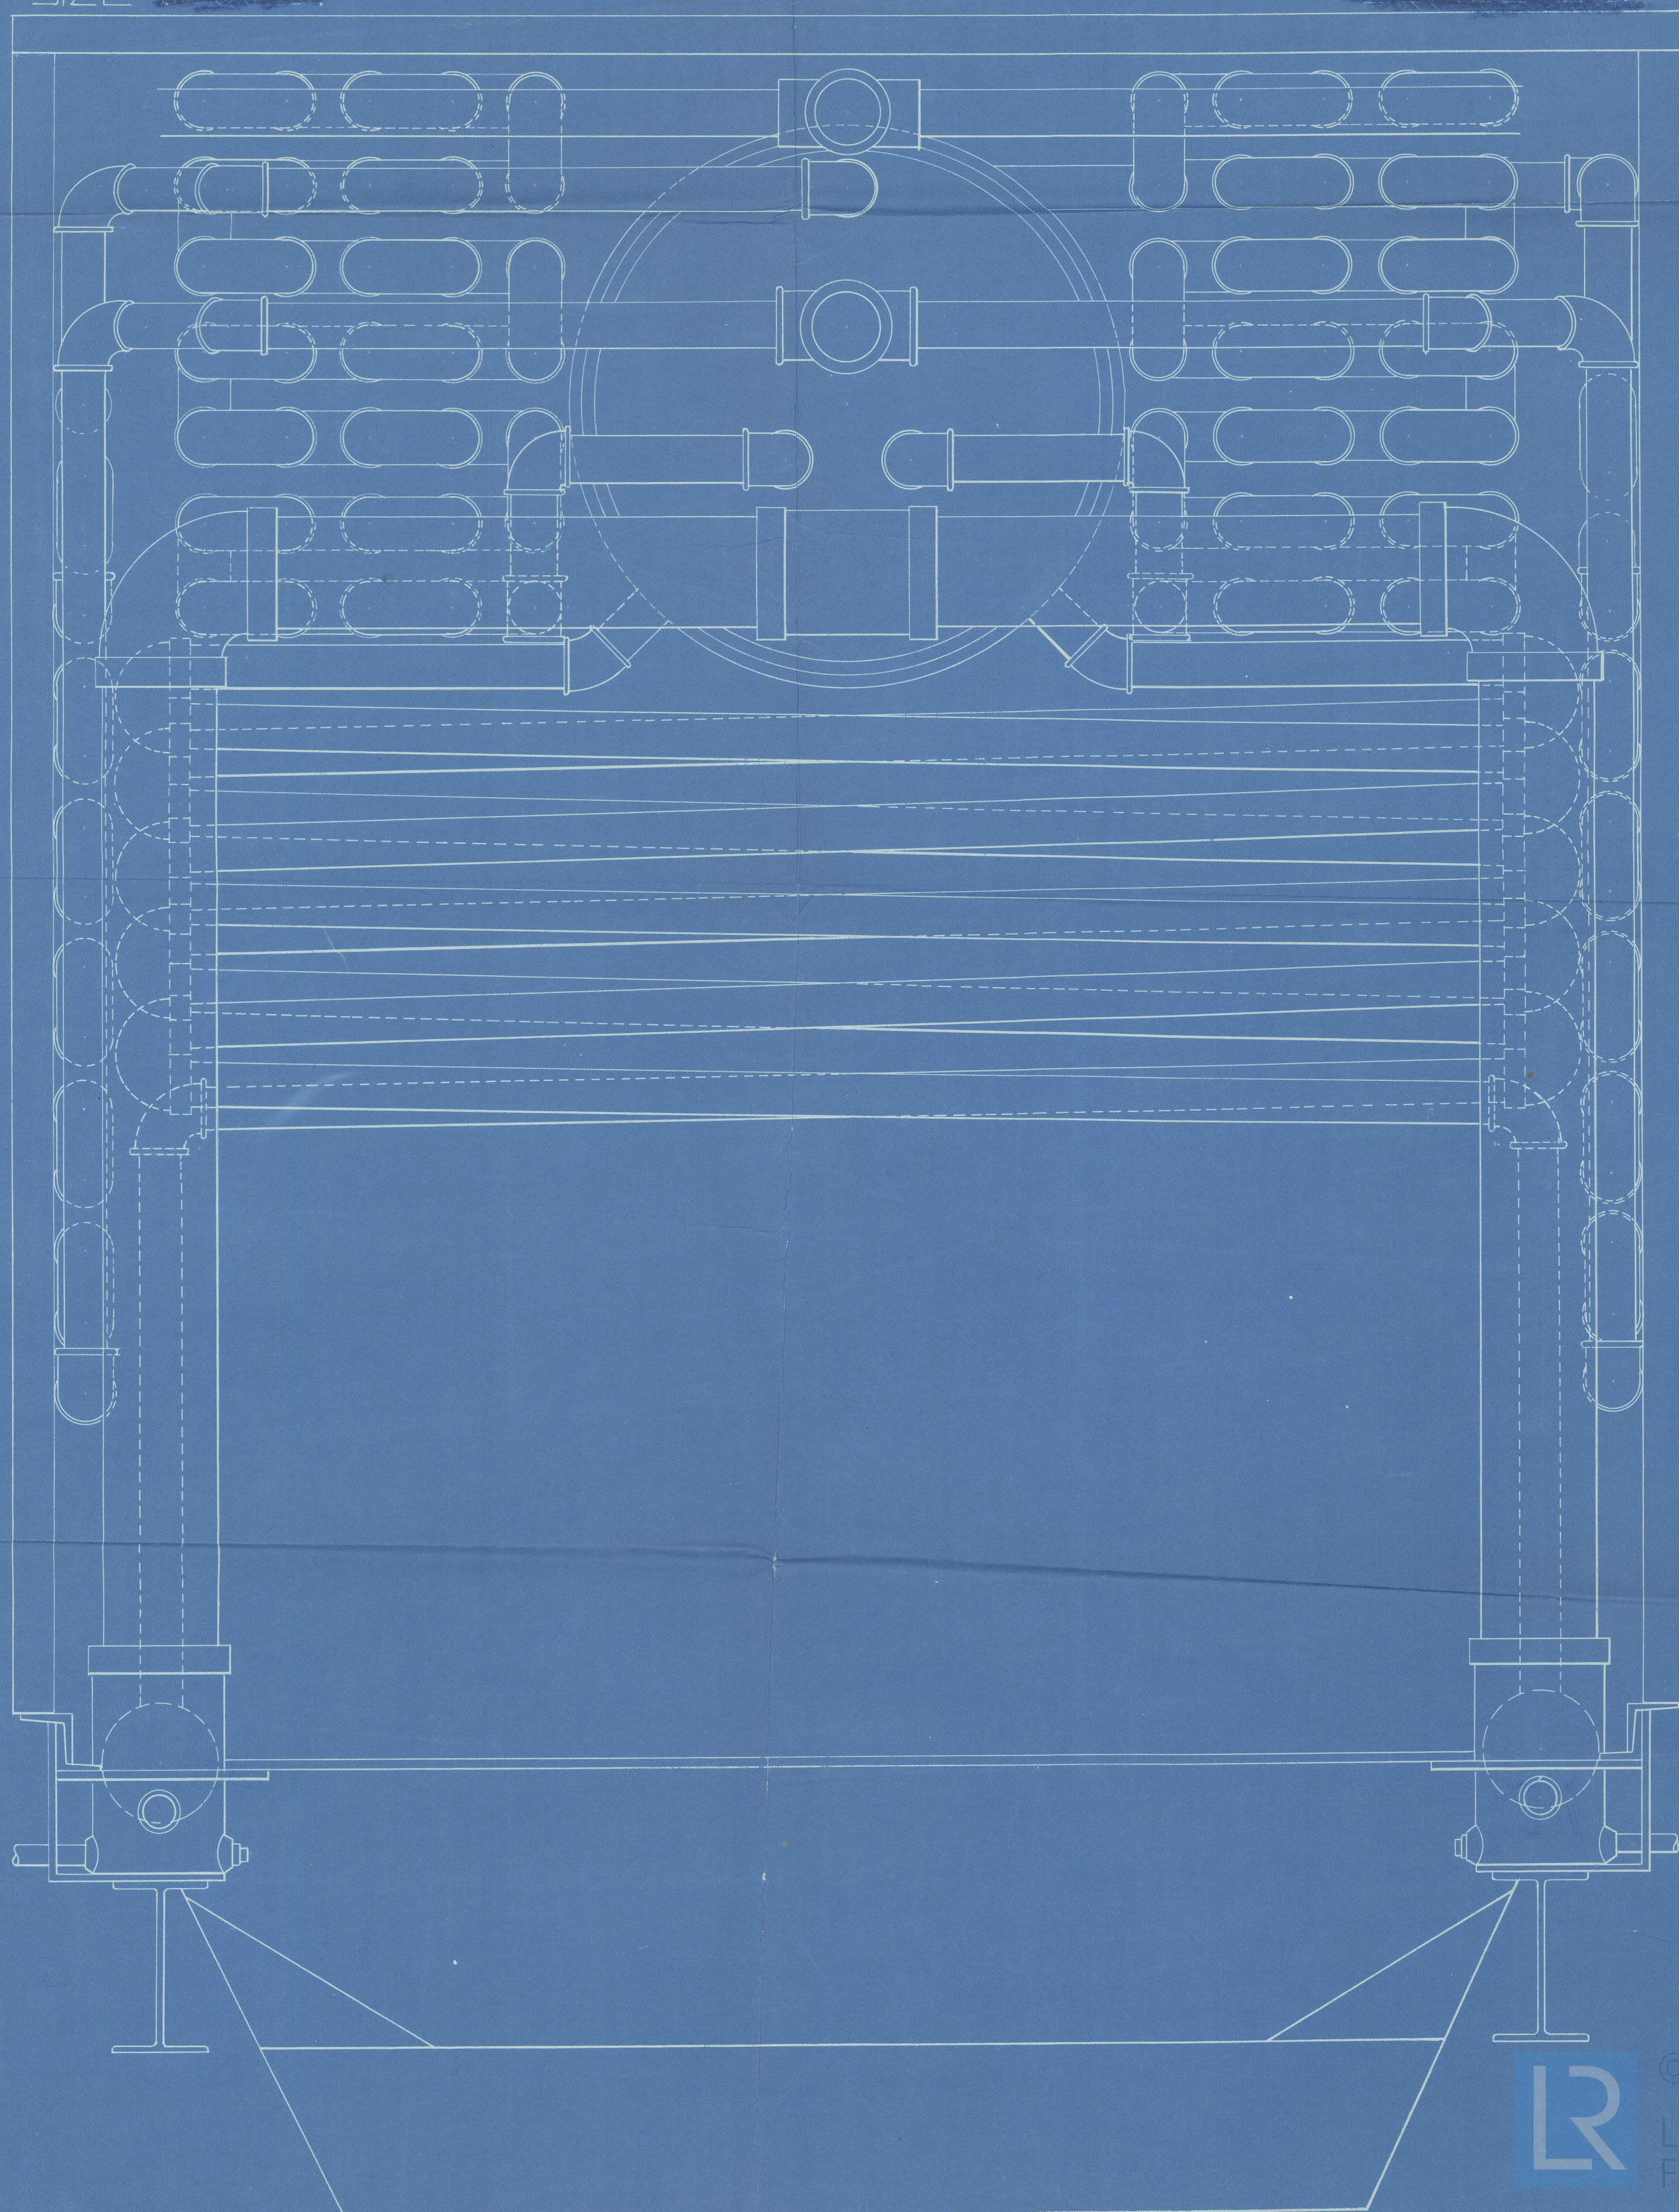

Final
8.9.16

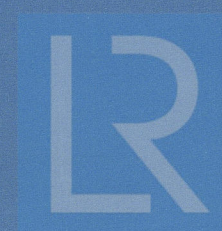

© 2020
Lloyd's Register
Foundation

W1615-0089