

Plan No 1.

General arrangement plan showing
new midship bridge with officers accom-
modations & with connecting flying
gangway from poop.

Fabricated and erected by the
Havana Marine Railways Inc.

March 1st 1919.


Accepted,

C. J. Burney

Naval Architect for Owners,

Capt. W. J. Knight

Master.

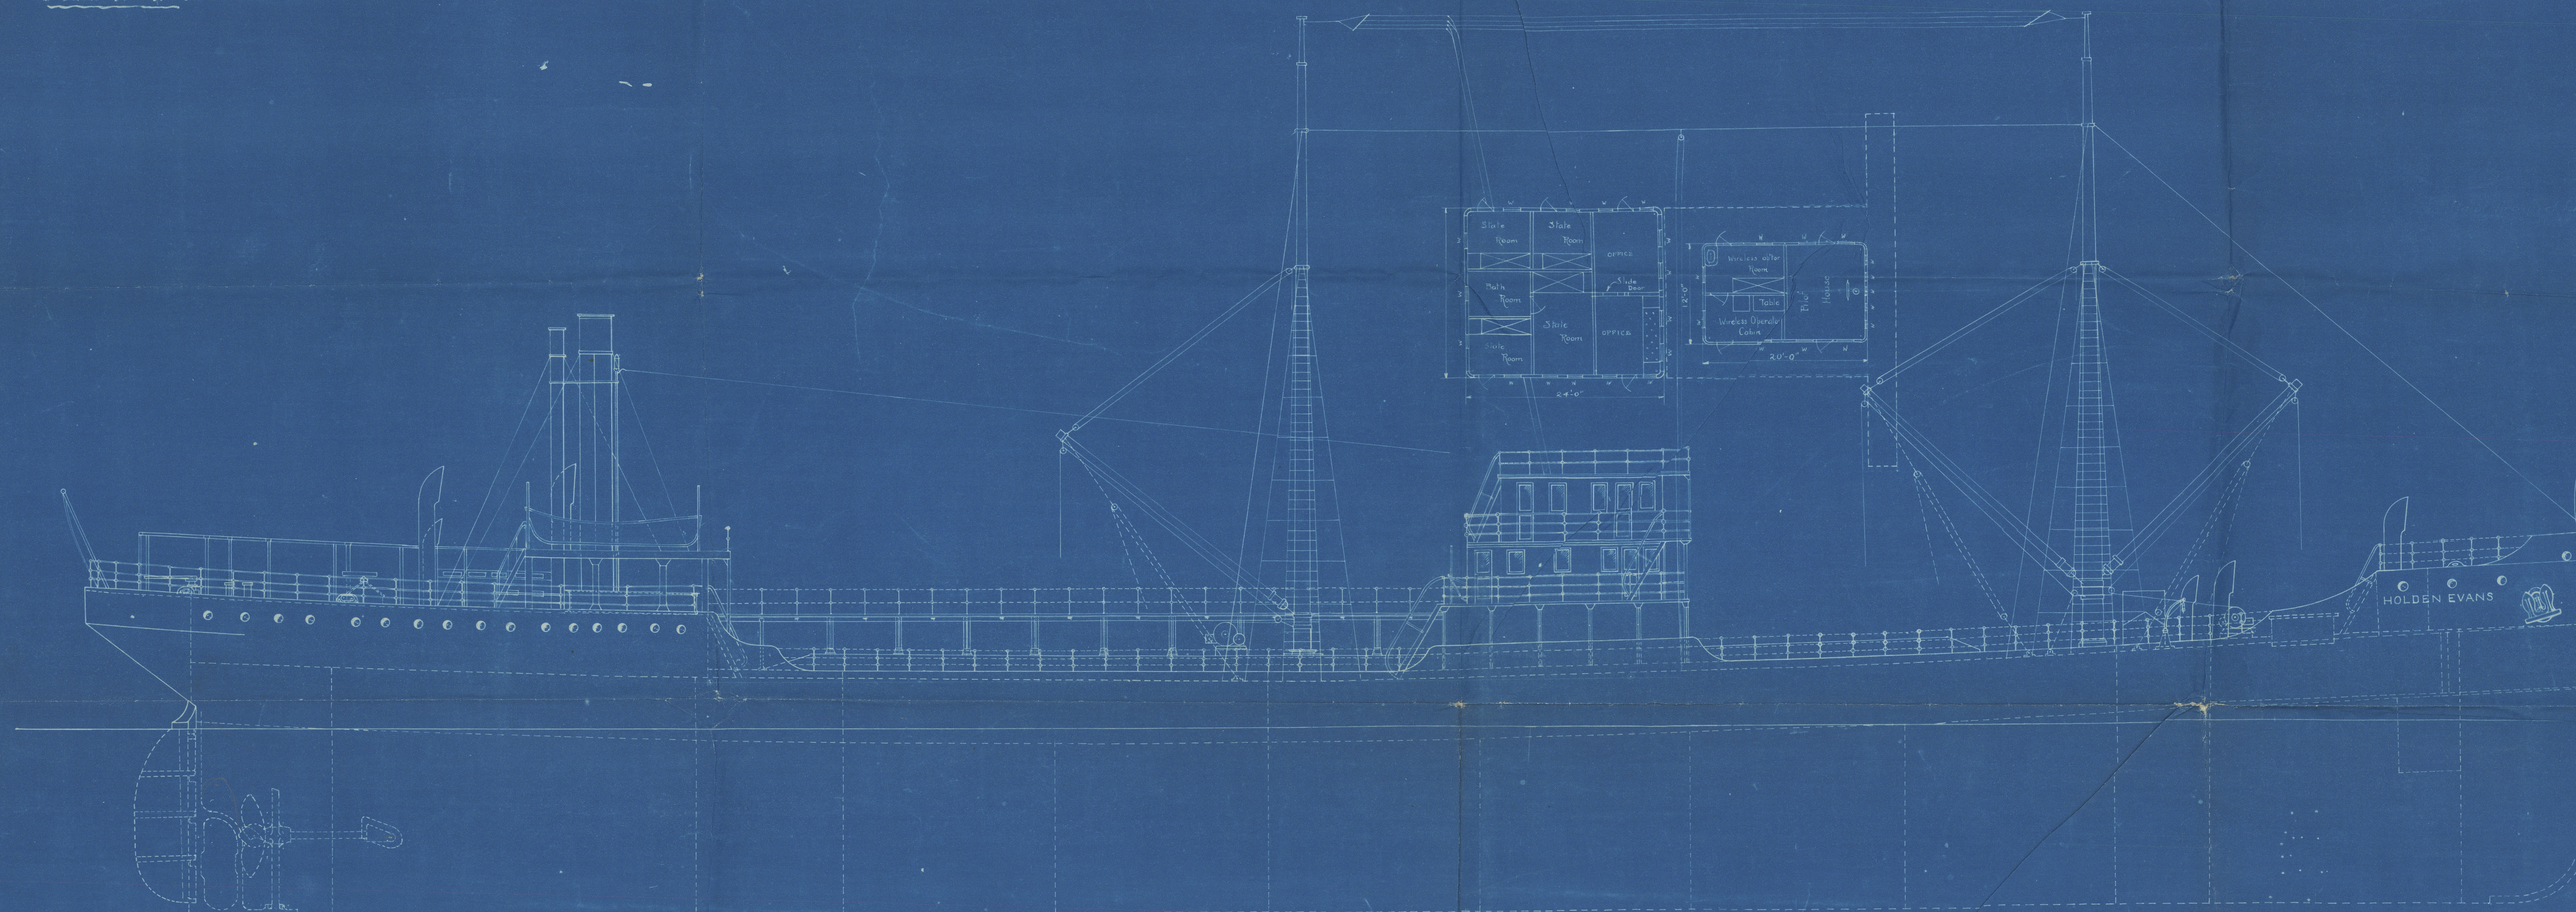


Approved as fitted
John Waddell
Surveyor acting for Lloyd's
Port of Havana
Cuba March 14/19.

Original plan of Crews Quarters.

new navigating bridge, see detail plans.

new flying gangway.

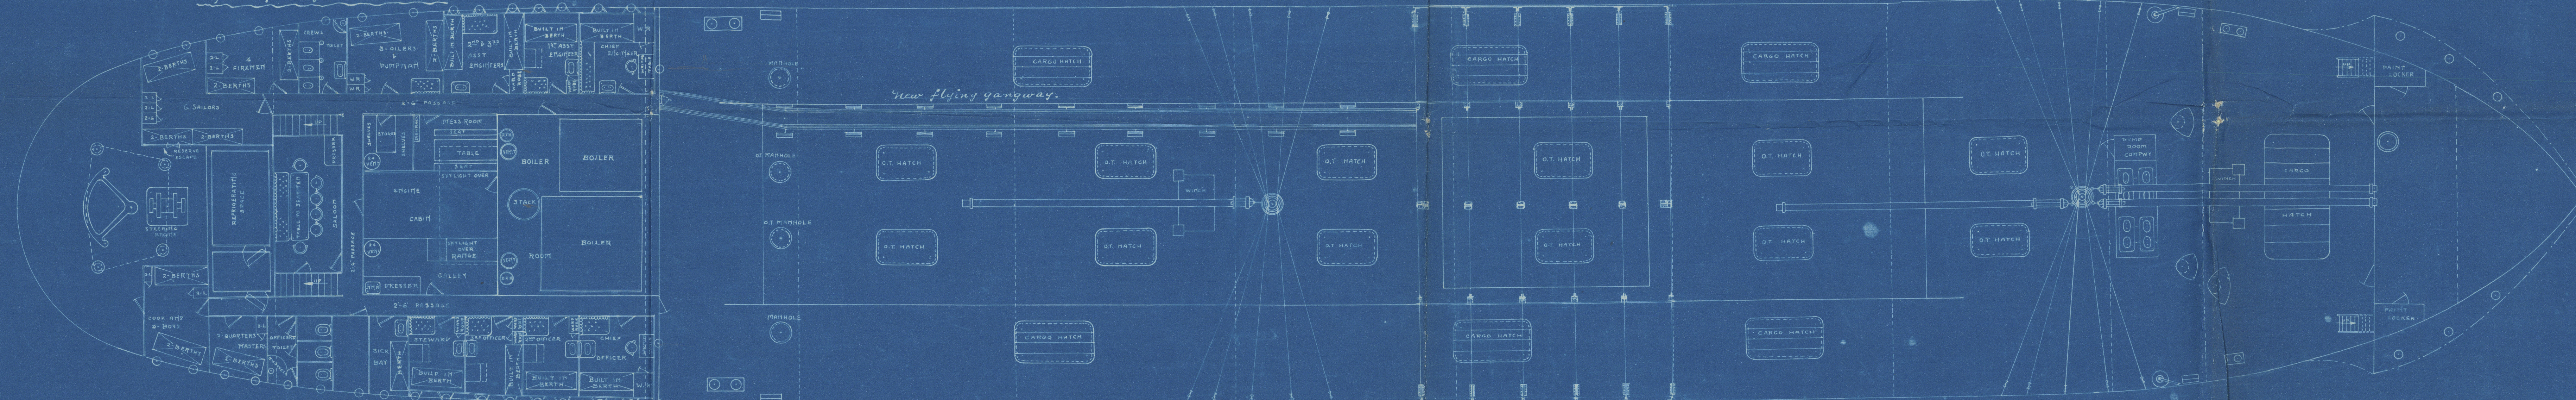

DIMENSIONS	
LENGTH OVERALL	306'0"
LENGTH B.B.	293'0"
BEAM	47'0"
DEPTH	28'0"

Cont. N° 4755 Drawing N° 195

Job: M/s Holden Evans

Title: General arrangement plan

HAVANA MARINE RAILWAYS INC.
HAVANA CUBA

Date: March 1st 1919
Scale: 1/8" = 1' 11"
Made by: E.P.
Checked by: E.H.

Approved
Superintendent

For London under report
from Savannah come

Plating Over Baker

Mr John Waddle

Survivor

(Lords
Havane)

1700-5101M



© 2020

Lloyd's Register
Foundation

Bomkoria ex Holden Evans

11 Q 97. B

11 Bankia.
esc

4

W1015-0071

EMARE TRIZE

~~Gen Arizmit~~

Bal rept No. 2055.

© 2020

Levy's Register
Foundation