

UNDER DECK TONNAGE COEF. 708

SHEER AT F.P. 3'-9"

5.2.09. " " 1/8 LENGTH AFT F.P. 1'-7 1/2"

" " A.P. 2'-8"

" " 1/8 LENGTH BEFORE A.P. 1'-3"

No 452. MIDSHIP SECTION.


STEEL SCREW STEAMER

DIM: 135'-0" x 23'-0" x 10'-6" MLD

SCALE 1/2" = ONE FOOT

CLASS 100-A.1. AT LLOYD'S.

PLAN No. 8217
FOR ENCLOSURE TO
Lloyd's Surveyors
Hull FROM
COCHRANE & CO. LTD.
SHIPBUILDERS, 8, 9, 10,1000

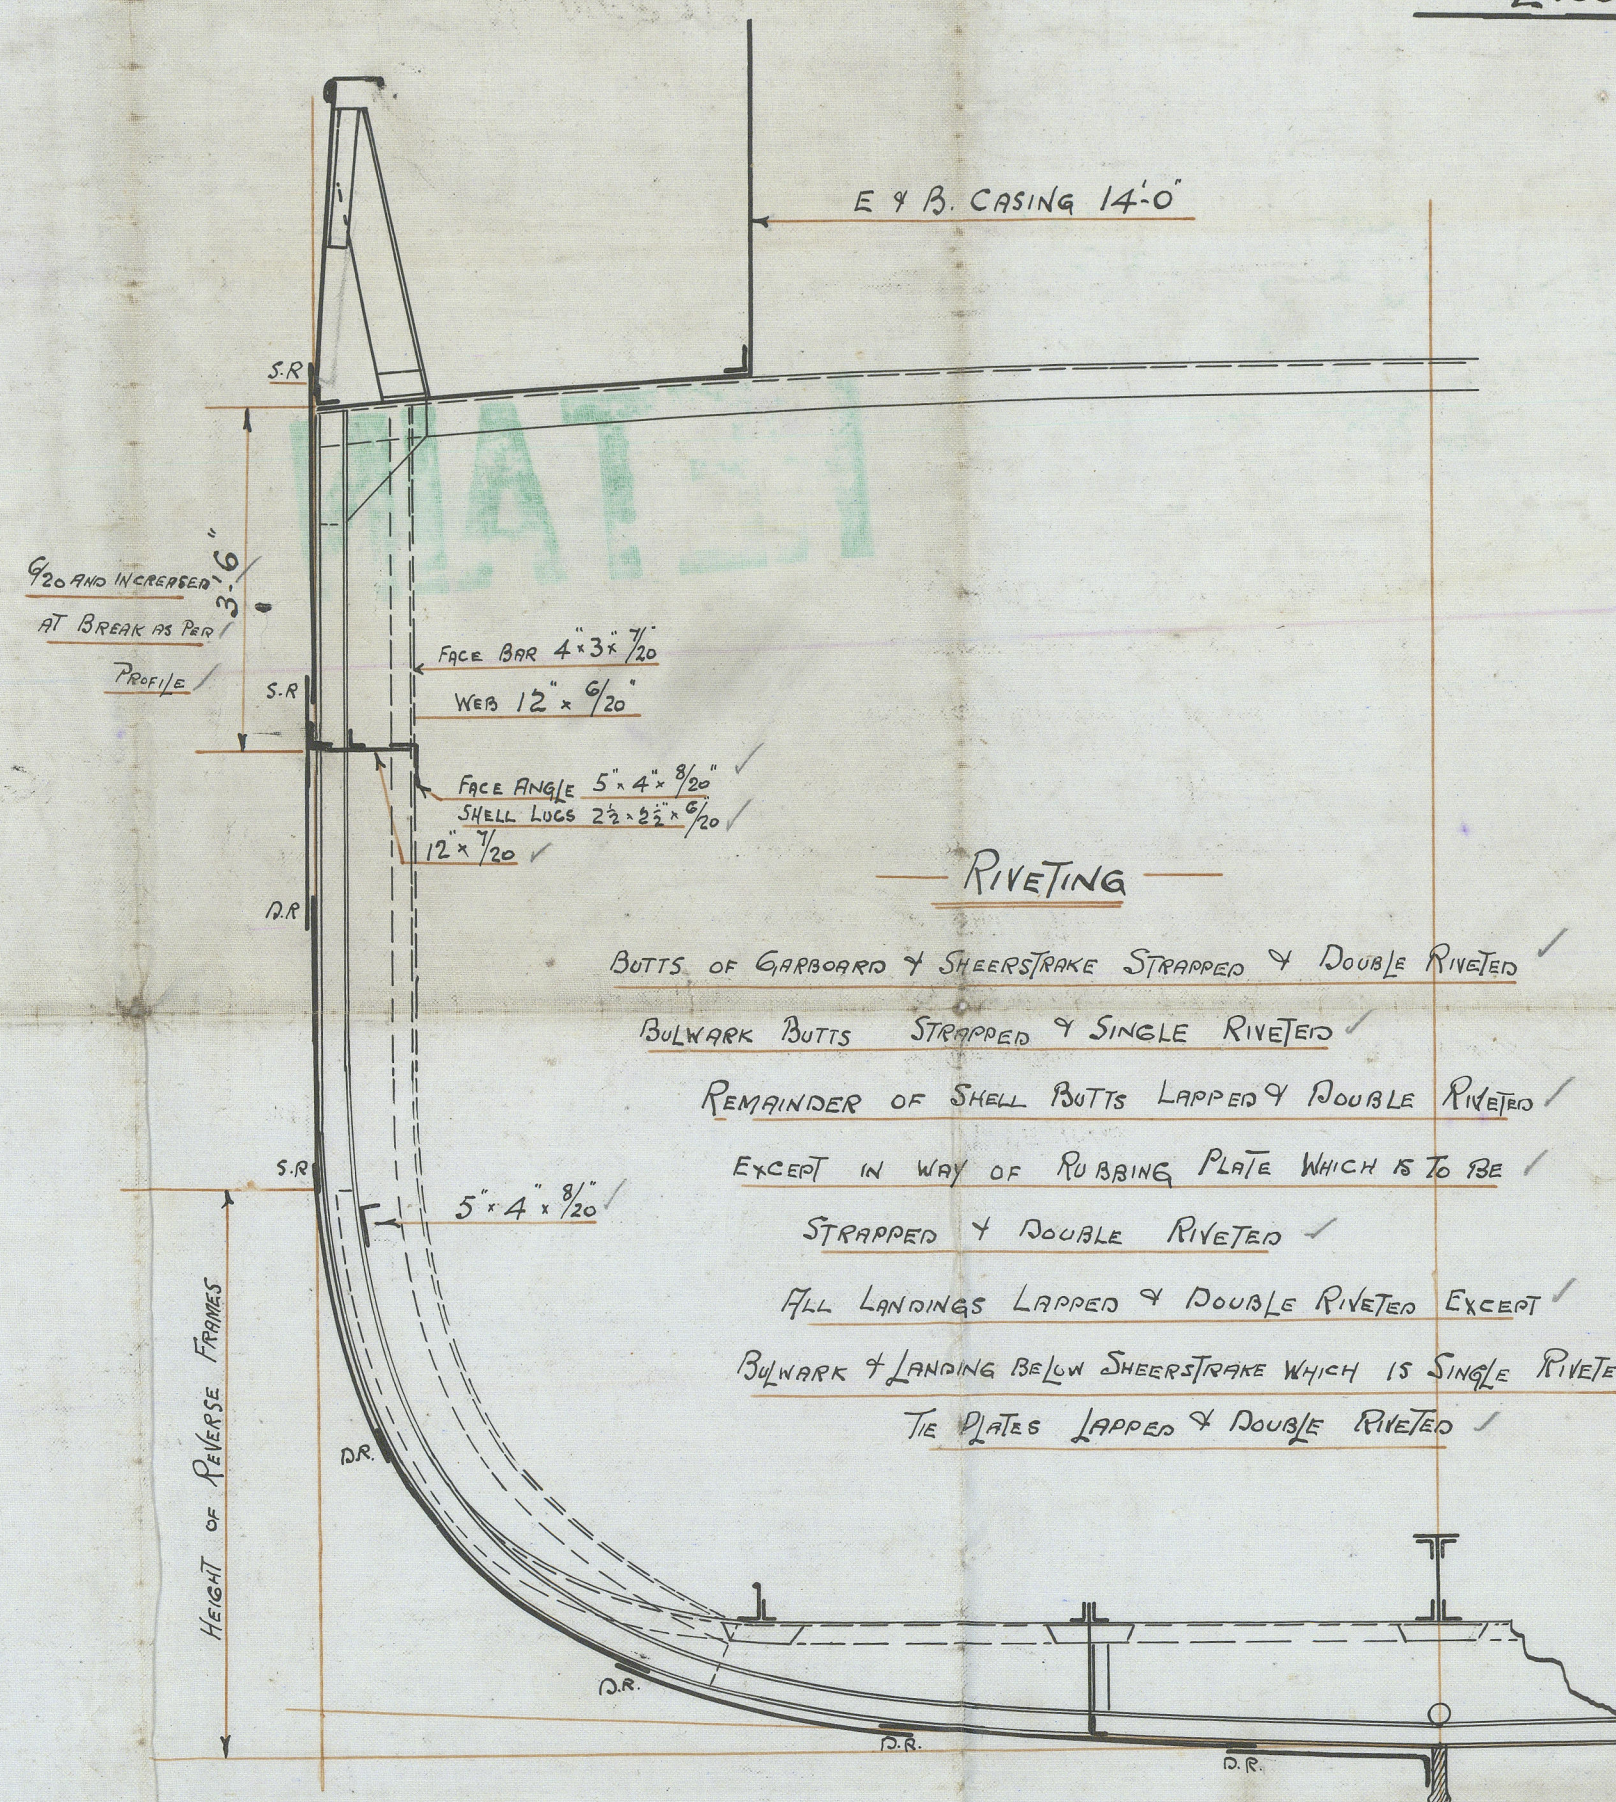

RIVETING

BUTTS OF GARBOARD & SHEERSTAKE STRAPPED & DOUBLE RIVETED

BULKHEAD BUTTS STRAPPED & SINGLE RIVETED

REMAINDER OF SHELL BUTTS LAPPED & DOUBLE RIVETED


EXCEPT IN WAY OF RUBBING PLATE WHICH IS TO BE

STRAPPED & DOUBLE RIVETED

ALL LANDINGS LAPPED & DOUBLE RIVETED EXCEPT

BULKHEAD & LANDING BELOW SHEERSTAKE WHICH IS SINGLE RIVETED

TIE PLATES LAPPED & DOUBLE RIVETED

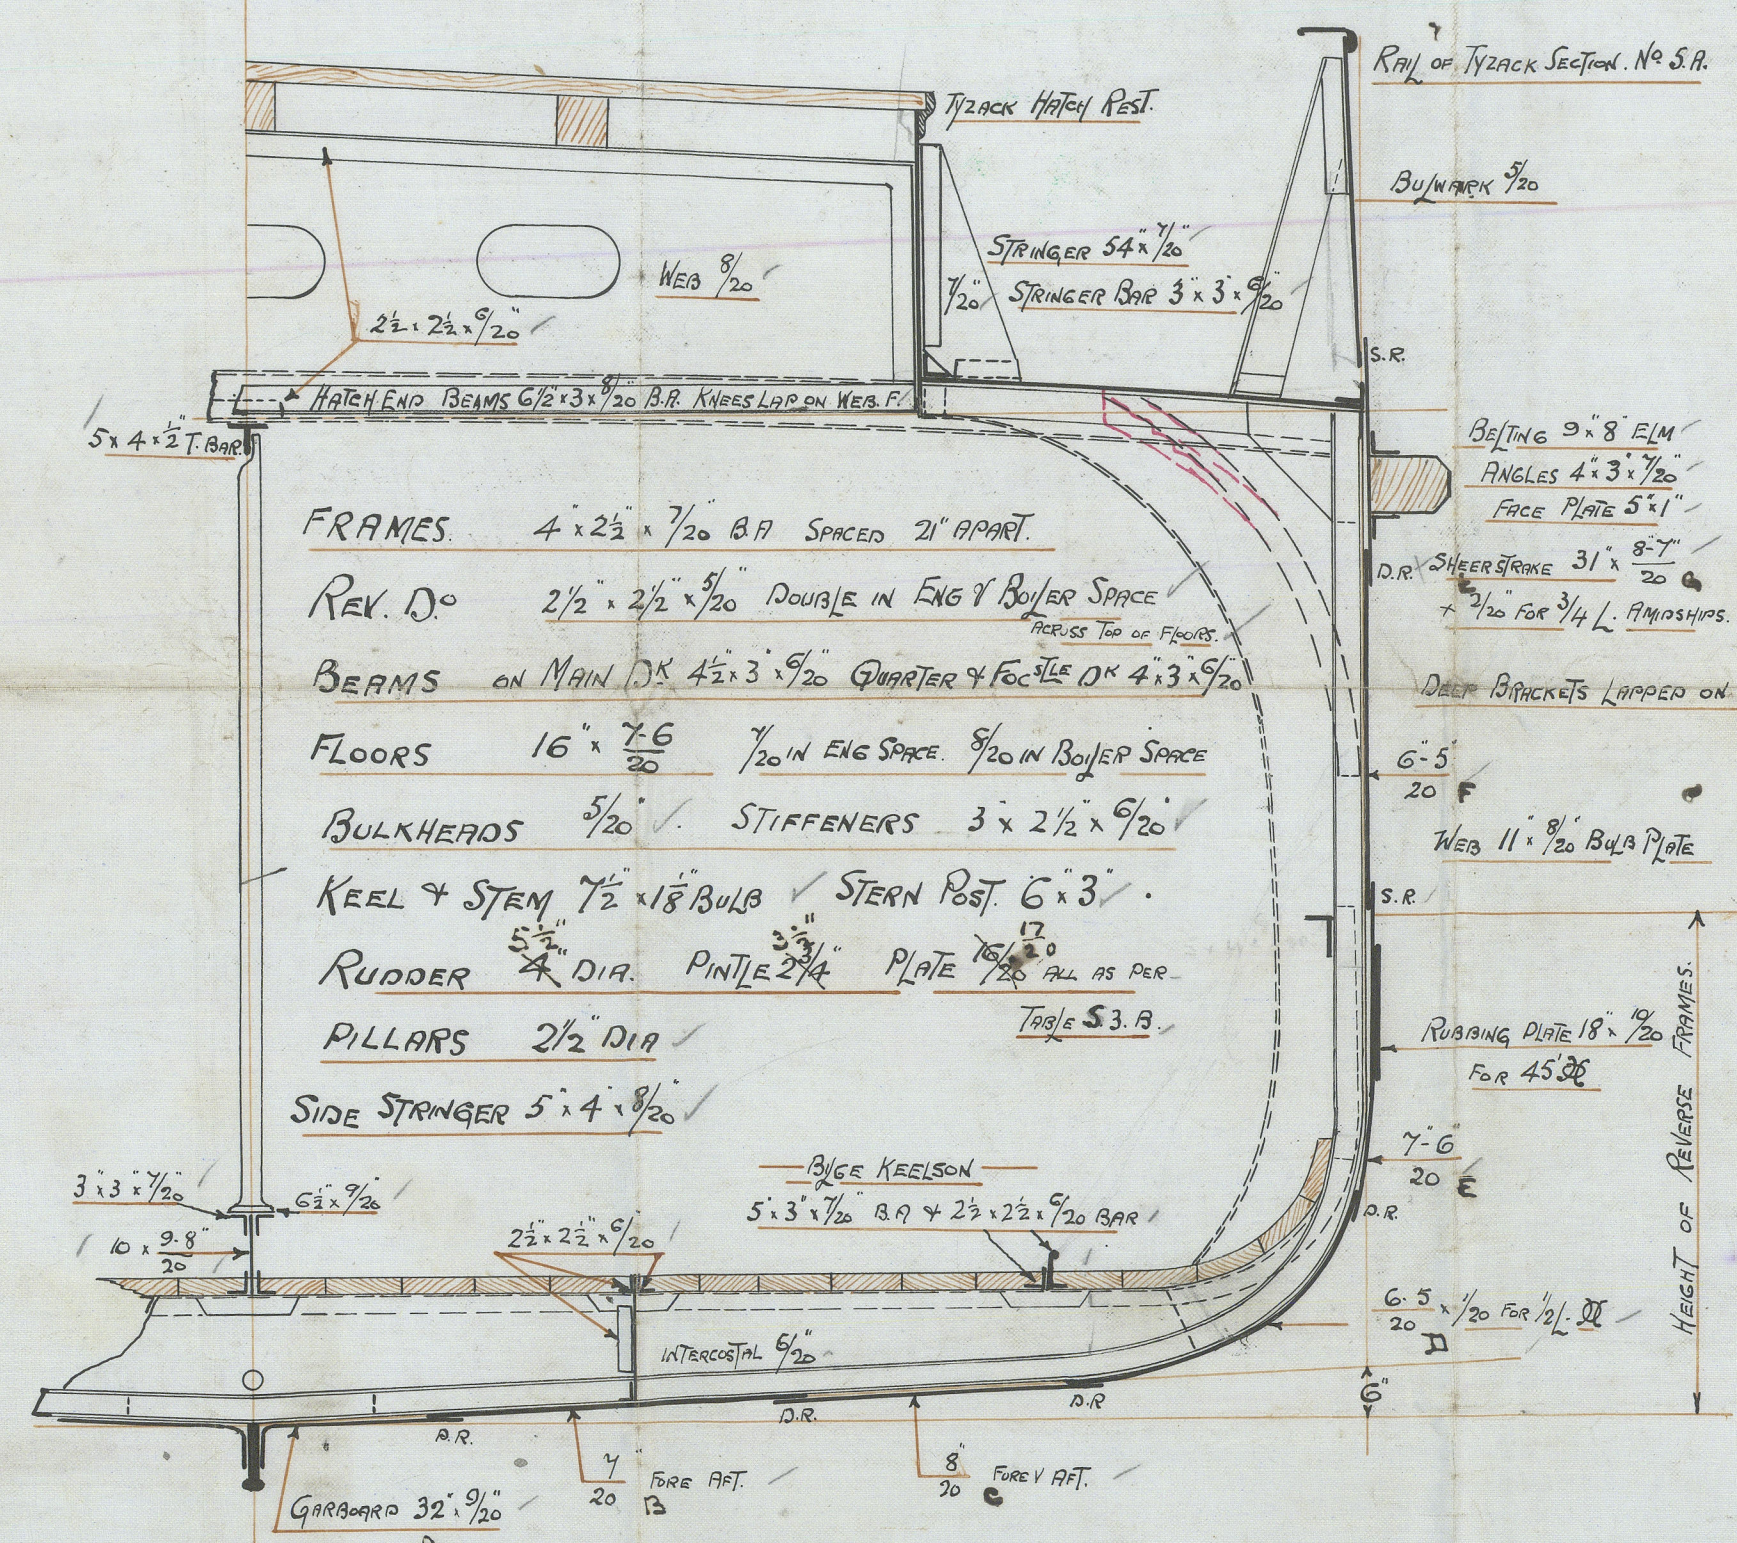

NUMERALS

1/2 GIRTH 20.5

1/2 BREADTH 11.5

DEPTH 10.06

42.06 1ST NUMBER

LENGTH PER RULE 134.

5756.6 2ND NUMBER

627.74

6384.34 EQUIPMENT No

PROPORTIONS

DEPTH TO LENGTH 12.23

BREADTH " 5.82

R. Q. D^K 47.25 x 3.5 x 2 330.75

BRIDGE D^K 10.5 x 7.25 x 1.5 114.18

FOCUS^{LE} D^K 18.75 x 6.5 x 1.5 182.81

627.74

No 6384 EQUIPMENT

2 BOWERS EACH 8 1/4 CWT STOCKLESS

1. STREAM 2 3/4 "

1. KEDGE 1 "

165 FATHOMS 15/16 STD CHAIN CABLE

45 " 10/16 CHAIN OR 2 1/4 STEEL WIRE

75 " 2 1/2 STEEL WIRE OR 7" HEMP

90 " 5" HANSE

Cochrane & Sons

No. 452.

Amended.

Midship Section.

S/S Shotton

Hull Report No. 21.300

"Totyisland"

Springland

N.N. Christina Dawn

RETAIN



© 2020

Lloyd's Register
Foundation