

Coast Guard
No. 425
Cunningham
5.2.09

5.2.09

PROFILE & DECK PLAN


STEEL SCREW STEAMER

DIMS 135'-0" x 23'-0" x 10'-6" M^{LD}


N^o 452

SCALE 1/4" = ONE FOOT.

PLAN No. 8218
FOR ENCLOSURE TO
H.M.S. SURVEYORS
FROM
COCHRANE & SONS,
SHIPBUILDERS, SE
DATE Feb 3rd 09. R.R.

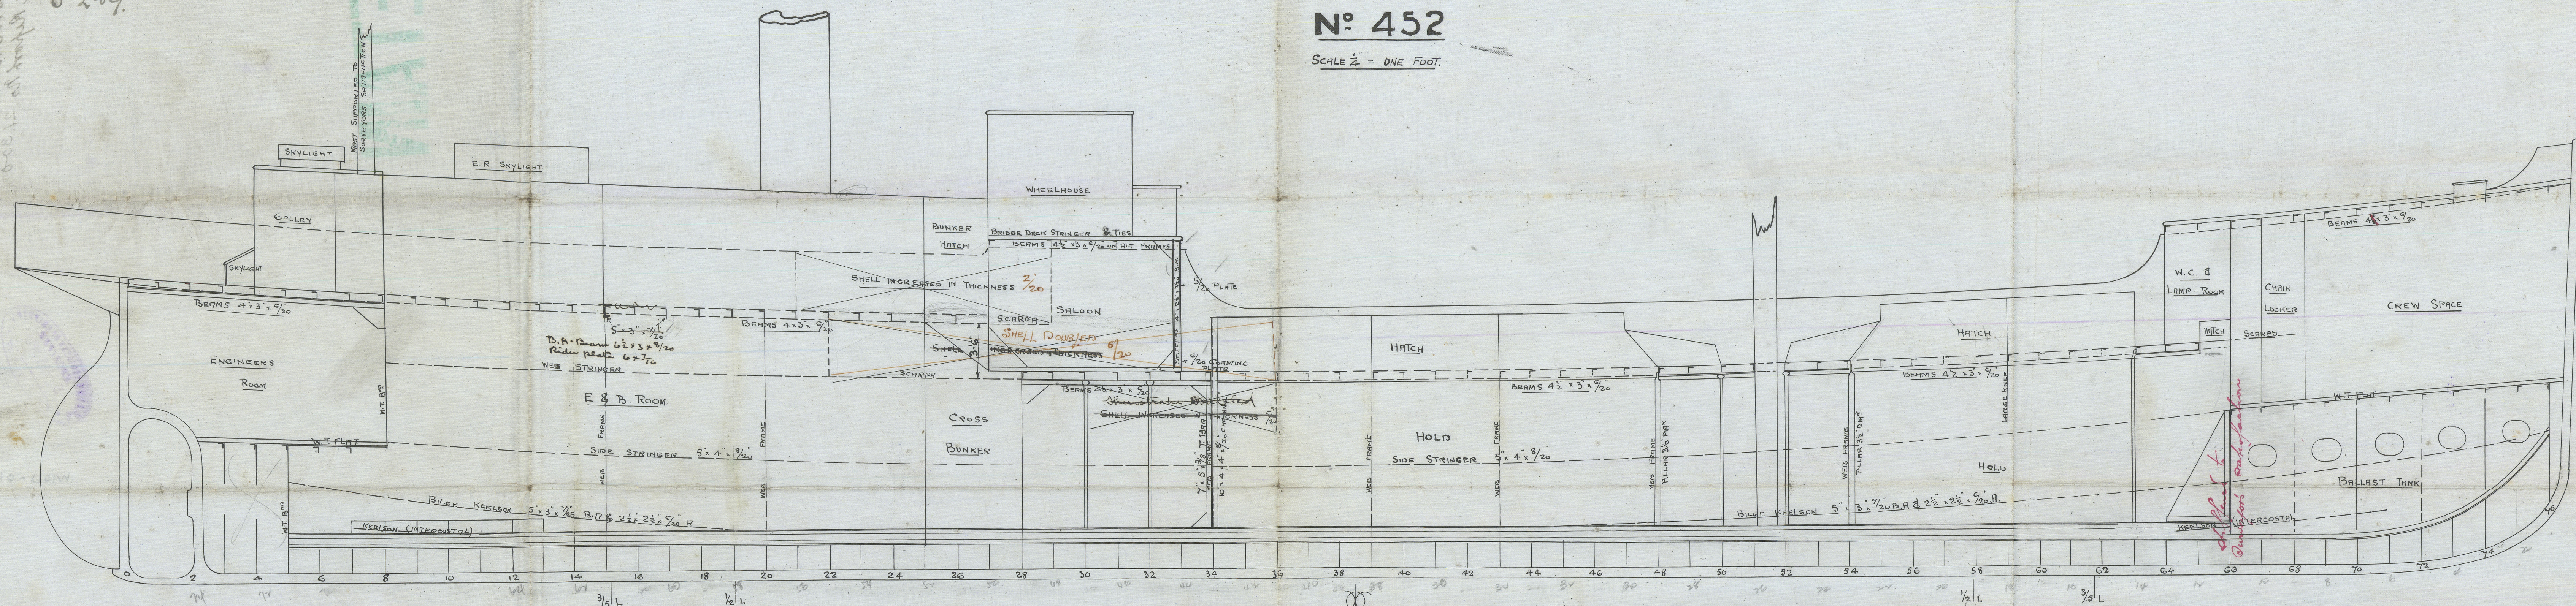

PILLARS THROUGHOUT TO SURVEYORS SATISFACTION.

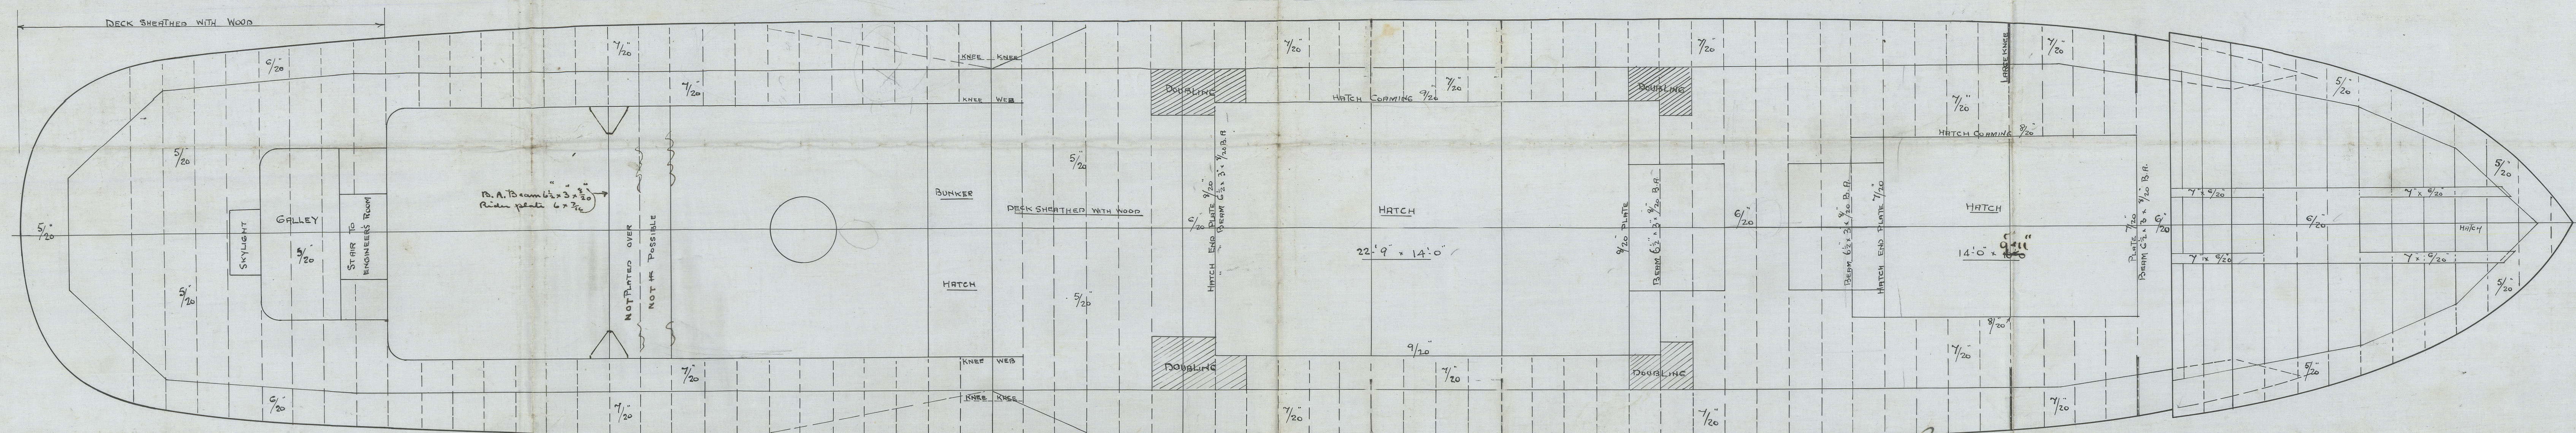

C.B.
5.2.09.

Cochrane & Sons

Nº 452.

Amended.

Profile & Deck Plan.

Christina Dawn
s/s Shotton ex
Hull Report No. 21.300

SS10-SS10M

SS10-SS10M

RETAIN



© 2020

Lloyd's Register
Foundation