

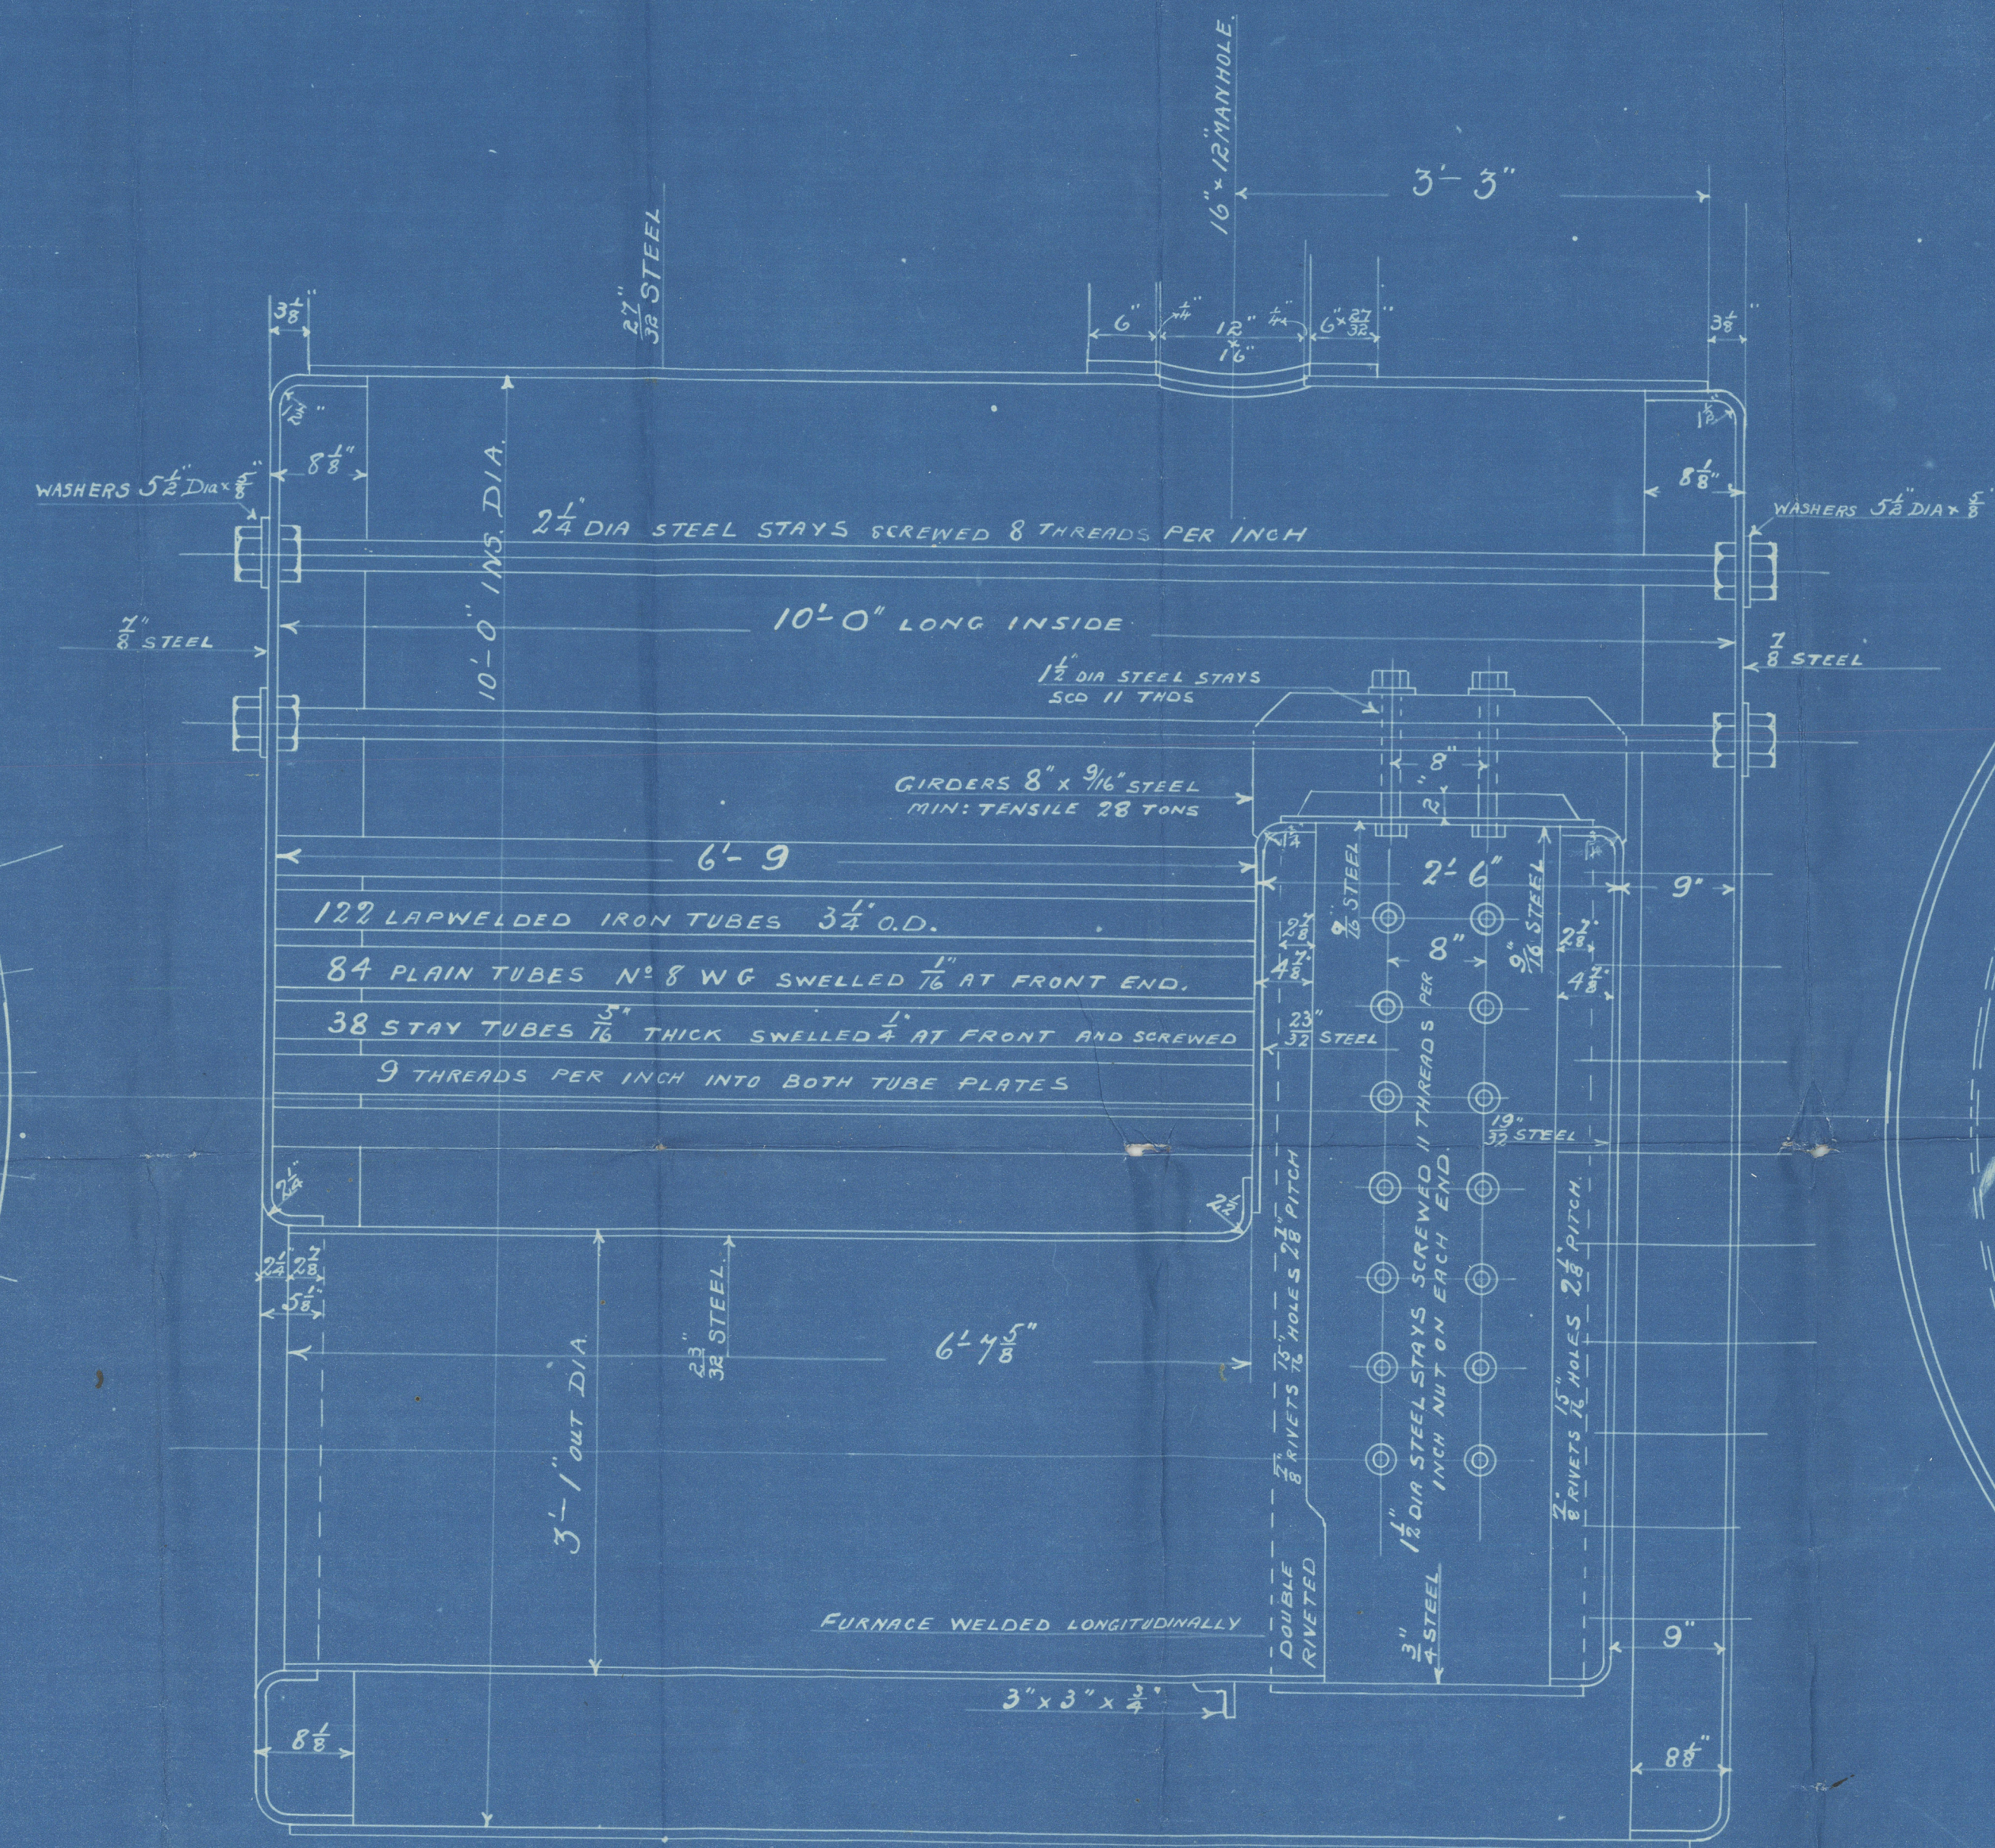


15/2/15

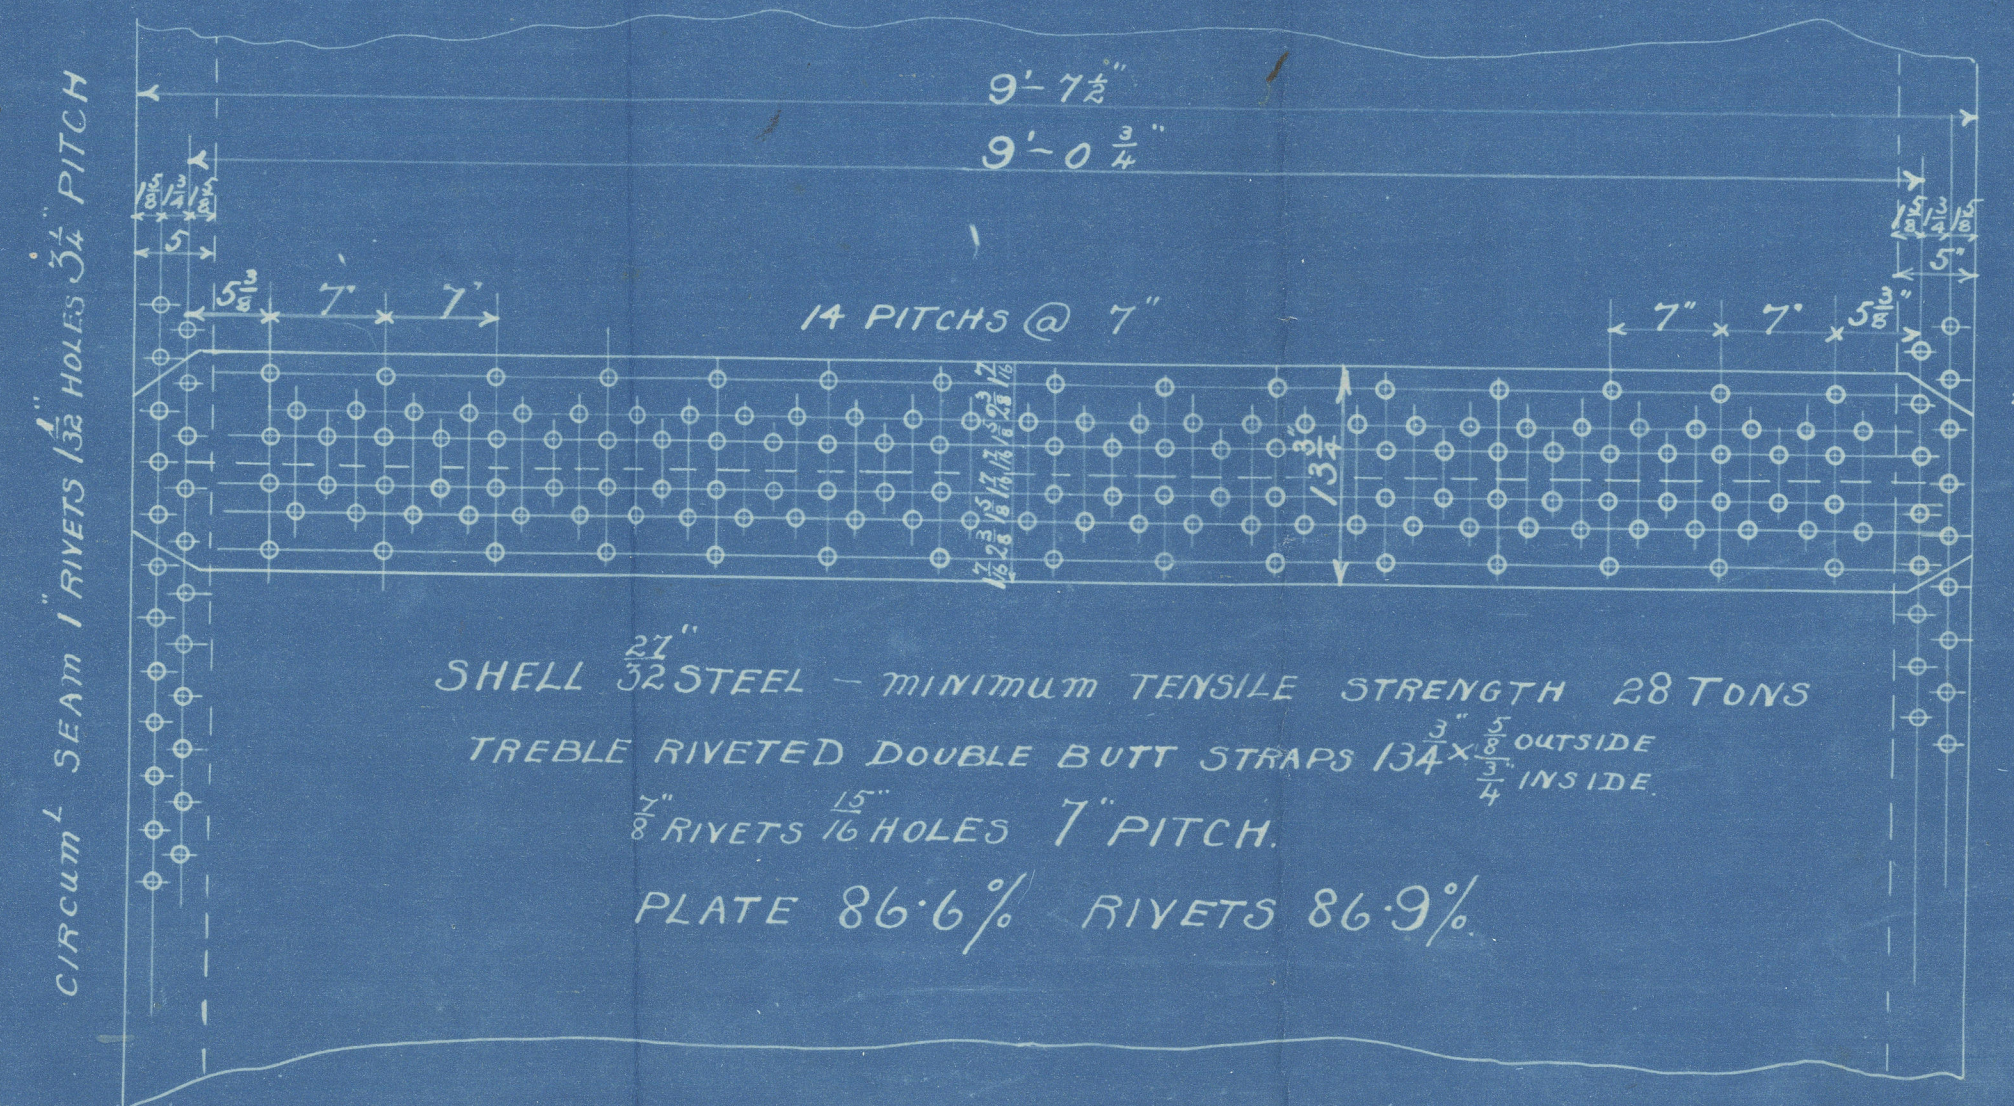

2 MARINE BOILERS

10'-0" DIA x 10'-0" LONG FOR 180 LBS. W.P.
UNDER LLOYDS SURVEY.
SCALE 1" = 1 FOOT

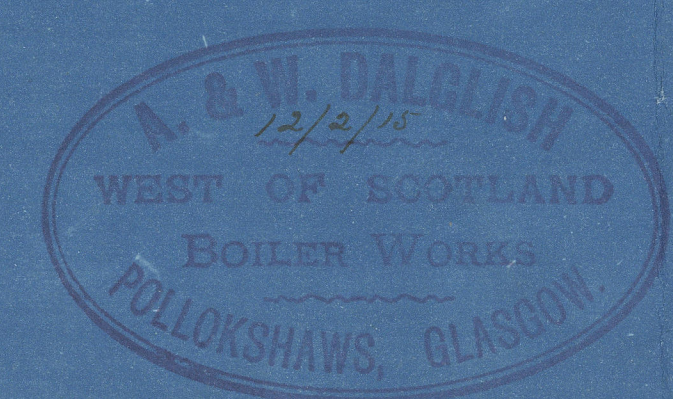

HEATING SURFACE IN TUBES =	700 ^{sq} ft
" " " FURNACES	66 ^{sq} ft
" " " CHAMBERS	129 ^{sq} ft
TOTAL =	895 ^{sq} ft
GRATE AREA 5'-6" (IN TWO LENGTHS)	32.5 ^{sq} ft
RATIO G.A. TO H.S.	1:27.5
AREA THRO TUBES =	799 ^{sq} ft

Handwritten signature and date 15.2.15

Nº 671-2



W1015-0202

2 Marine Boilers

10'-0" dia x 10'-0" for 180 lbs wt.

N^o 671 & 672

Glasgow Report N^o 38199
3/5 Col with Force

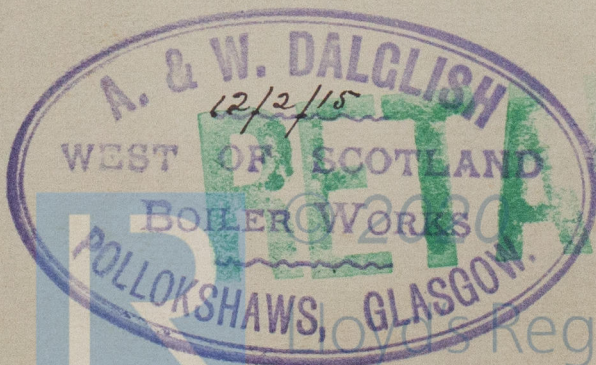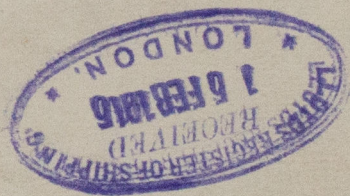

Ships Register
Foundation