






15  
Midship Section. S. S. N° 229-230

R. WILLIAMSON & SON,



WORKINGTON

W101S-0203

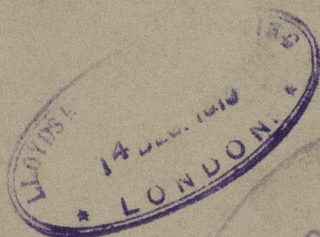


See Midship as built.  
Section " "

Colwith Force.  
Brow No. 1739.

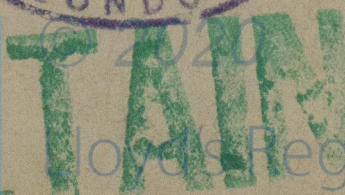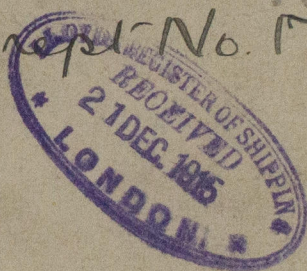

Lloyd's Register  
Foundation

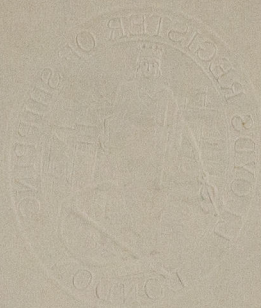

*Colin H. Jones*

W1015-0203



© 2020

Lloyd's Register  
Foundation