


21.11.12

LONGITUDINAL SECTION & DECK PLANS  
STEEL SINGLE SCREW STEAMER No 281

MOULDED DIMENSIONS 225'8" x 34'0" x 20'0" TO UPPER D<sup>o</sup>

SCALE 1/8" = 1 FOOT


TO CLASS 100 A 1 AT LLOYDS

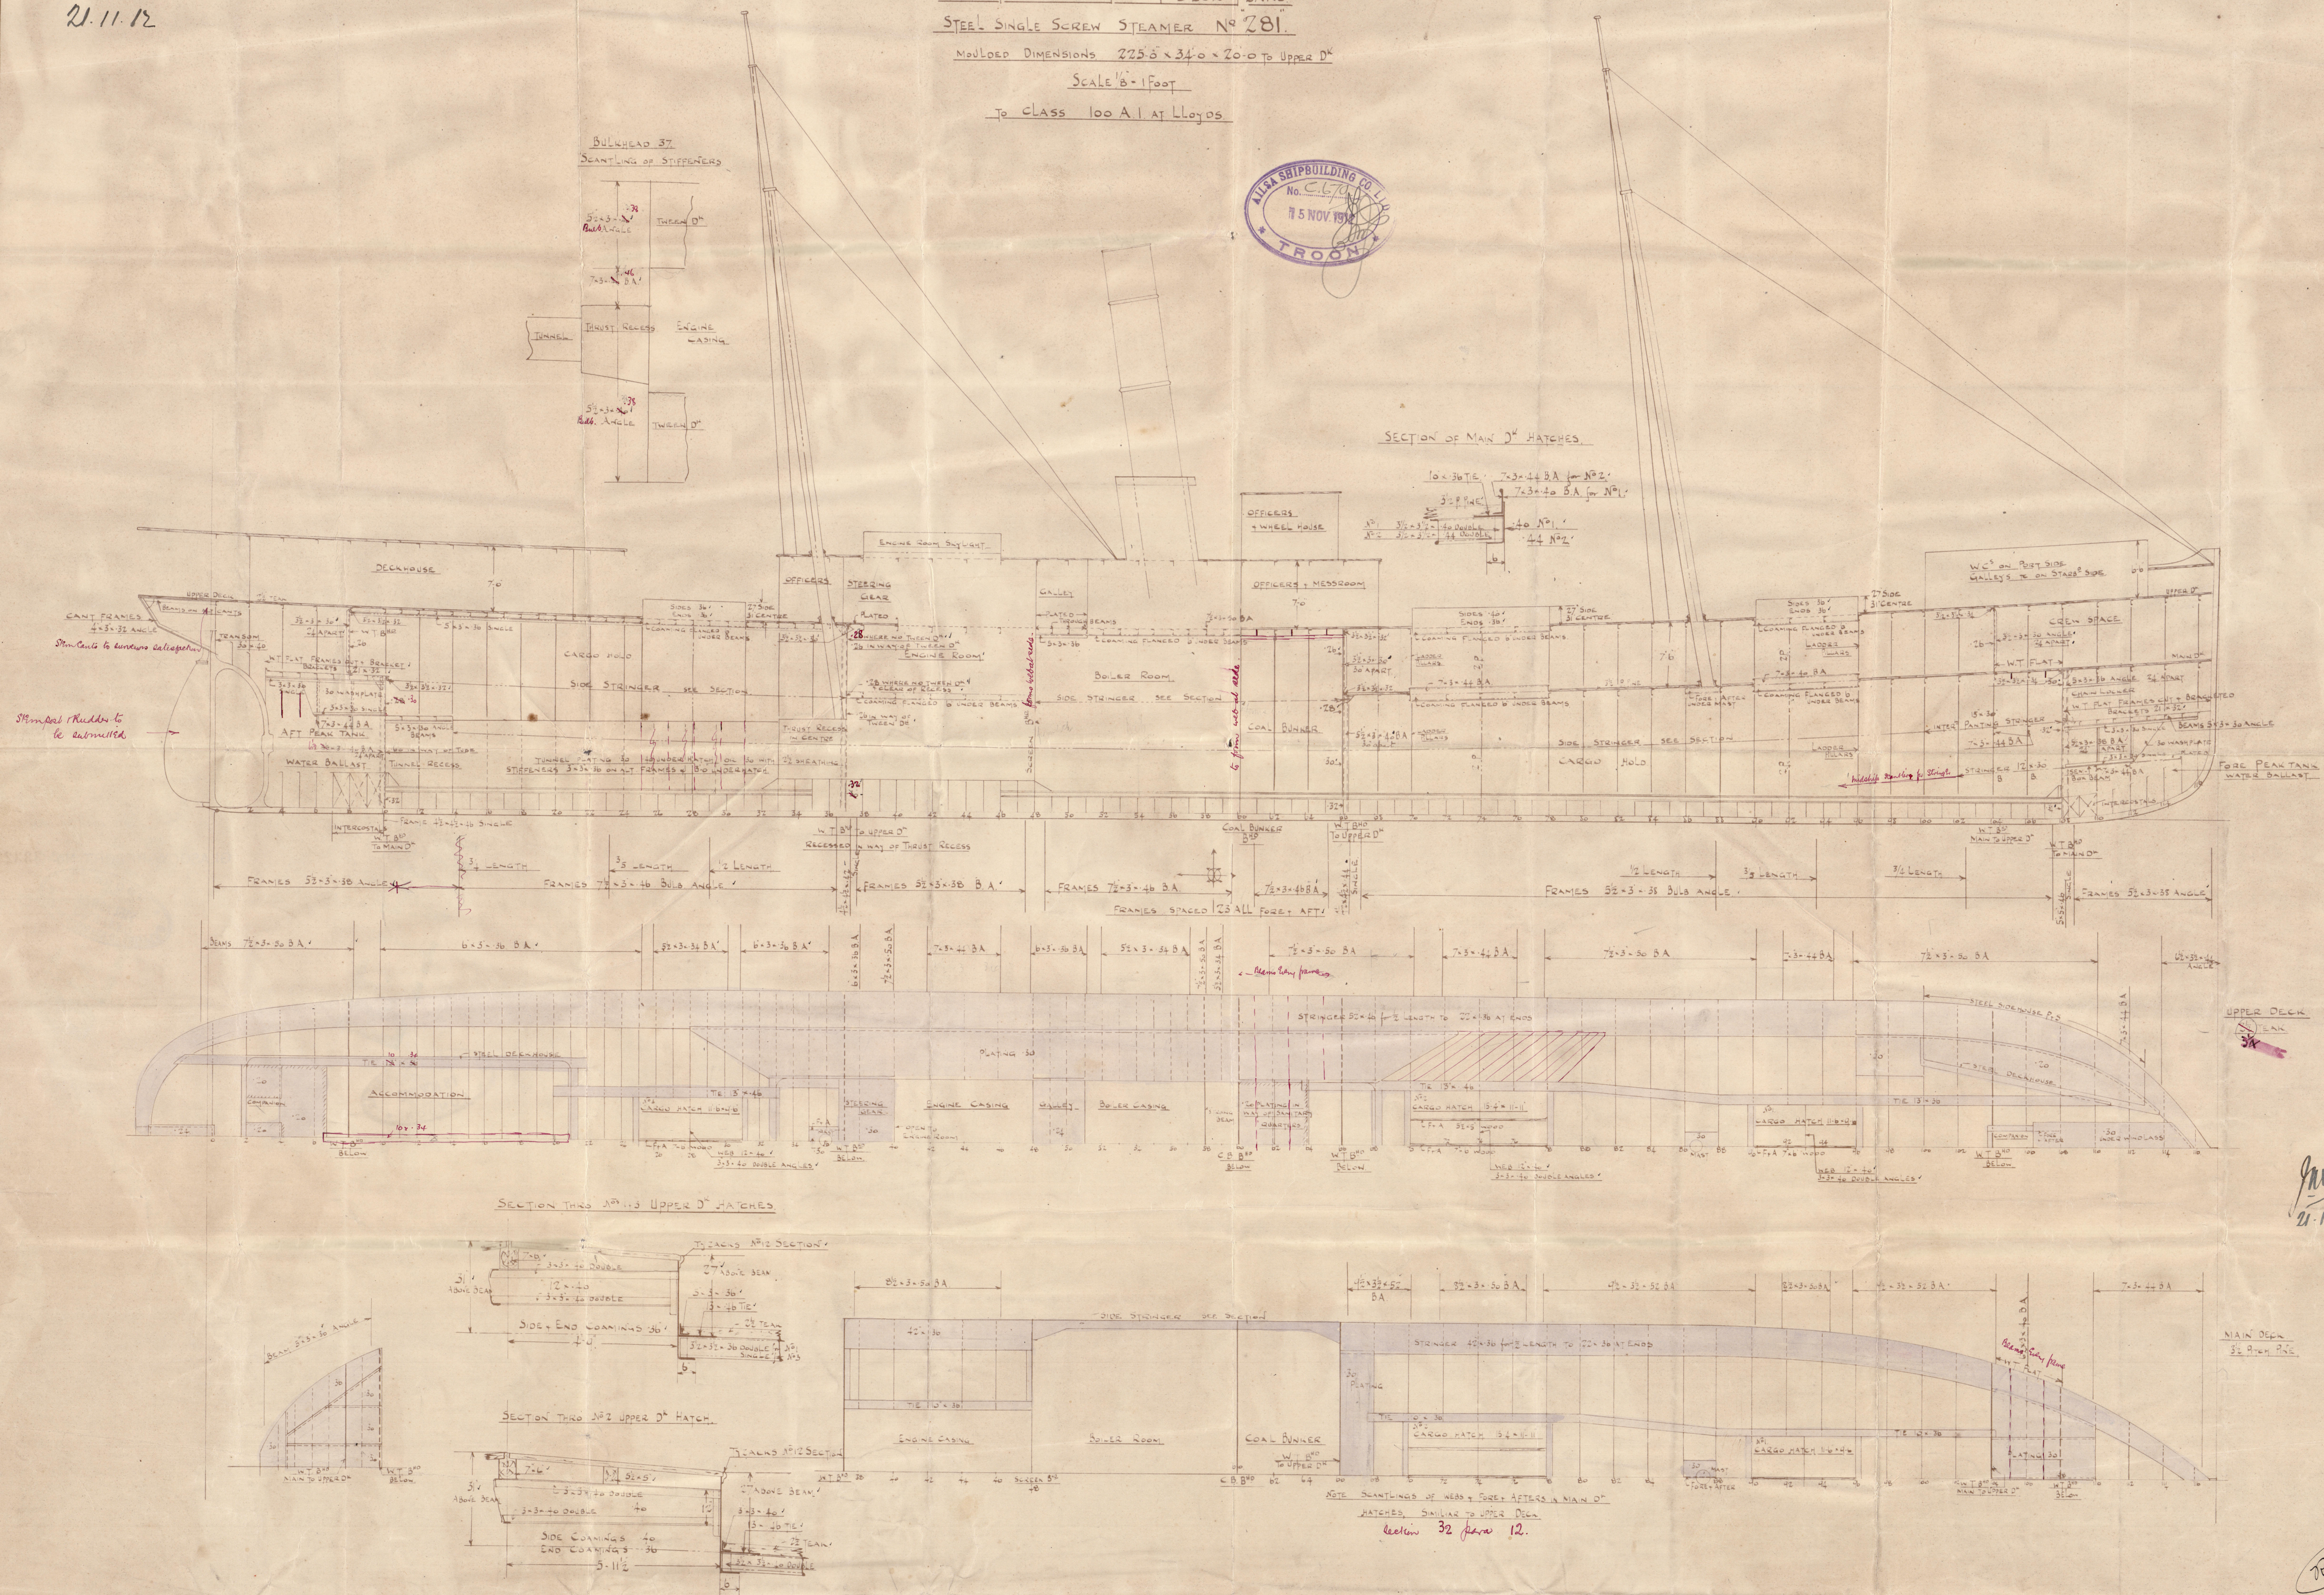

J.M.  
21.11.12




Profile & Deck  
Ailsa Ship. Coys  
No 281

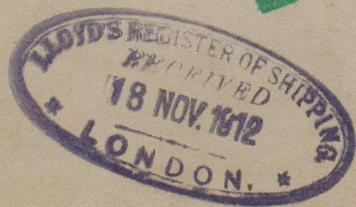

*5/5 "Irrawadi"*

GLASGOW REPORT No 33322

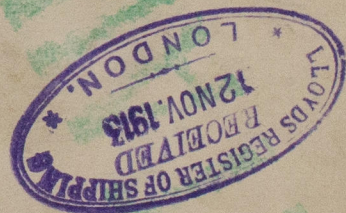

© 2019

Lloyd's Register  
Foundation