

2 BOILERS FOR N^o 442.

SCALE 1" = 1 FOOT.

mm 30/12/12
S. J.
1. 1. 13.




© 2019
Lloyd's Register
Foundation
W1017-0235 2/6

Demonui Jackson
Boiler No ⁴⁴²~~422~~ WP200



Atka St Co 281...

Bombay Steam
Navigation Co Ltd.

S/S "Inrawadi"

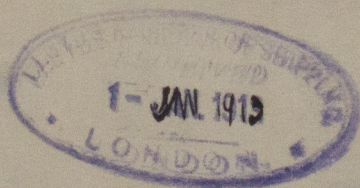

GLASGOW REPORT No. 33322

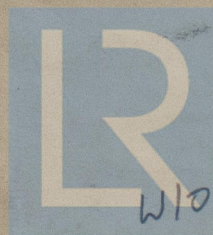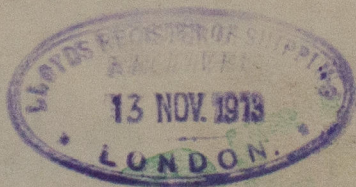

© 2019

Lloyd's Register
Foundation

W1017-0235

FROM
DUNSMUIR & JACKSON, Ltd.
FOR ENCLOSURE TO

Lloyd's Register
28-72-73
.....
.....
Foundation
W1017-0238 1/2