

THIS DRAWING IS THE PROPERTY OF
THE BABCOCK & WILCOX CO.
NEW YORK
MARINE TYPE BOILER PATENTED
FRONT VIEW
SCALE 1/4" = 1 FT. DATE NOVEMBER 10, 1918
SHEET 1 OF 1
FILE 1115763- M 5-631-234

APPROVED
LLOYD'S REGISTER OF SHIPBUILDERS
APR 5 1919
NEW YORK

Texas Co. Hulls
21-74

LS1019-0034

APPROVED




Texas Co. Hulls

21-724

✓

July 14

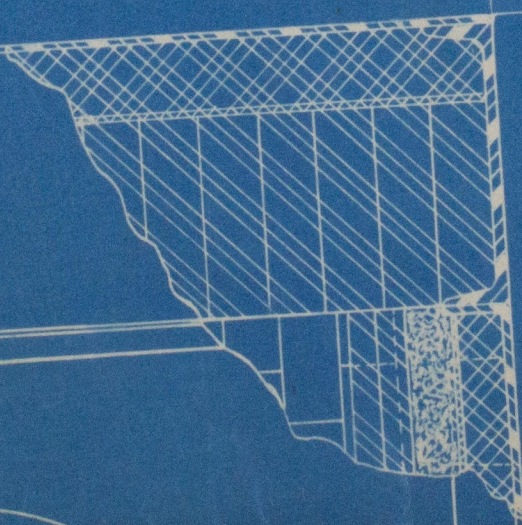

LR

© 2020

Lloyd's Register
Foundation