


# DECK PLANS. S.S. SANDOWN CASTLE.

DIMS: LENGTH 425'-0" B.P. BTH. MLD. 56'-0" DTH. MLD. 30'-7 1/2".

SCALE 1/8" = 1 FOOT.

 

SHORT BROTHERS LIMITED,  
SHIPBUILDERS,  
SUNDERLAND.



Gen examinations out  
april 1st

Back to old system  
of special survey

Bandown due for 2nd  
Special ho 3 - 6 months  
grace.

1st time home after april  
due for 2nd ho 3

---

Indented plating P. Side ho 2  
Hold (Port)

Permanent repairs + test  
of OR Deep tanks

Pum repairs ho 6 hold shut  
after fire.

Shell plating framing +  
web plates Port side ahead  
ER Bridge

Bow anchor - 60 fathoms  
of cable supply




© 2020

Lloyd's Register  
Foundation




DETAIN

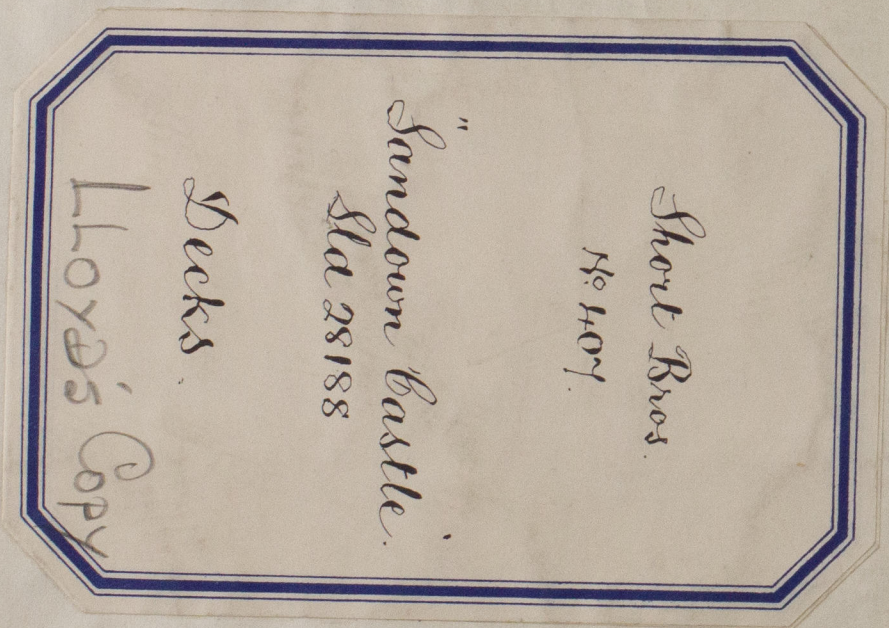


"SANDOWN CASTLE"  
DECK PLANS

HELTER DECK

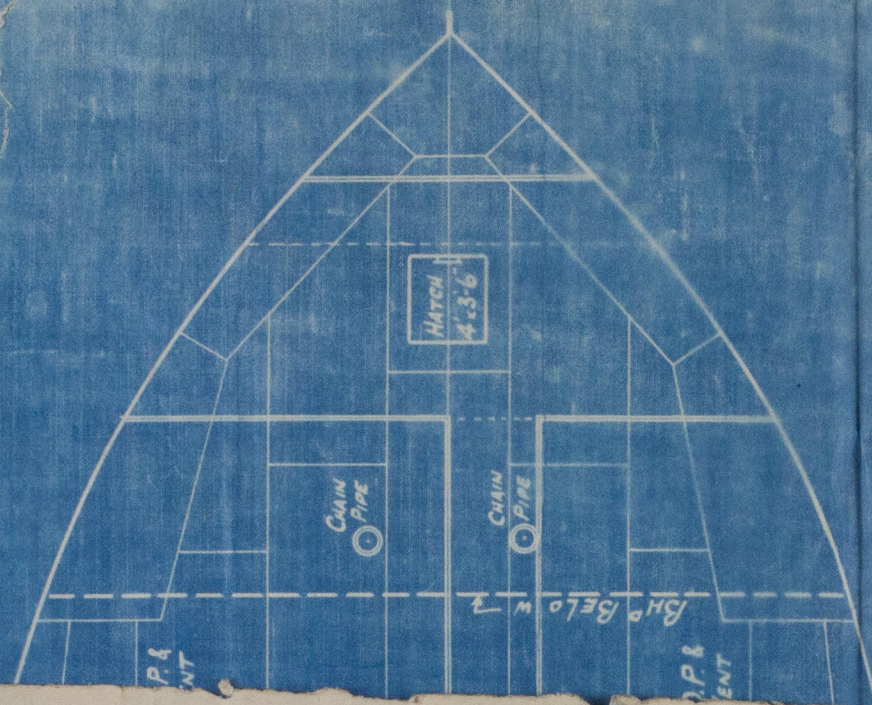

UPPER DECK

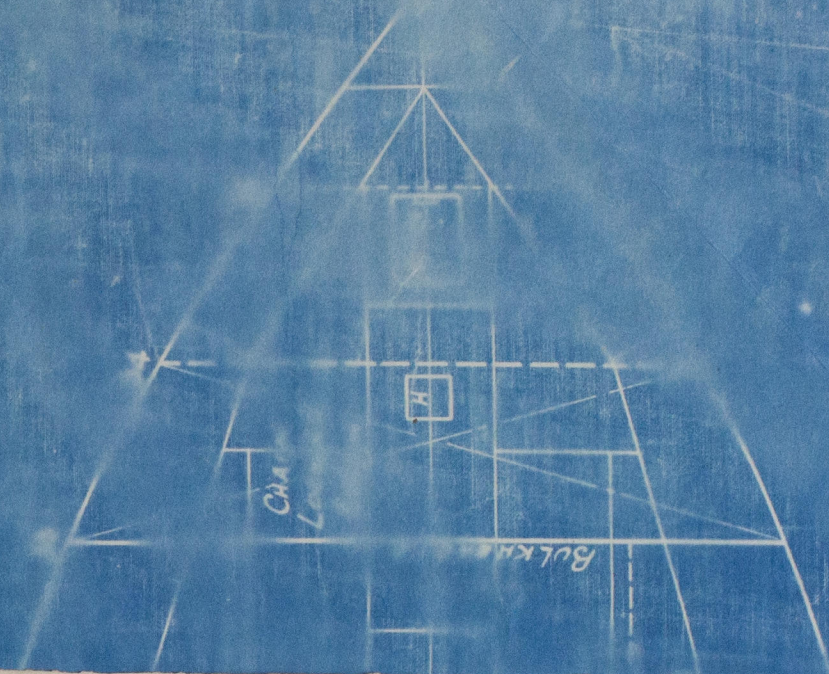

SHORT BROTHERS LIMITED.

SHIPBUILDERS.

SUNDERLAND.

L1019-0057



© 2020

Lloyd's Register  
Foundation

L1019-0057