

SYMBOL NO.		DESCRIPTION.	MAT.	REMARKS.	REQ. FOR			
WORK?	SPACE				EACH			
9G1-5	Z9G1-5	WHEEL SHAFT COUPLING BOLTS	MS.	STOCK PART TENSILE 32-38 TONS	18	1		
-6		NUTS FOR " "	MS	STOCK BAR	18	1		
10G1-1		THRUST SHAFT	S.M.F.F. INGR.	ORDERED 32-32 TONS OUTSIDE TENSILE	1			
-2		COUPLING PIECE.	" "	" "	1			
-3		NUT FOR THRUST SHAFT.	MS.	ORDERED OUTSIDE.	1			
-4		KEY " "	S.M.F.F.	ORDERED 32-32 TONS INSTEAD OUTSIDE TENSILE	1			
-100		BOLTS, SCREWS ETC.	MS.	STOCK MATERIAL	1			

N ^o .	DATE.
1548	26-11-36 <i>26</i>

4557.

LLOYD'S SURVEY

THRUST SHAFT & CONE COUPLING

SCALE :- 1:5 & AS MARKED.

318
SWAN, HUNTER, & WIGHAM
RICHARDSON LTD.

TURBINE ENGINE NO. 1548.

Gray's - W. Hartlepool - No 1076.

Central Mar. Eng. Works No 1076


Thrust Shaft + Coupling

Lindenhall.

Hpl. 17753.

(8)

Dry No 4557.

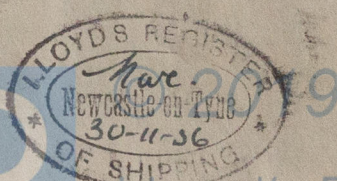

W/102-0023

Lloyd's Register
Foundation