
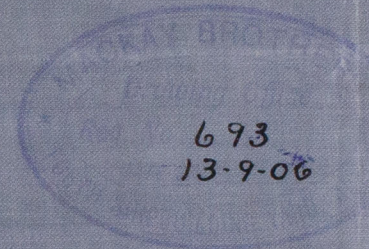


W1020-0138

18.9.06

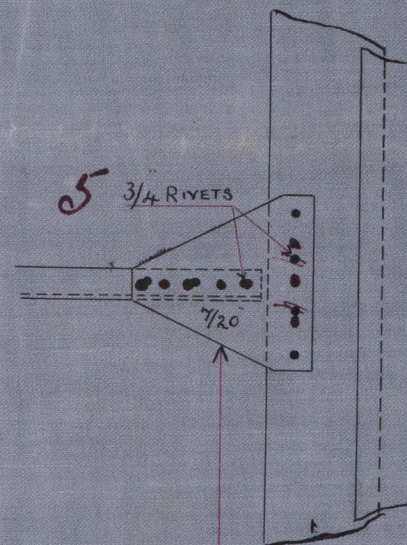

S.S. N° 6.

ALTERATION TO WIDTH OF DOUBLE BOTTOM
SKETCH SHEWING DETAIL OF COMPENSATING GUSSETS
FITTED. MARGIN PLATE BEING 10% UNDER RULE WIDTH

SCALE 1/2 IN = 1 FT.

7/20 GUSSET PLATE EVERY 5TH FRAME

12-5 1/2

MARGIN PLATE 2 1/2 x 7/20. 9/20 IN B^S SPACE
SHELL ANGLE 3 1/2 x 5 1/2 x 9/20
VERTICAL ANGLES 3 x 3 x 7/20 (9/20 IN B^S SP. INSIDE TANK)
CONNECTION 5-3/4 RIVETS IN EACH FLANGE
BUTTS DOUBLE ALL FORE & AFT.

10-0

13-2 1/2

6-9

3-4 1/2

C.B.
18.9.06.





© 2020

Lloyd's Register
Foundation

14/9/06

Ballast Tank
A. I. N^o 6
Mackay Brothers
Leith
S. S. "Allan"
Leith Ript. N^o

W1020-0138

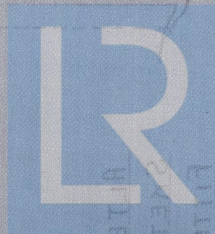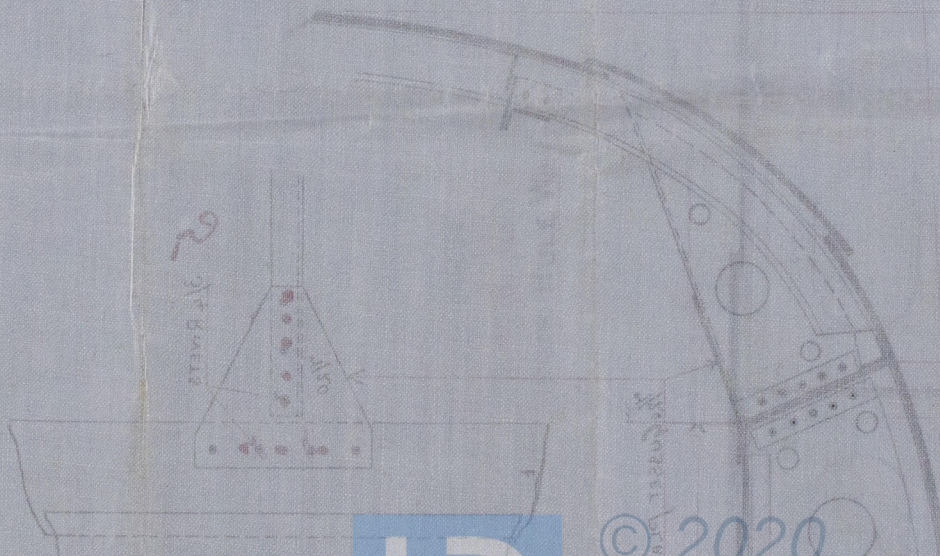

© 2020

Lloyd's Register
Foundation