

Mason Riley Bros Inc


Boiler No 5525

for

Messrs John Plummer & Co Ltd

S.S. Co

Working Press 120 lb

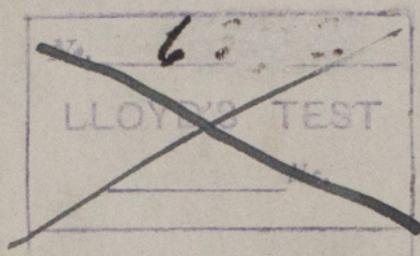

5525

6517

LLOYD'S TEST.

220 lbs.

WP 120

1-11-26. W.H.R.

Duplicate of Boiler No 5454


Indt Rpt No 11898

S.S. "Bydona"

BUNDERLAND RPT. NO. 29353

Lloyd's Register
Foundation

W1022-0070

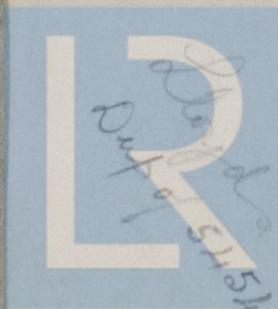

© 2020

Lloyd's Register
Foundation