


SCALE  $\frac{1}{4}" =$  ONE FOOT. —

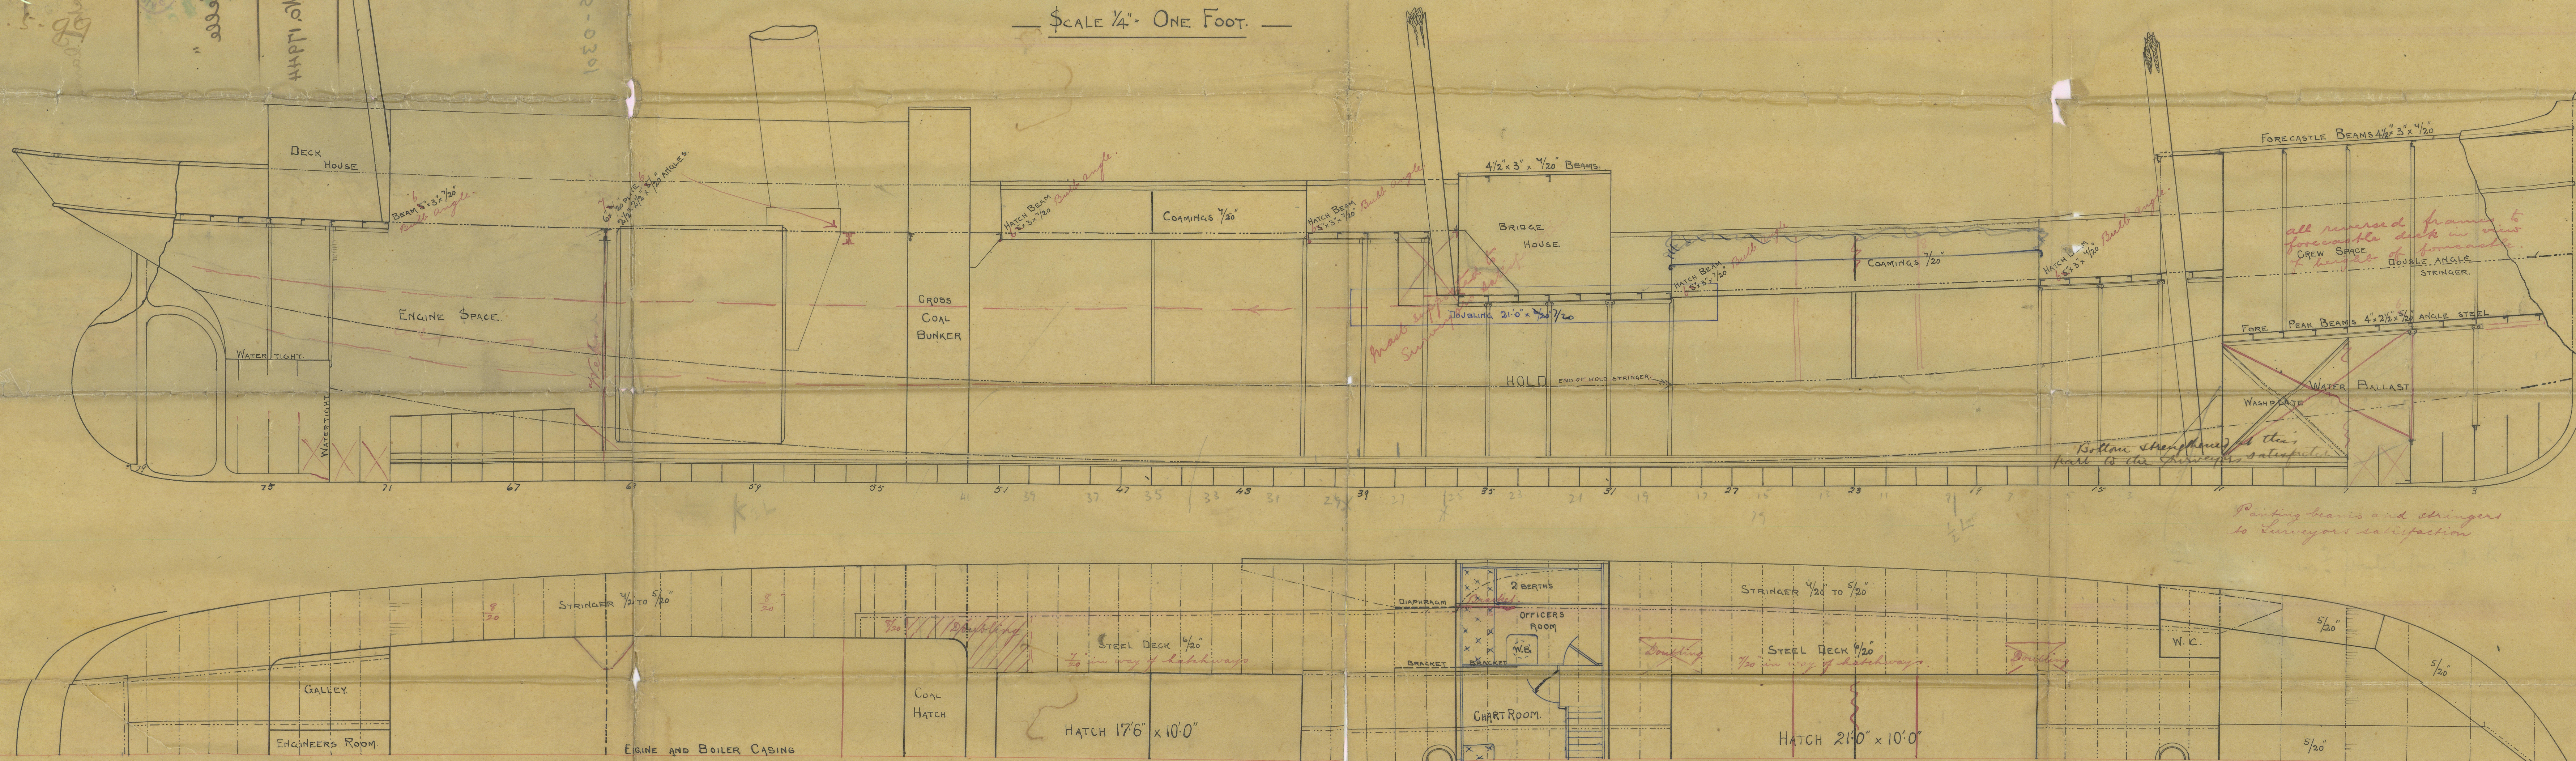




J. Gullerton & Co.

No 153

Profile & Deck Plan

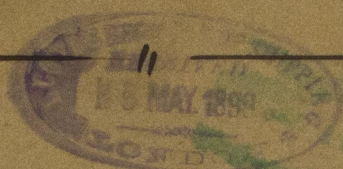

" S.S. The Lady Belle "

"  
Glasgow Report No. 17944



© 2020

Lloyd's Register  
W6025-0301  
Foundation