
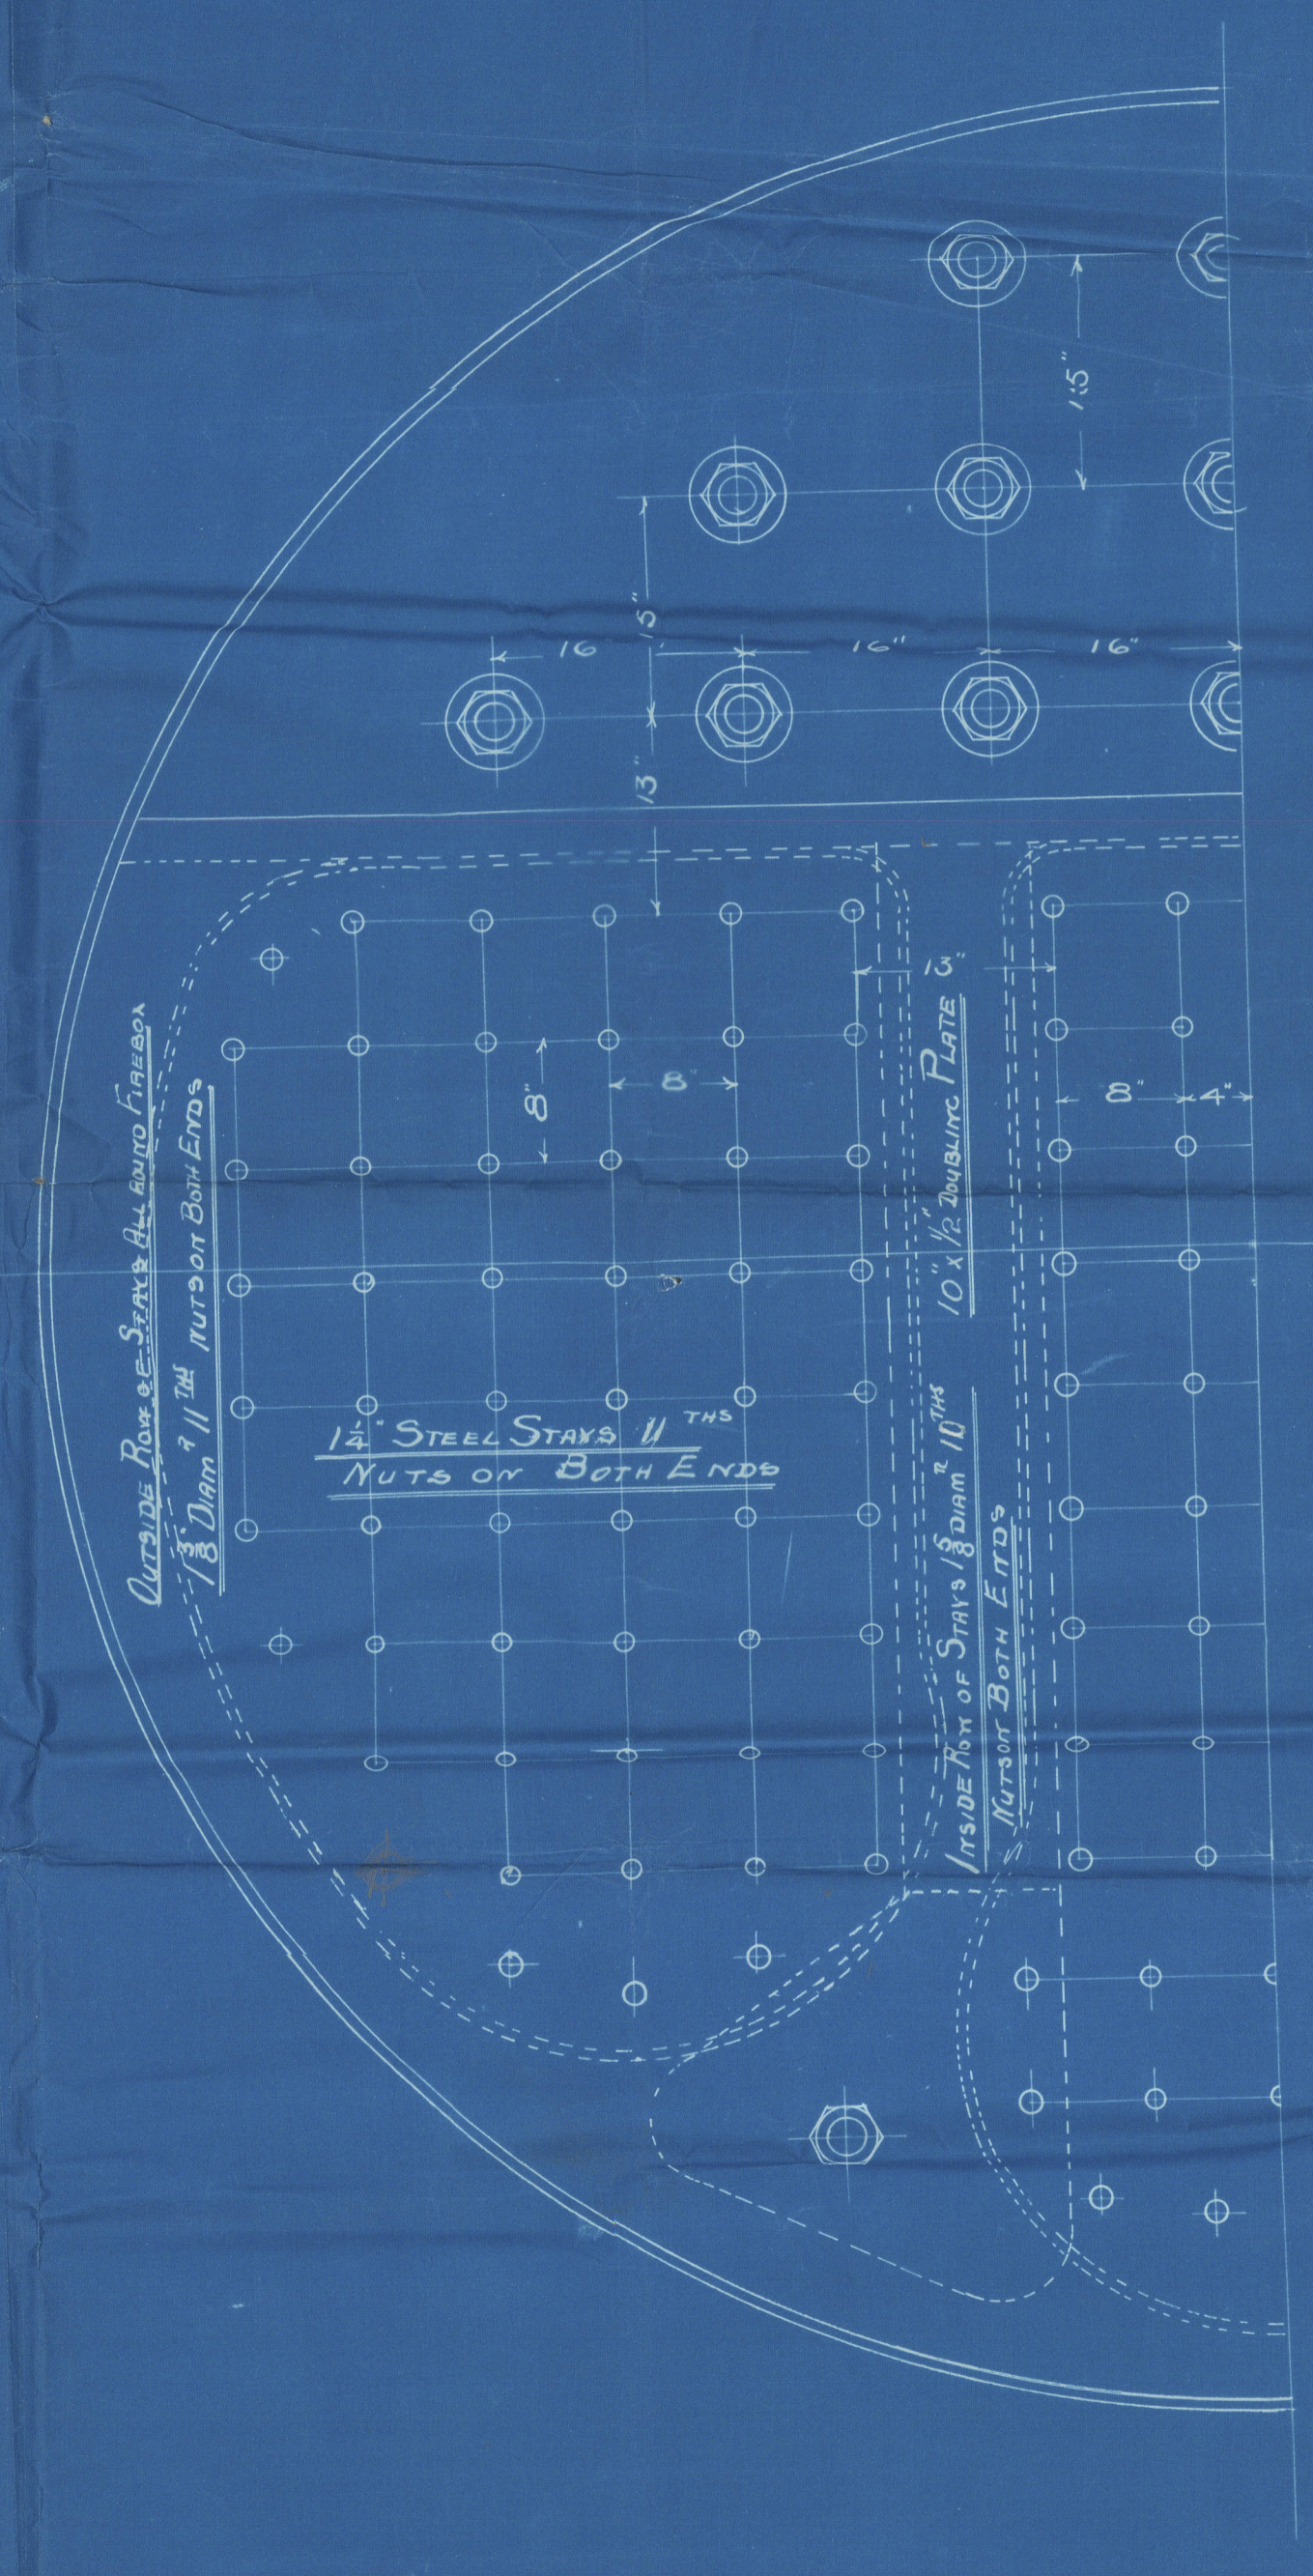
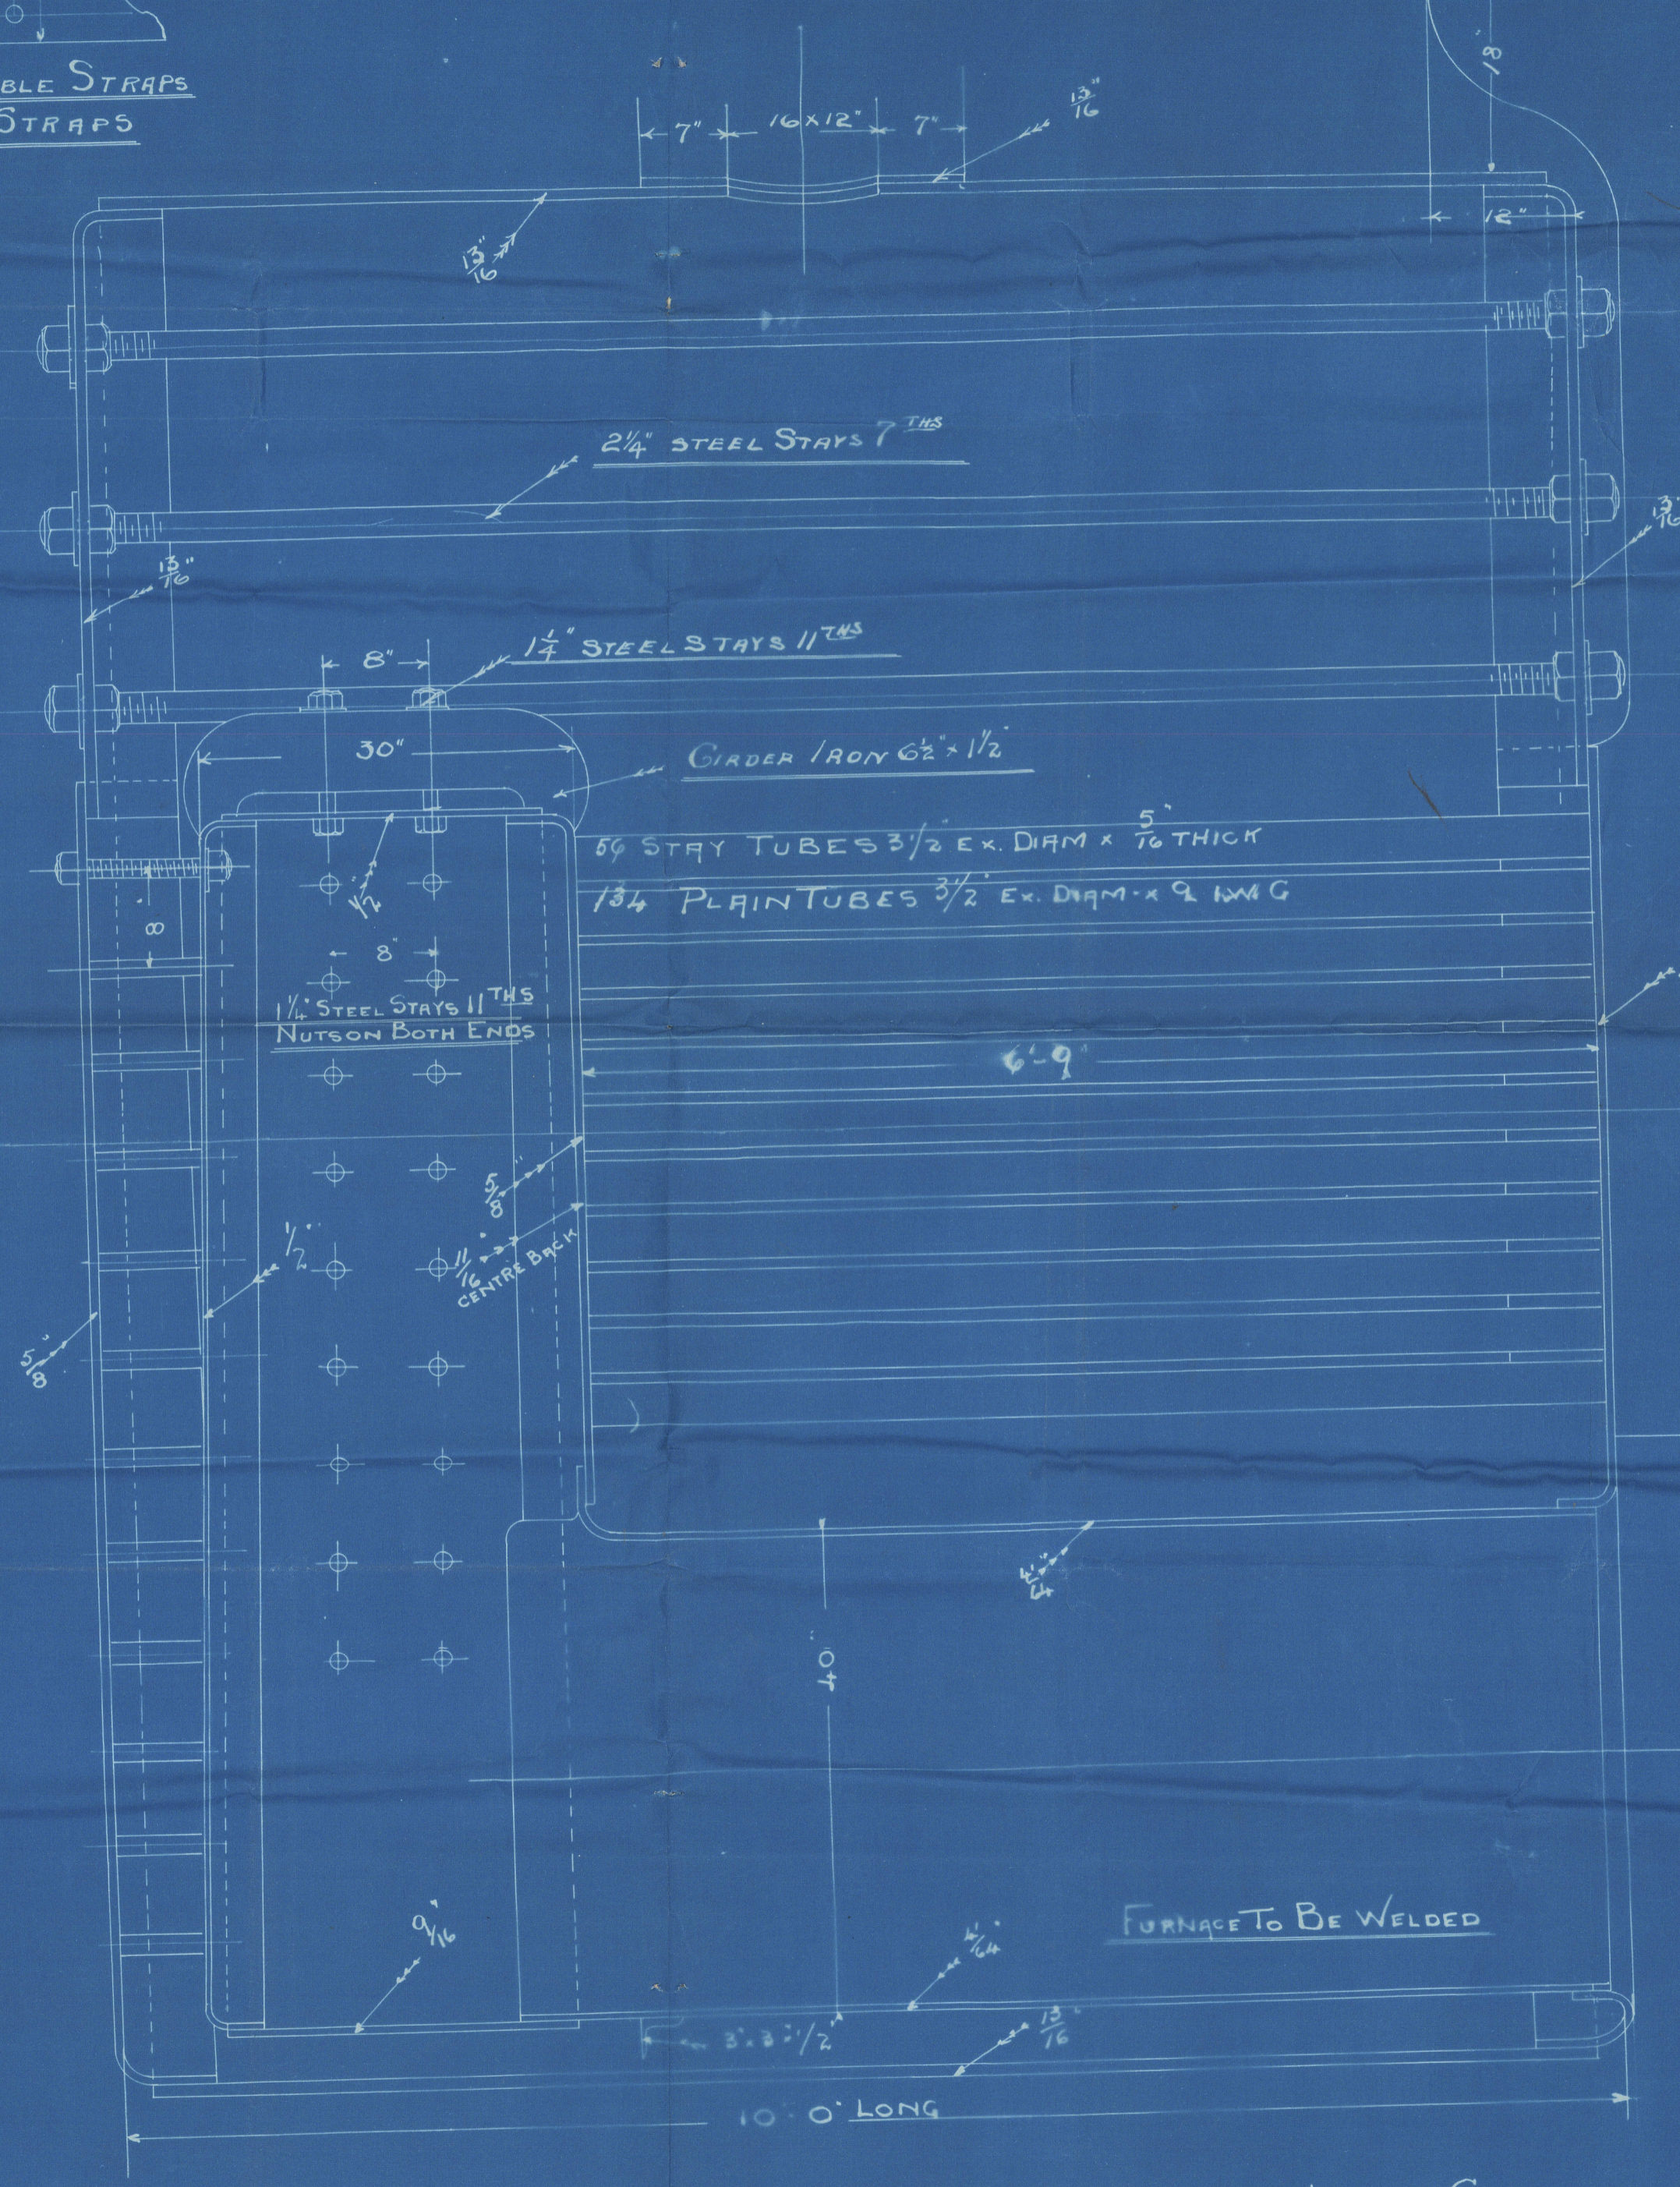


Mr. A. J.  
30.9.99

CIR. SEAMS DOUBLE RIVETED  
1" HOLES 4" PITCH 2 1/2" DIA.

STEEL PLATES BARS AND RIVETS  
ALL HOLES DRILLED IN PLACE

LONG SEAMS BUTT JOINTS DOUBLE STRAPS  
1 1/2" HOLES 4" PITCH 1 1/2" BUTT STRAPS

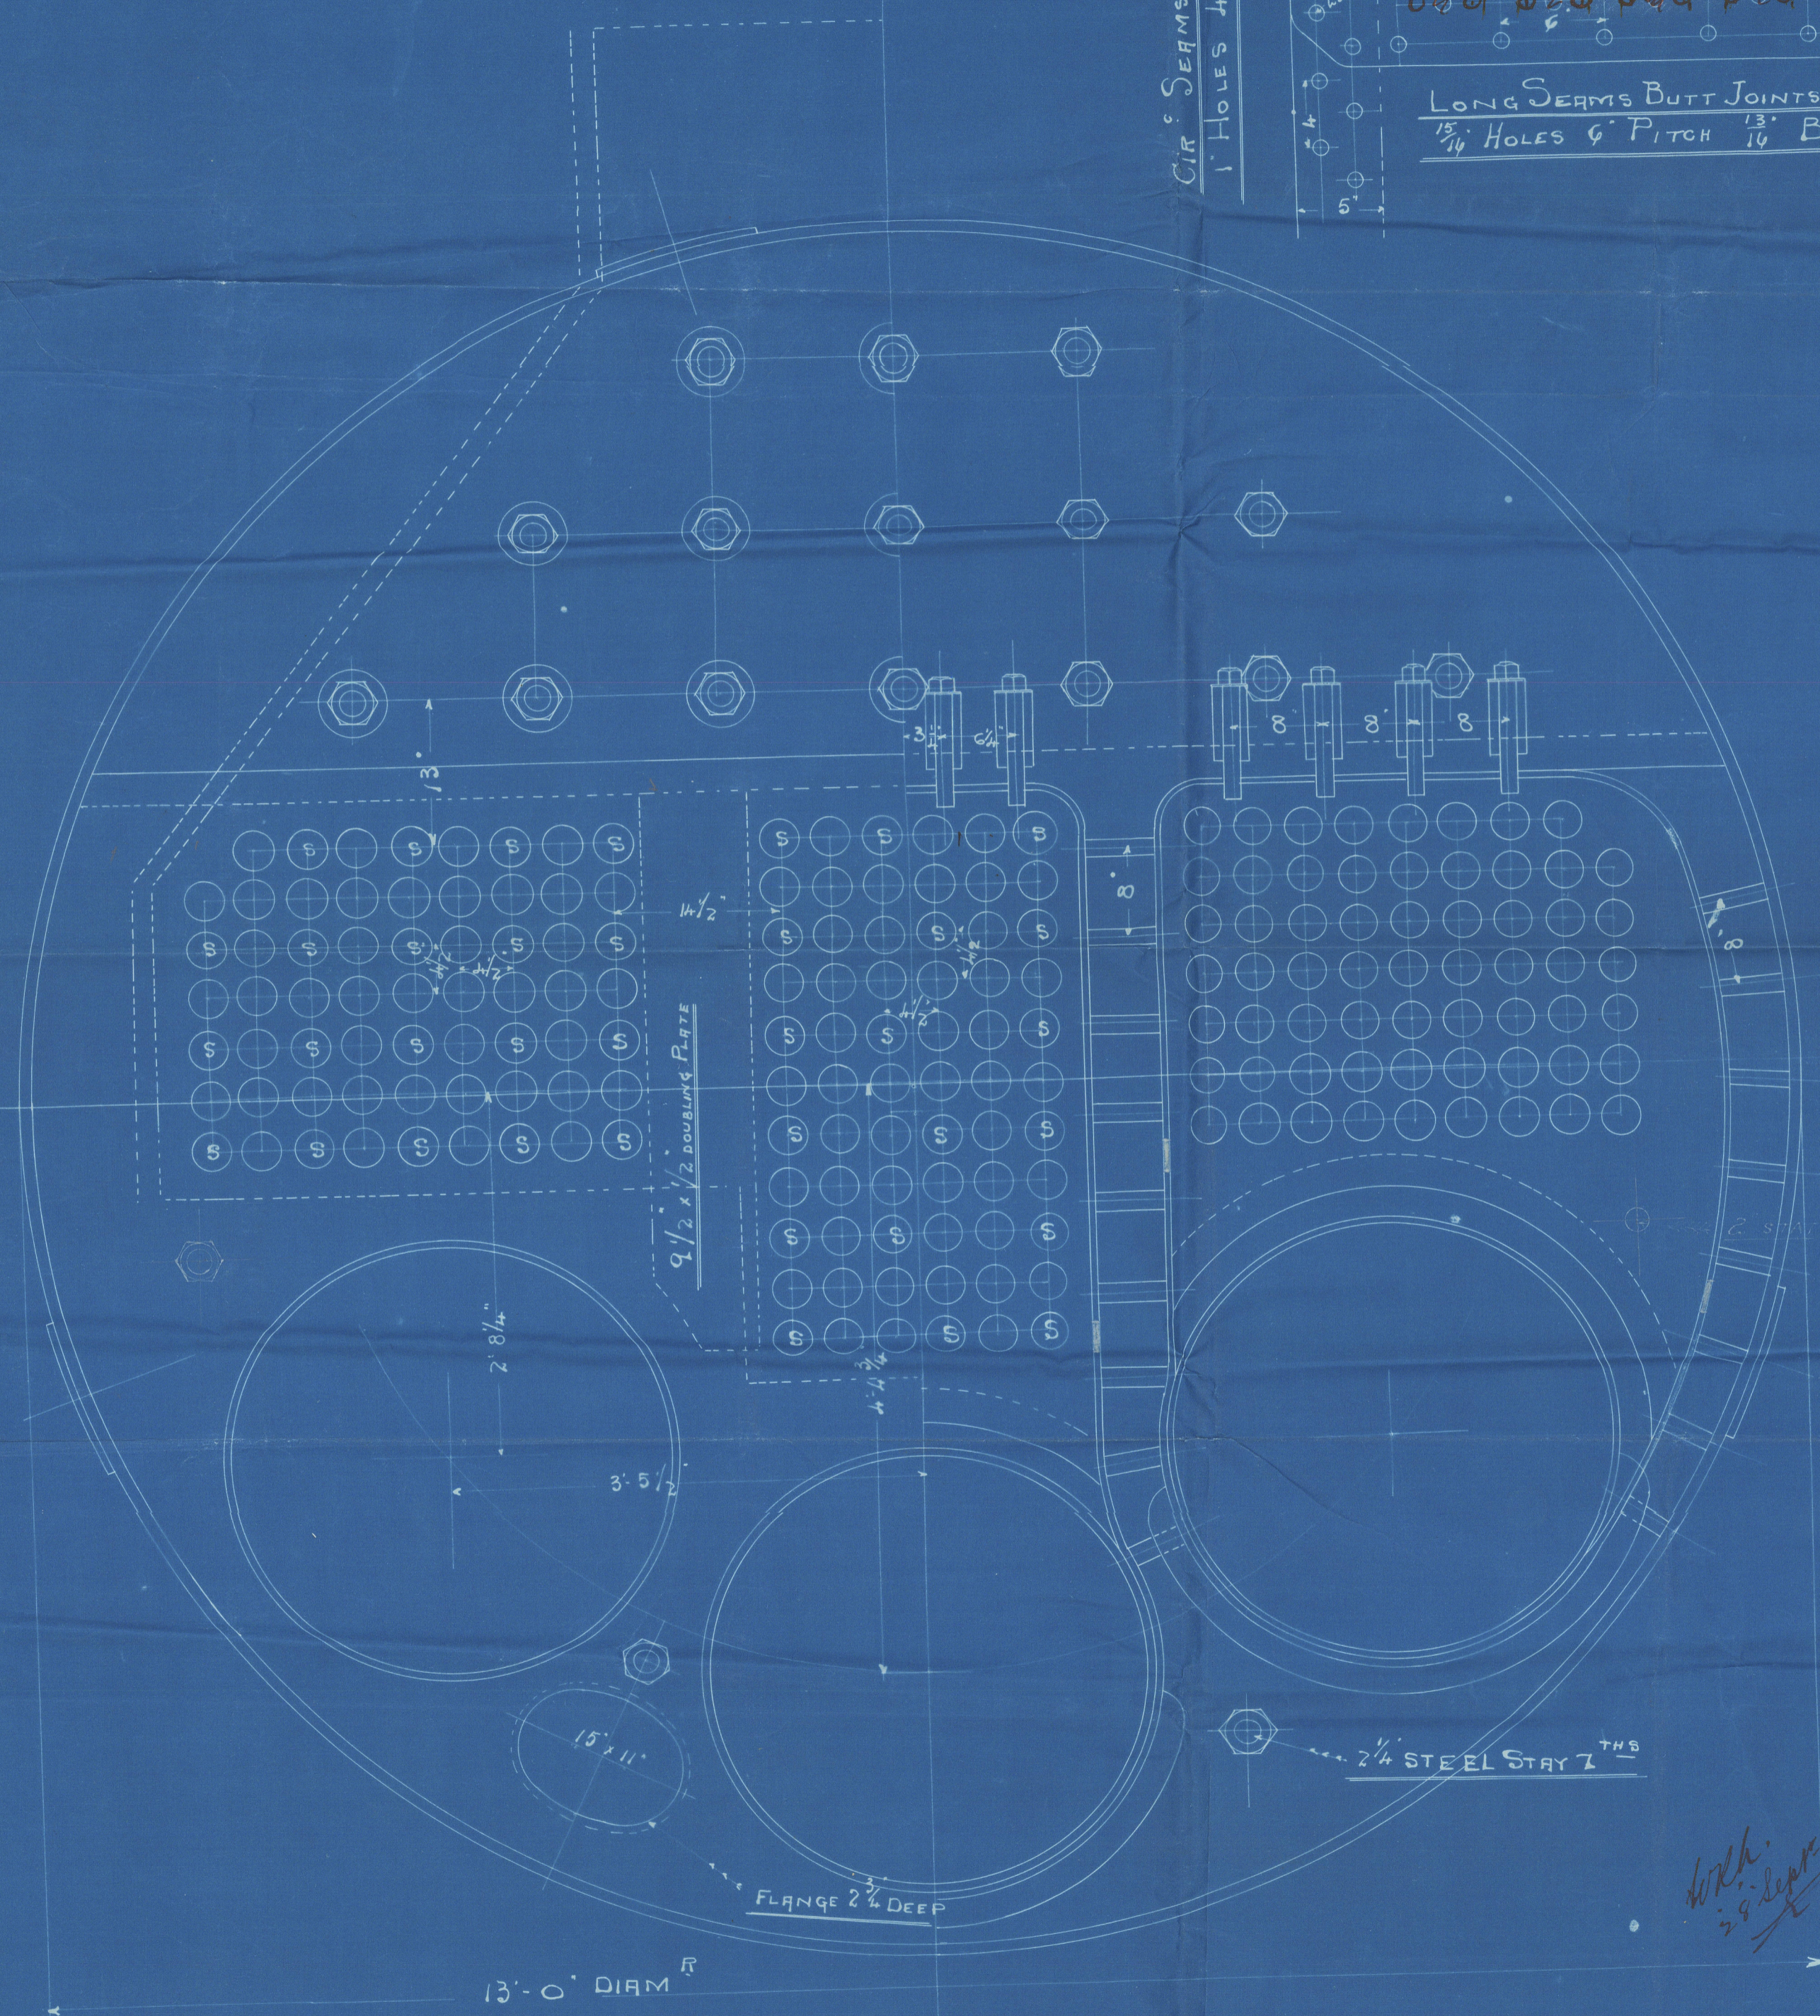

Boiler No 802  
Working Pressure 120 LBS.  
Scale Inch = One Foot

TO HAVE LLOYD'S CERTIFICATE

29.9.99

Man Bolei<sup>no 802</sup>  

Ross & Duncan  
for

Gullerton 169<sup>no</sup> 153<sup>no</sup>

120 lbs "working press"



S.S. "The Lady Belle"

Glasgow Report No. 17944

RE



© 2020

Lloyd's Register  
Foundation

W1025-0303