

Lloyd's Register of Shipping.


SURVEYS FOR FREEBOARD.

(CONDITIONS OF ASSIGNMENT.)

Oslo rpt. No. 6166.

Ship's Name **"UDDU" ex. M.M.S. 1013** Port of Survey **Trondheim, Oslo district**
 Official Number _____ Surveyor's Signature **Lorich. Wang**
 Nationality and Port of Registry **Norwegian, Trondheim** Date of Survey **6th of April 1948.**

Disposition and dimensions of superstructures, trunks, deckhouses and machinery casings to be inserted in the diagrams and tabular statement:—

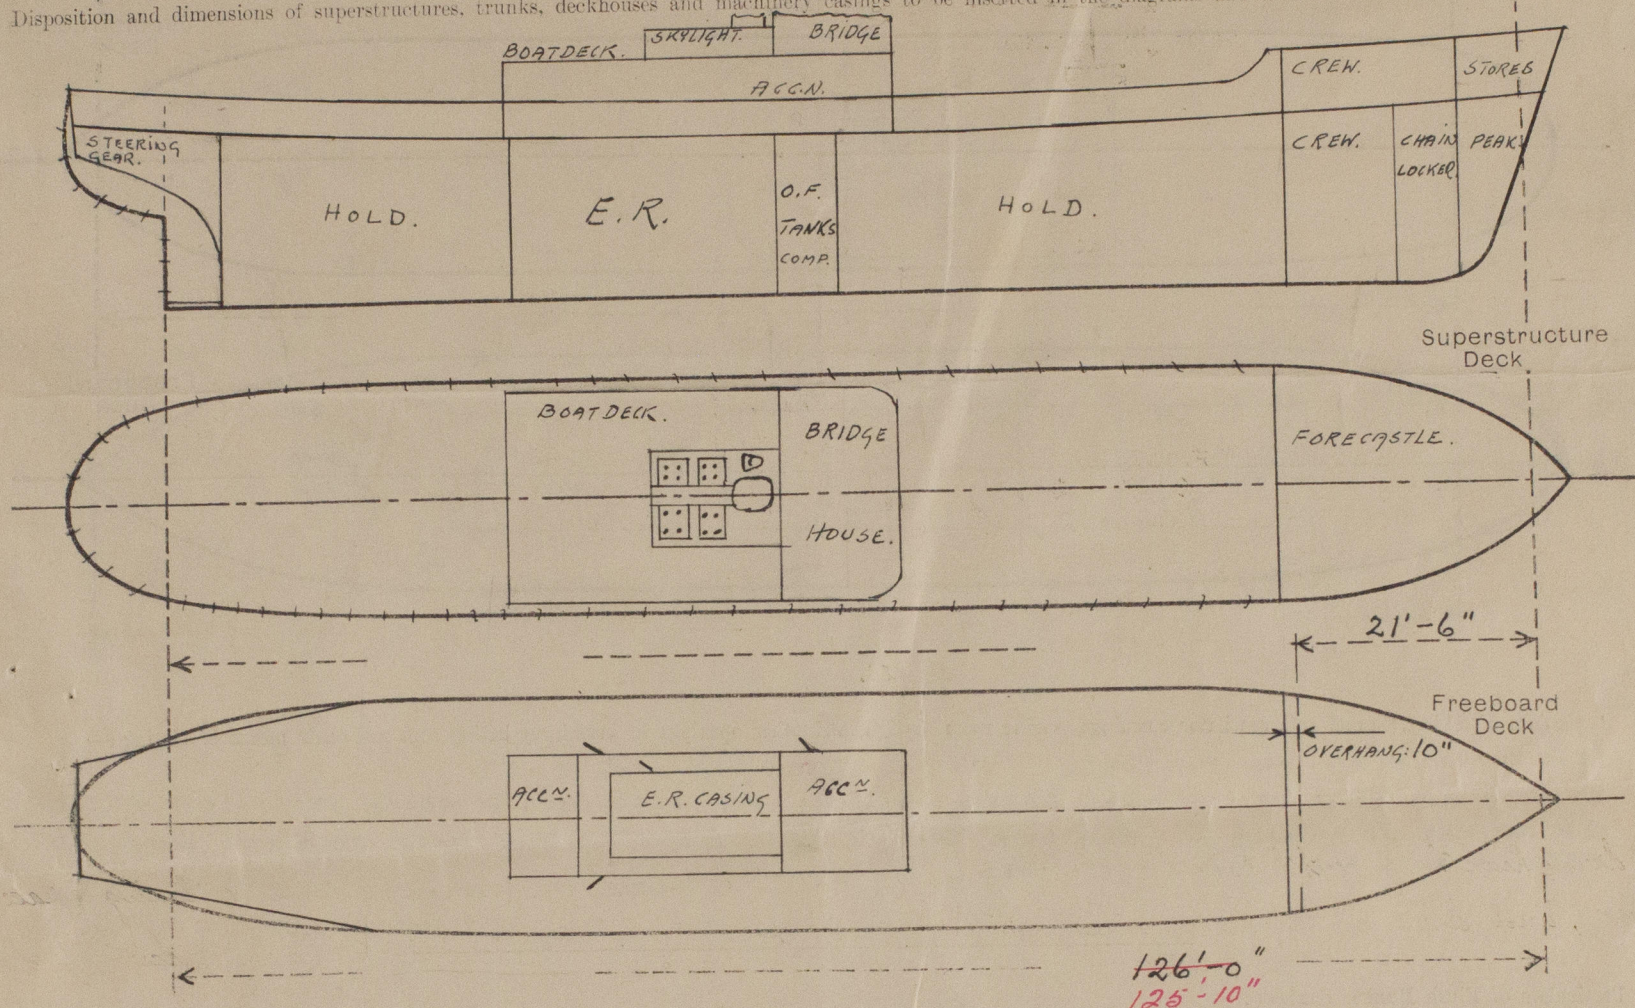


Particulars of Superstructures, Trunks, Casings, Deckhouses.

	Coaming	Plating	Stiffeners	Spacing	End Attachments of Stiffeners	Size of Openings	Height of Sills	Height of Casings
Poop Bulkhead ...								
Raised Quarter Deck Bulkhead ...								
Bridge, After Bulkhead ...								
Bridge, Forward Bulkhead...								
Forecastle Bulkhead...	Continuous	Wood 3 1/4" double diag.	Horizontal beams Top: 9"x9" wood Bottom: 3"x3" wood	✓	Top Beams knees: 27"x29"	3'-11" x 2'-3"	24" ✓	6'-5" ✓
Trunk, Aft ...								
Trunk, Forward ...								
Exposed Machinery Casings on Freeboard or Raised Quarter Decks ...								
Exposed Machinery Casings on Superstructure Decks ...								
Machinery Casings within Superstructures not fitted with Class I Closing Appliances ...	✓	25" ✓	3"x3"x.25"	at. 26" ✓	Satisfactory ✓	4'-10"x1'-11" 10'4": 4'-11"x1'-8"	24" ✓	7'-7" ✓
Deckhouses on Flush Deck Ships ...	19"x5 1/2"	First part 1 1/8" wood. After - 2" -	7"x4 1/2"	at. 30" ✓	Satisfactory ✓	2'4": 4'-9"x1'-10"	24" ✓	7'-7" ✓

Particulars of Closing Appliances (state if capable of being manipulated from both sides).

Poop Bulkhead ...	
Raised Quarter Deck Bulkhead ...	
Bridge, After Bulkhead ...	
Bridge, Forward Bulkhead ...	
Forecastle Bulkhead...	Wood hinged W.T. door. 5 turnbuckle jamb handles, manipulated from both sides. ✓
Exposed Machinery Casings on Freeboard or Raised Quarter Decks ...	
Exposed Machinery Casings on Superstructure Decks ...	
Machinery Casings within Superstructures not fitted with Class I Closing Appliances ...	1 Steel door fitted with lock & handles both sides. (Hinged) ✓
Deckhouses on Flush Deck Ships ...	3 Hinged wood doors, fitted with lock & handles both sides. ✓

PARTICULARS OF PROTECTION TO OPENINGS, ETC.

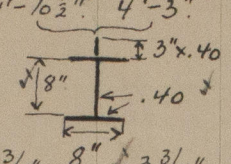HATCHWAYS ON FREEBOARD AND SUPERSTRUCTURE DECKS.									
Description of Hatchway		Cargo No. 1.	Cargo No. 2.	Access to Steering gear					
Dimensions of Hatchway		24'-4"	12'-9"	Circular 25" diam.					
COAMINGS	Height above Deck	28"	36"	6"					
	Thickness	.40"	.40"	.40"					
	Stiffeners	2"x2 1/2"x.40	7"x2 1/2"x.40	none.					
	Brackets, Stays	4"x2"x.40	4"x2"x.40	none.					
HATCH BEAMS	Number	4	2						
	Spacing	4'-10 1/2"	4'-3"						
	Scantling and Sketch			none.					
	Bearing Surface	3 3/4"	8"	3 3/4"					
FORE AND AFTERS	Number								
	Spacing								
	Unsupported Lengths								
	Scantling* and Sketch	none.		none.					
HATCH COVERS	Material	Wood.	Wood.	Steel .40"					
	Thickness	2 3/4"	2 3/4"	Bayonet fitting,					
	How fitted	F. & A.	F. & A.	circular, handle & lock, hinged,					
	Bearing Surface	2 3/4"	2 3/4"	rubber packing, W.T.					
Spacing of Cleats		20"-24"	22"-24"	none.					
Number of Tarpaulins		2.	2.	none.					
<p>*Are wood fore and afters steel shod at all bearing surfaces? <input checked="" type="checkbox"/></p> <p>Are battens and wedges efficient and in good condition? <input checked="" type="checkbox"/> yes.</p> <p>Are tarpaulins in good condition and in accordance with rule requirements? <input checked="" type="checkbox"/> yes.</p> <p>Are lashings provided in accordance with rule requirements? <input checked="" type="checkbox"/> yes.</p>									

Particulars of any special features:—

The drum head type ventilators are of heavy and special construction, preventing water entering spaces below, and are now being provided with canvas covers as additional temporary means of closing.

This vessel has been converted from minesweeper to ordinary cargo vessel.
See approved plans.

RETAIN



© 2020

Lloyd's Register
Foundation