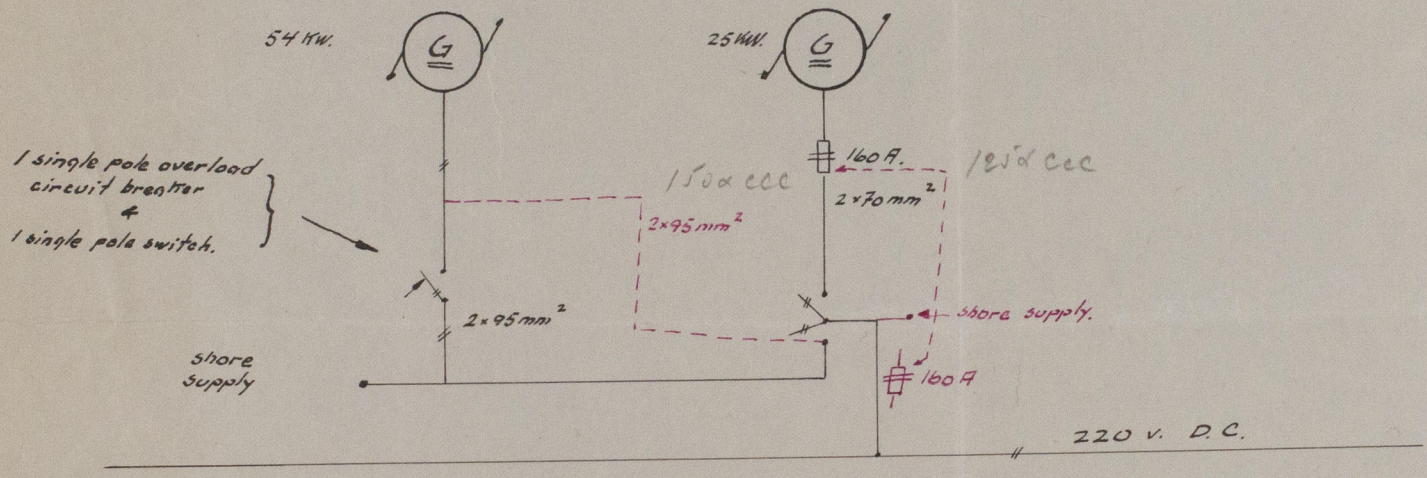

M/s Uddu

L. 10-4-48.

W1026-0200

© 2020
Lloyd's Register
Foundation