

Approved
W.D.D.

Lloyds Register of Shipping
 JUN 3 1912
 Lloyd's Register of Shipping
 MAY 12 1913

STR No 6. PROFILE.
 PRINT No --- 171
 DATE SENT 5-27-12
 DRAWING No
 SCALE 1/8" = 1 FOOT.
W.D.D. & S.B. COLT
 MAY 25 1912

W1027-0154

Profile

L. Noronic

P. Art. 6.

RETAIN


RETAIN

353
22
361.

W1027-0154

12/382/31.85
26
22
31.85
709
12/382.25/31.85
22
12
709
15

352.25
21
361.25

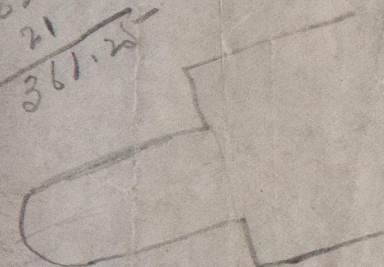

362
21
383

W1027-0154



© 2020

Lloyd's Register

MAY 25th 1912