


SANTO MARU

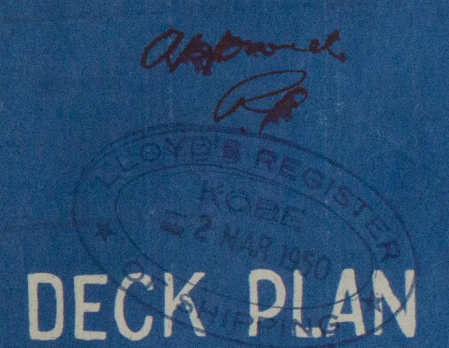

DECK PLAN

(AFT PART)

REVISED PLAN

SCALE 1/8" = 1 FT.

YOKOHAMA SHIPYARD & ENGINE WORKS

EAST JAPAN HEAVY INDUSTRIES LTD.

REPAIR DEPT.

DATE FEB., 20<sup>TH</sup>, 1950

