


# M. S. SANTO MARIU

## GENERAL ARRANGEMENT

SCALE 1/16 IN. TO ONE FT.

335'-0" x 48'-6" x 24'-0"

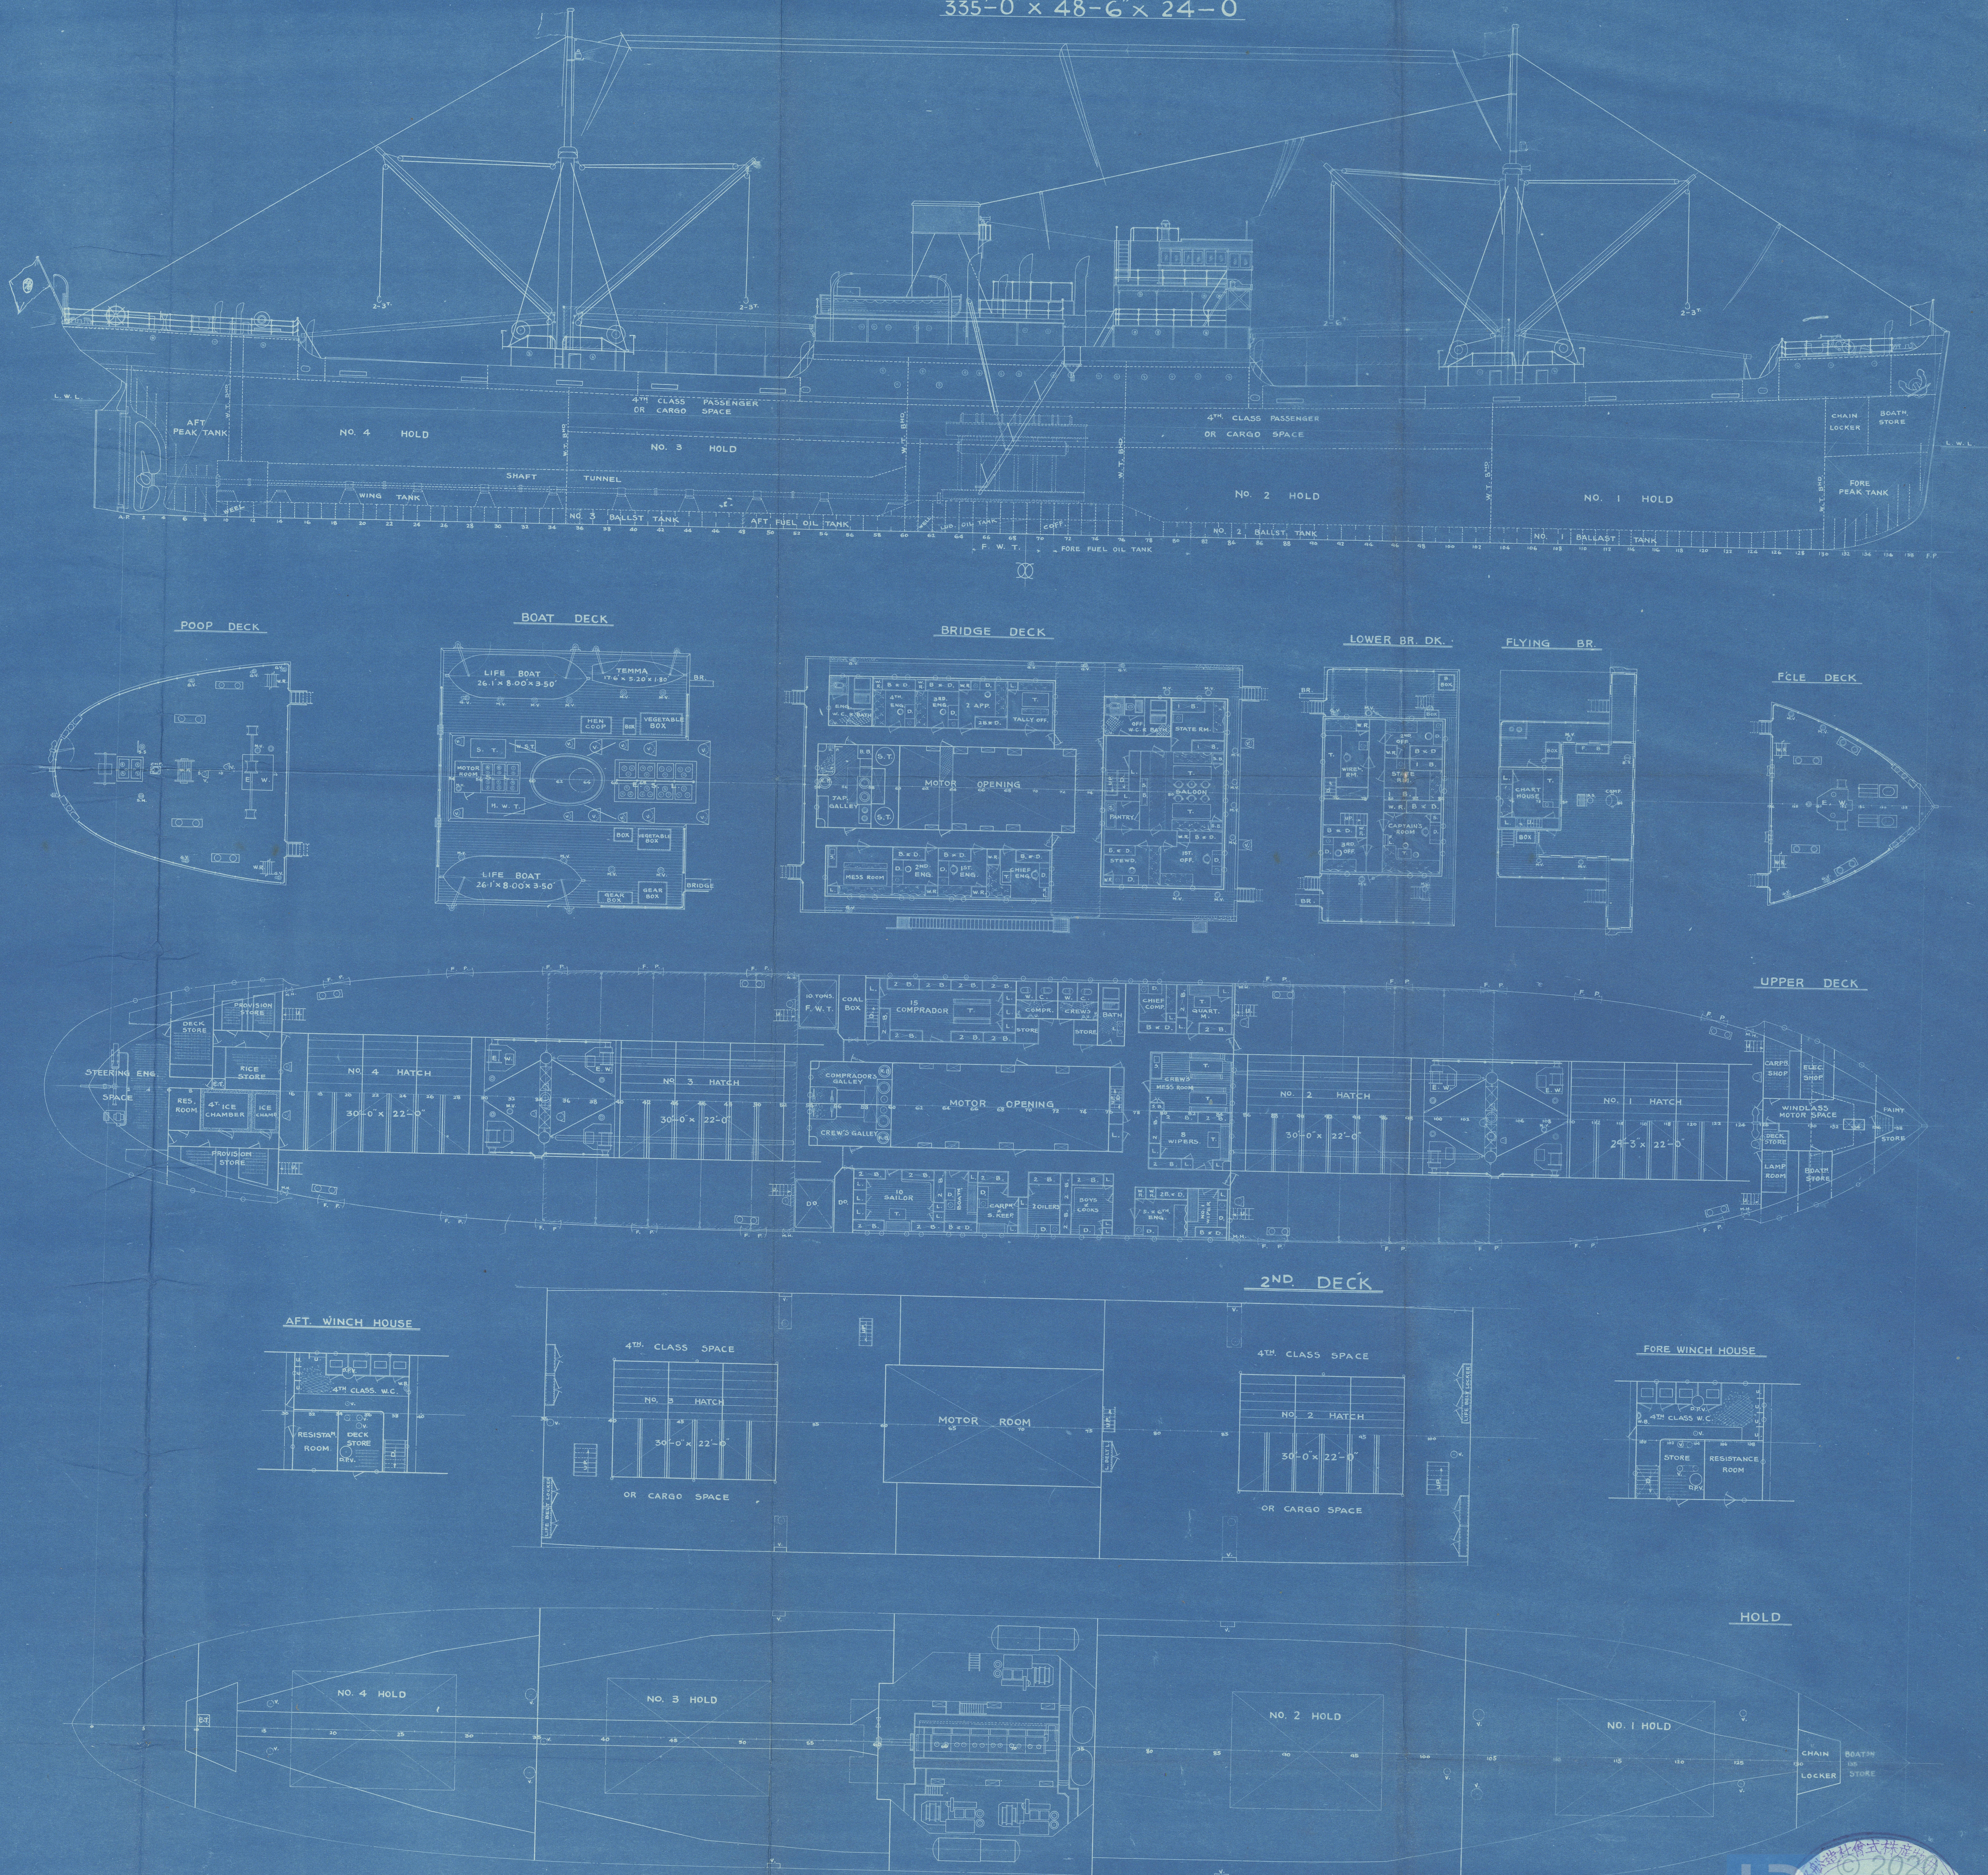



General Cargo. (as built)

S/S "SANTO MARU"

Kob 7387

RETAIN



© 2020

Lloyd's Register  
Foundation

W1028-0072