

M. S. SANTO MARI MIDSHIP SECTION. SCALE 1/2 IN. TO ONE FT.

NOTE :
BULB ANGLES TO BE 1927 GERMAN STANDARD SECTION

TO CLASS TEISHINSHO RULE 1ST CLASS VESSEL
& LLOYD'S 100 A. I.

PRINCIPAL DIMENSIONS		
LENGTH BETWEEN P. P.	335'-0"	
BREADTH MOULDED	48'-6"	
DEPTH	24'-0.57"	
HEIGHT BETWEEN UPPER & 2ND. DKS.	7'-6"	
OF DECK HOUSE	7'-6"	

SCANTLING NUMERAL




L	335.0 (335.25)	TEISHINSHO
B	48.5 (48.5)	DECK PLATING TO BEAM
D	24.05 (24.05)	UPPER DK. 7/8 RIV. 3/4 RIV. AT ENDS TO D. APART. 6.0 FOR ALT. FR. BEAM
1ST. LONGITUDINAL NUMERAL	8057. (8056.81)	2ND. 2/3 7 DIA. APART THROUGHOUT
2ND. " "	24304. (24304.94)	BRIDGE 3/4
3RD. " "	13.92 (13.92)	INNER BOTTOM TO REV. FR.
4TH. " "	10.53 (10.53)	RIV. 3/4 DIA. THROUGHOUT SPACED 7 DIA. APART
5TH. " "	21'-6"	EXCEPT IN MOTOR RM. WHERE 7/8 RIV. 6 DIA. APART

EQUIPMENT NUMERAL

2ND. LONG. NUMERAL	24.304.0 (24304.94)	FORGING & CASTING :-
BRIDGE	80.0 x 7.75 x 34	STEM 12" x 24" FORGED STEEL, LOWER PARTS CAST STEEL
POOP & FCLE	(32.5 + 30.5) x 7.5 x 34	STERN POST CAST STEEL AS PER PLAN
DECK HOUSE	(47.5 + 22.5 + 22.5) x 7.5 x 34	RUDDER POST " " STEEL PL. AS PER PLAN
EQUIPMENT	25.464.9 (25561.14)	RUDDER STOCK FORGED STEEL
1 - BOWER ANCHOR (STOCKLESS)	5 CWT. 15	RUDDER OERTZ RUDDER
1 - " " " " " "	51 2' 15"	
1 - " " " " " "	44 0' 21"	
STREAM " (COMMON)	12 2' 1"	
270 FATHOMS 2" STUD CHAIN CABLE		
90 4 1/2" STEEL WIRE FOR STREAM ANCHOR		
120 4" " " TOWLINE		
4 COILS OF 90 FATHOMS OF 7" MANILA FOR HAWSER & WARP		

ROWS IN BUTTS

BRIDGE DK. STRINGER PL.	1/2 L	ENDS
" " PLATE	3	
UPPER DK. STRINGER PL.	4	3-2
" " PLATE	3	3-1
2ND DK. STRINGER PL.	2	
" " PLATE	1	
BRIDGE SIDE PLATE	3	
SHEER STRAKE	4	3-2
STRAKE BELOW SHEER STRAKE	4	3-2
SIDE PLATING	3	3-2
BOTTOM PLATING	3	2
INNER BOTTOM MIDDLE STRAKE	3	2
MARGIN PLATE	3	3
CENTRE GIRDER	3	3
KEEL PLATE	3	3

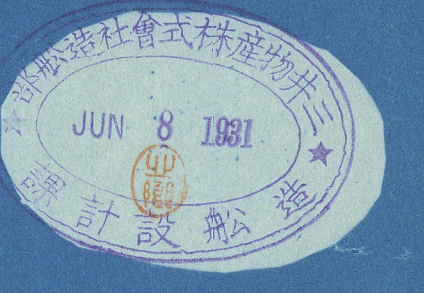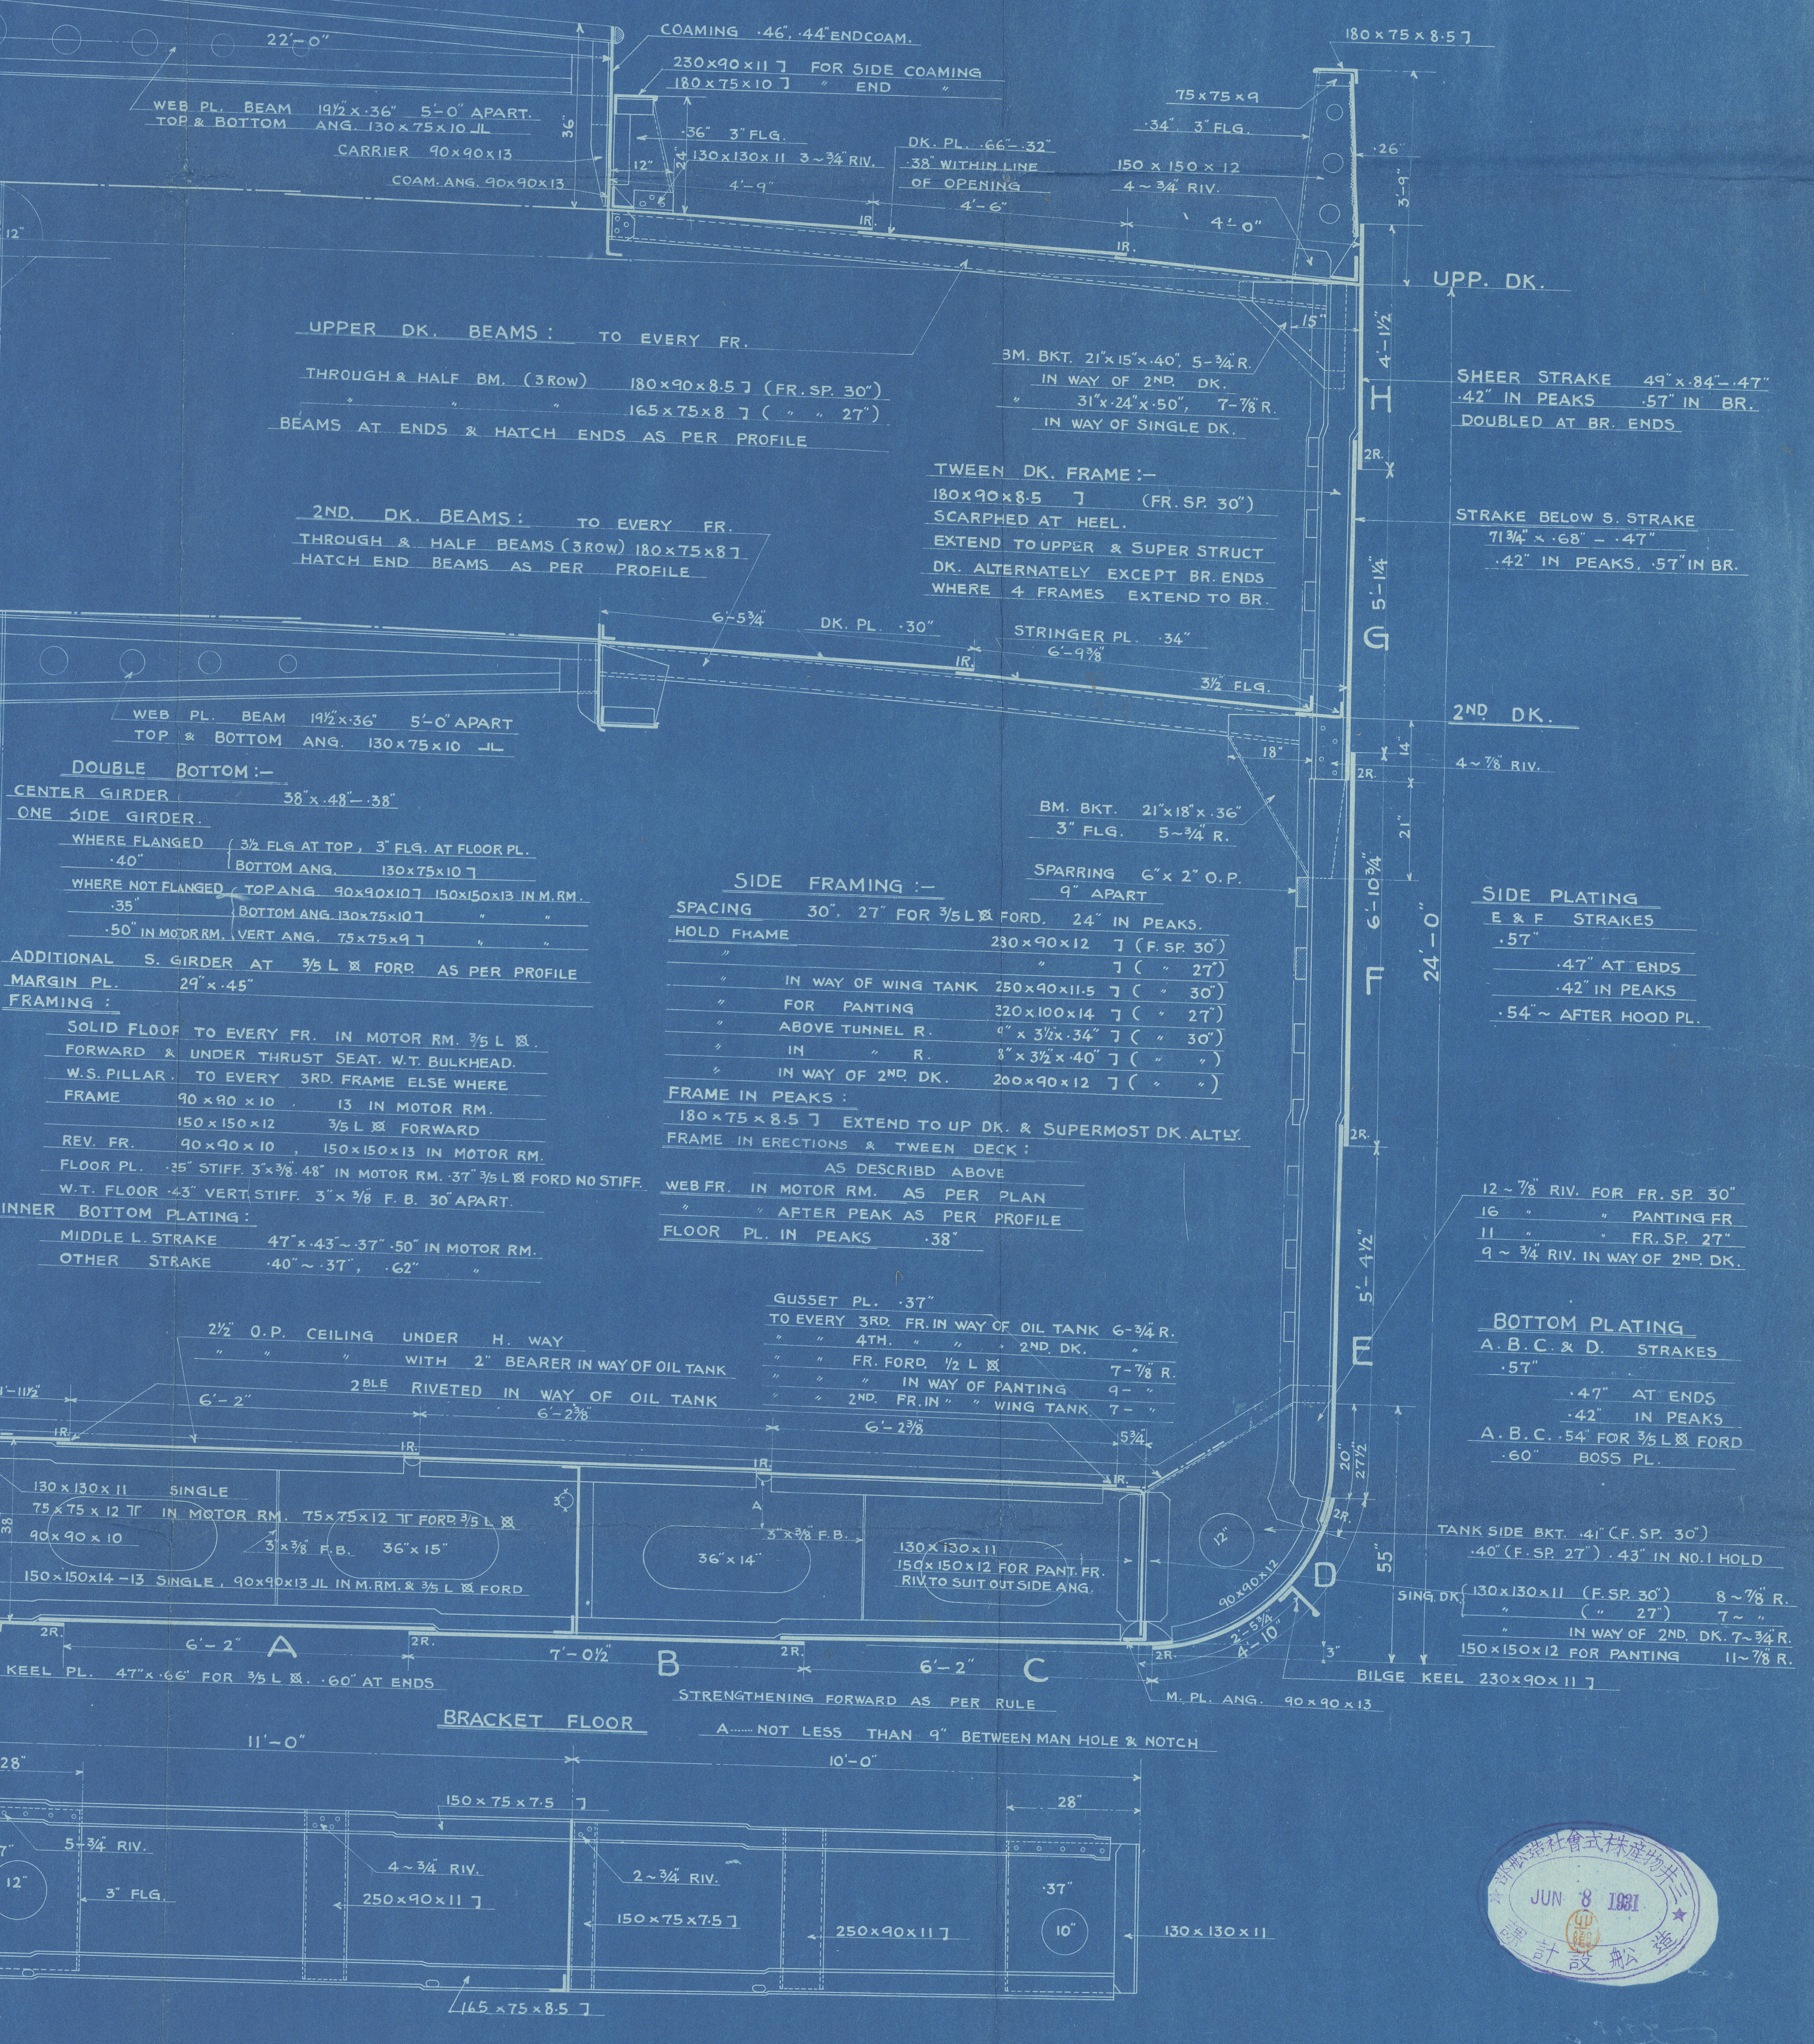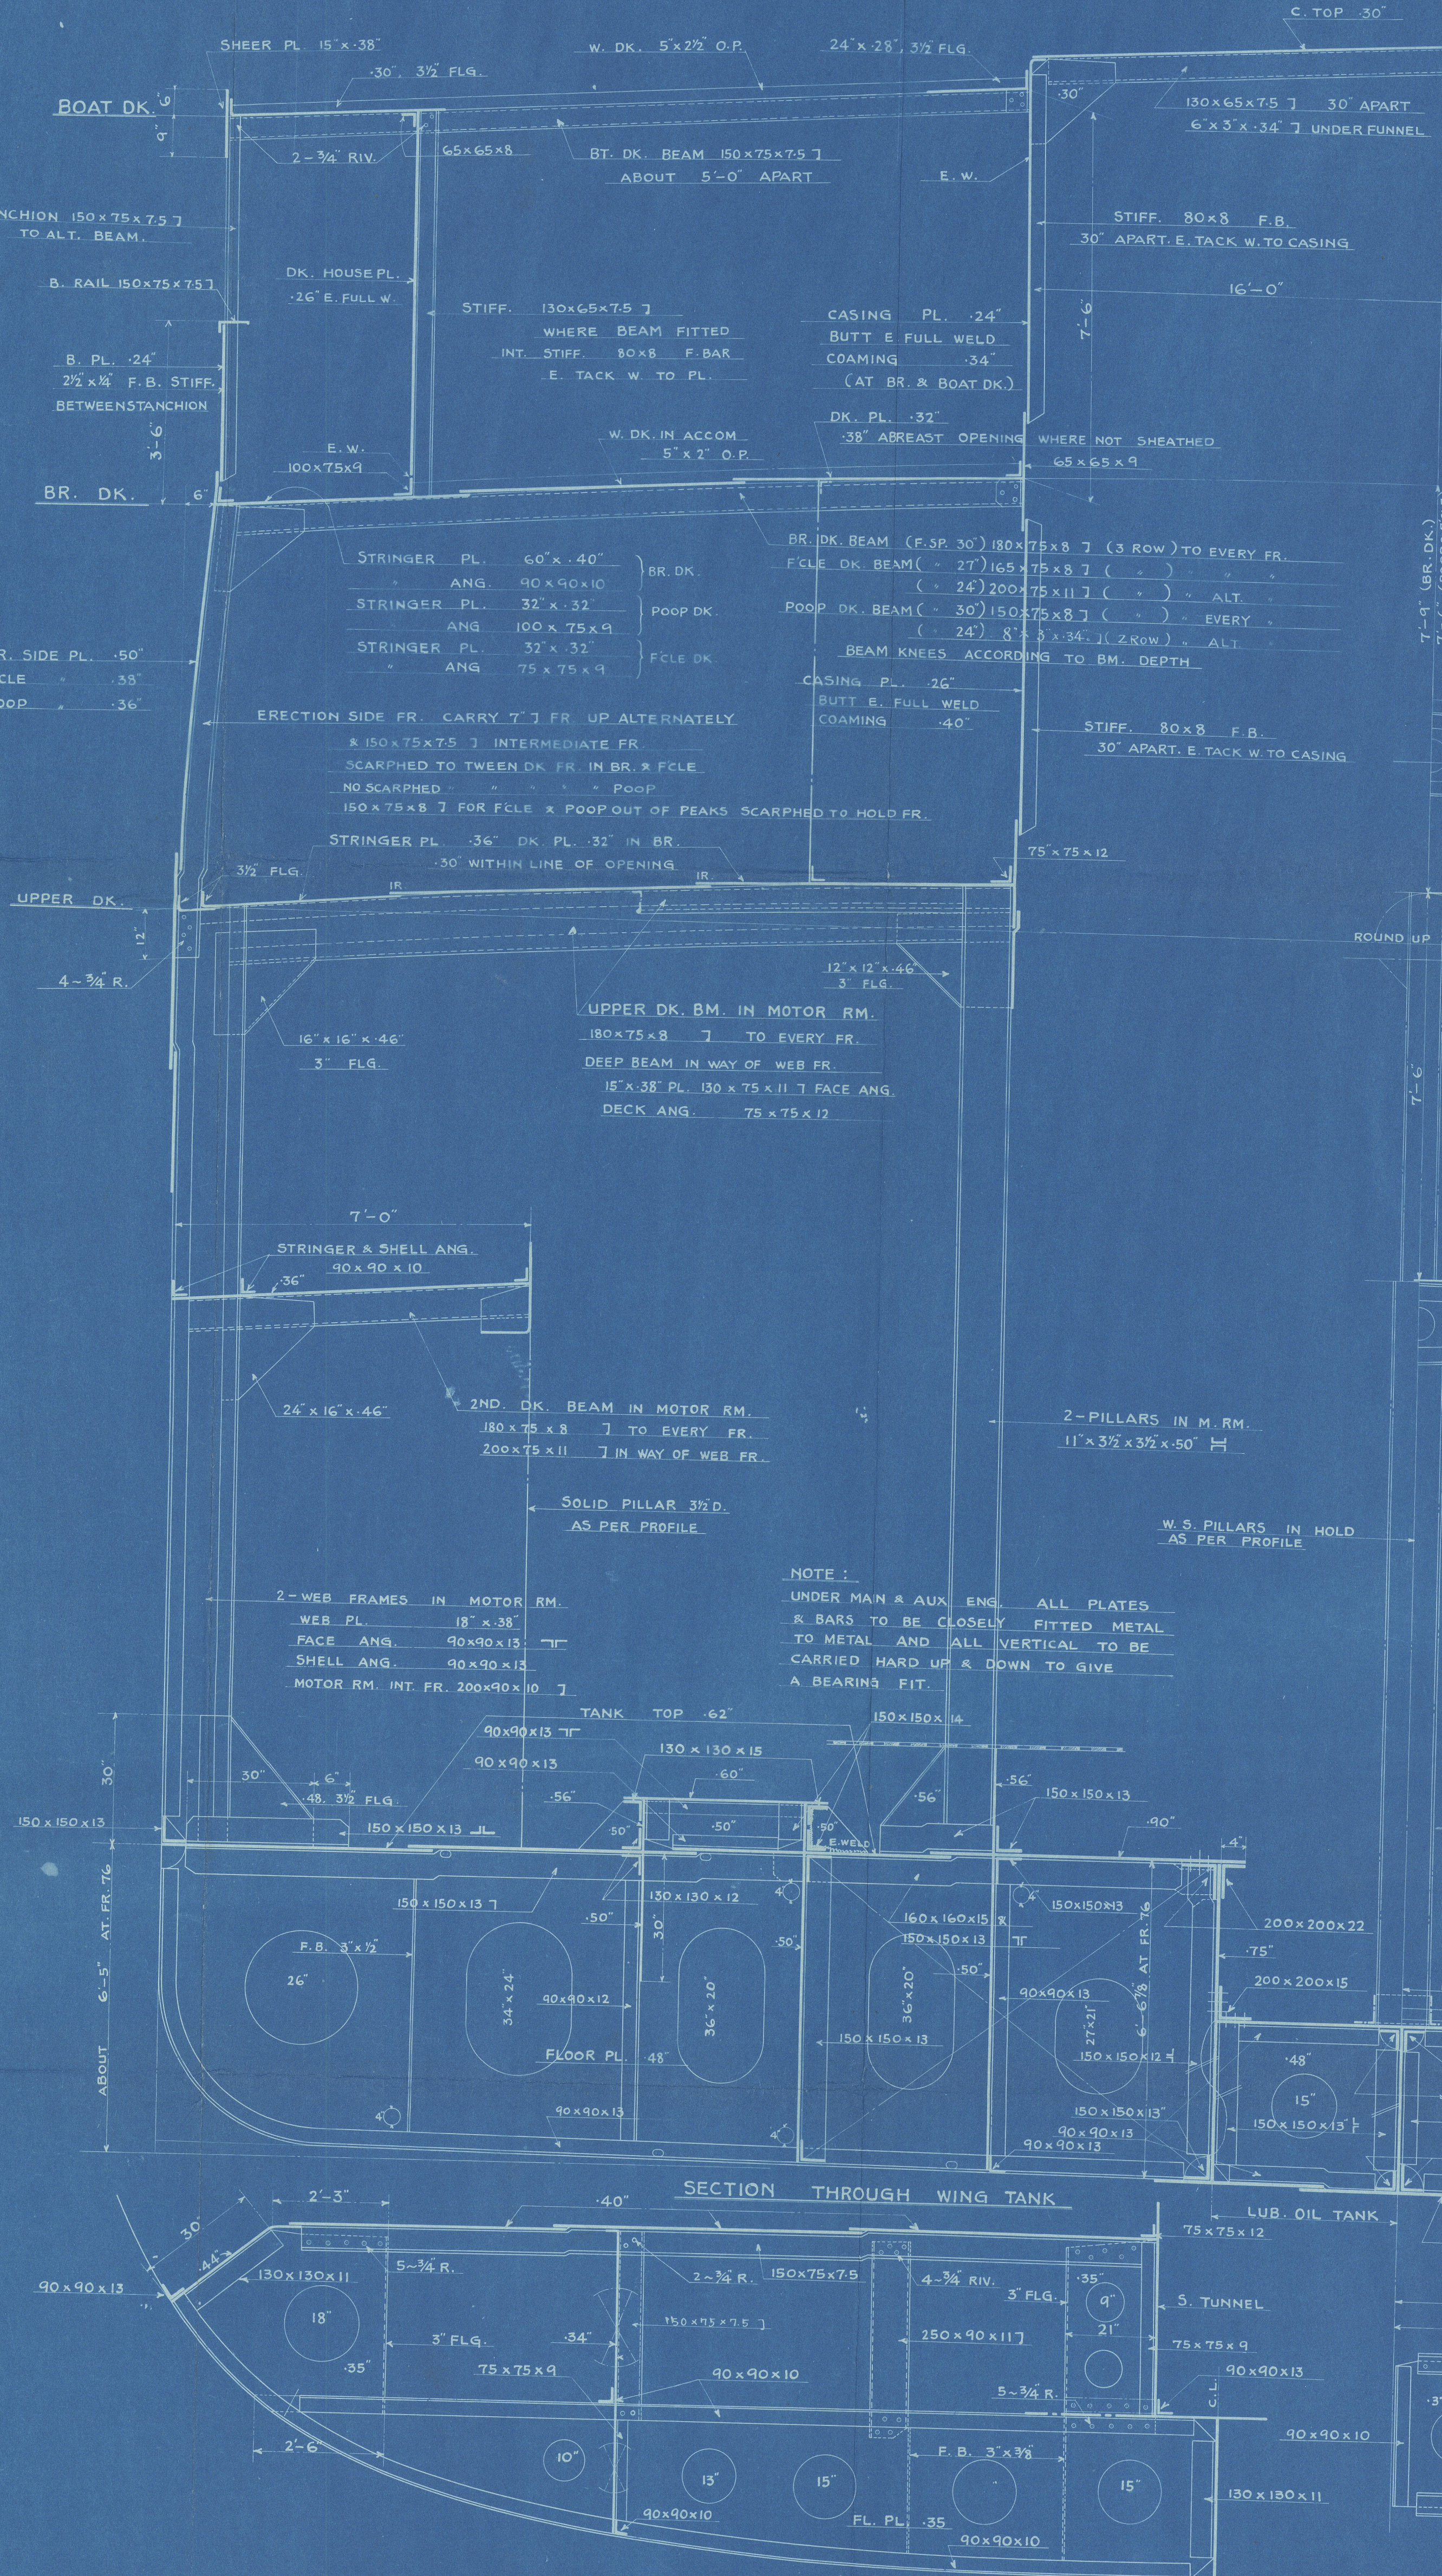

Midship Section ashnill

S/S "SANTO MARU"

Kob 7387.

RETAIN



© 2020

Lloyd's Register
Foundation

W1028-0074