

7.12.22.


# No. 529-30. PROMENADE DECK.

SCALE  $\frac{1}{4}" = 1 \text{ FOOT}$


ELEVATION AT SIDE OF CASING.

DECK PLATING JOGGED.  
DECK SHEATHED WITH 476-24 IRON WHERE EXPOSED  
5'-2 1/2" P. RAIL INSIDE ACCORDING TO  
DECK WHERE PLATED WITH SHARP RAIL  
THE PLATES 36" DOUBLE


BEAM CONNECTION TO SUPPORT IN WAY OF BEAT DAVIS.  
SCALE  $\frac{1}{4}" = 1 \text{ FOOT}$

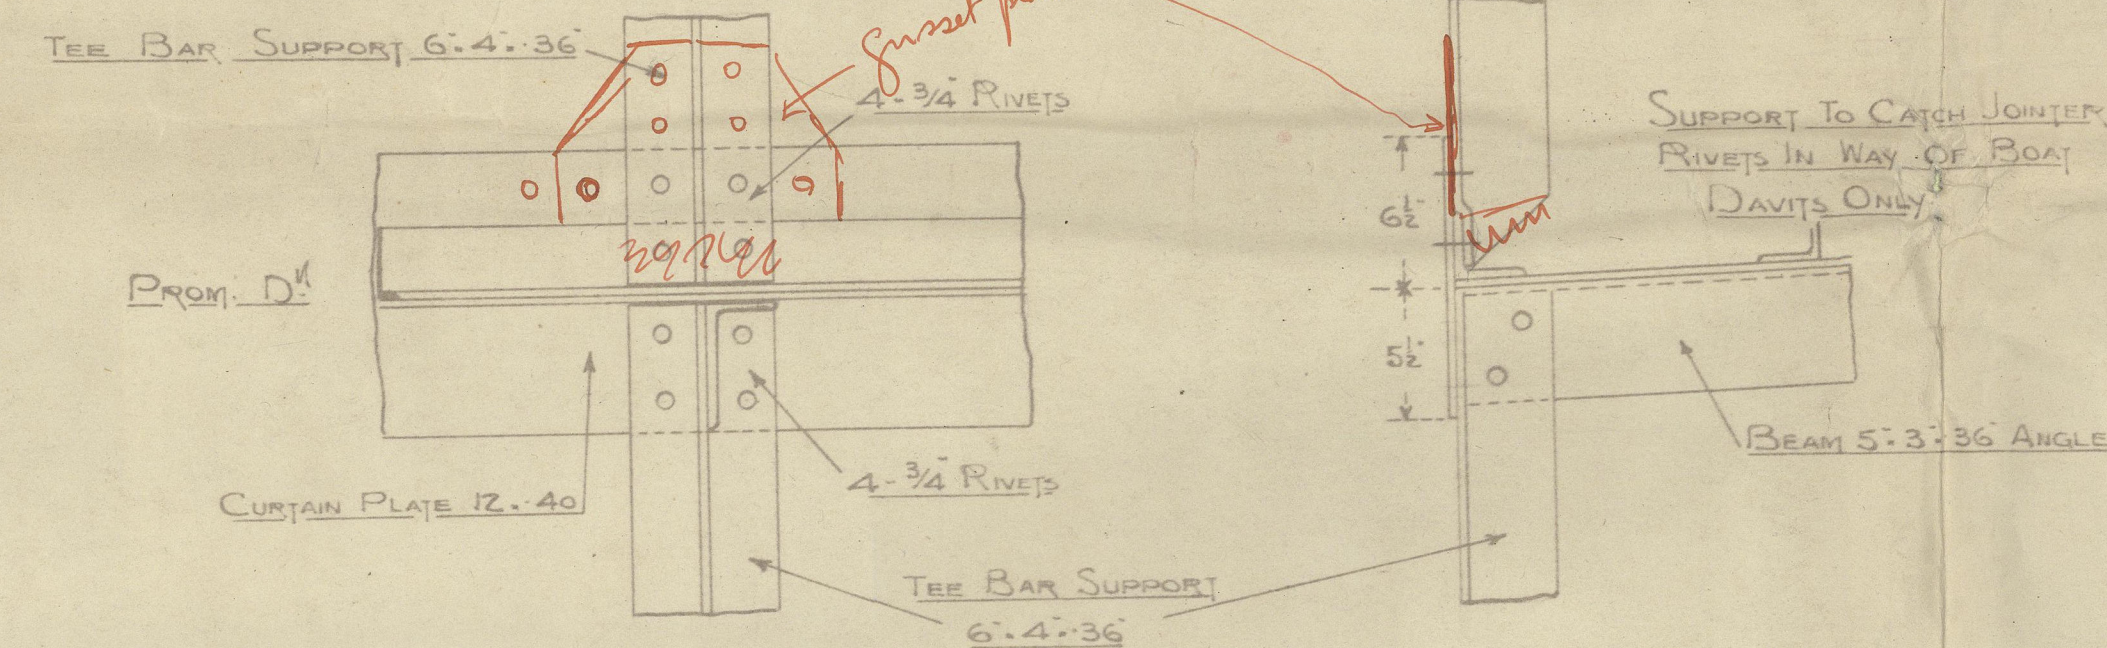



BEAM CONNECTION TO CURTAIN PLATE CLEAR OF SUPPORT.

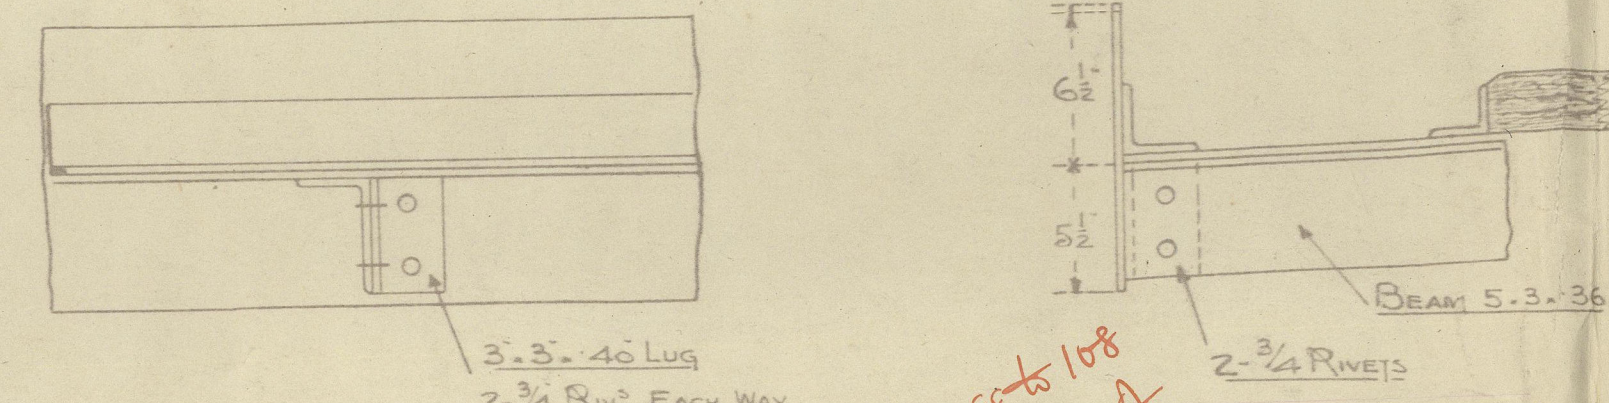

THE BEAM SUPPORTS ARE TO BE PLACED AT THE END OF STAIRWAY OR BEAT DAVIS.

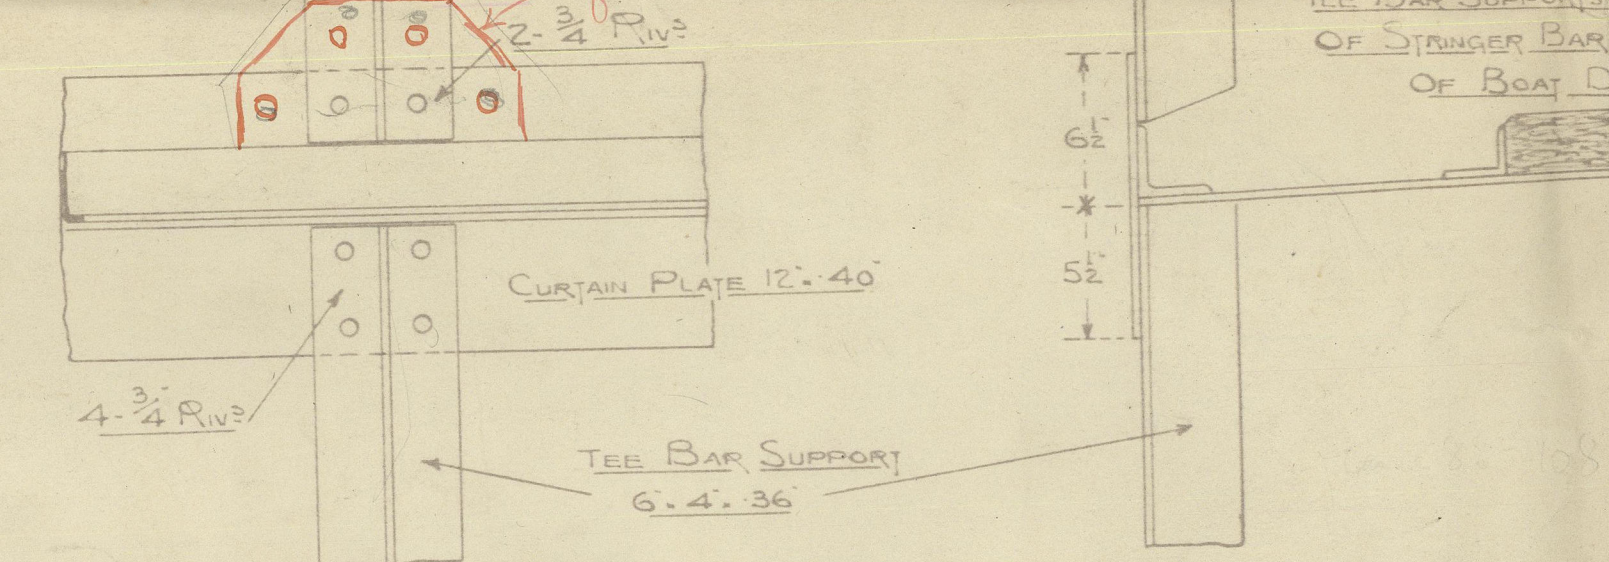

SECTION THROUGH END OF BEAT DAVIS

 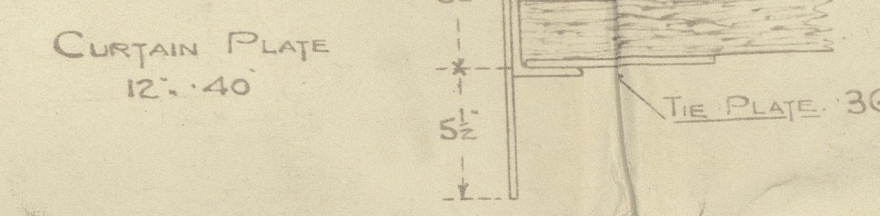



18  
Promenade D<sup>n</sup>

529-30

Hawthorn Leslie 46°

529-30

Promenade Deck

RETAIN  
S. S. "Malwa"  
NEWCASTLE ON TYNE.  
Report No. 44045.

S. S. "Malwa"  
NEWCASTLE ON TYNE.  
Report No. 44825.

RETAIN



© 2020

Lloyd's Register  
Foundation