


TRANSMISSION SHAFT  
COUPLINGS SHRUNK ON AND KEY

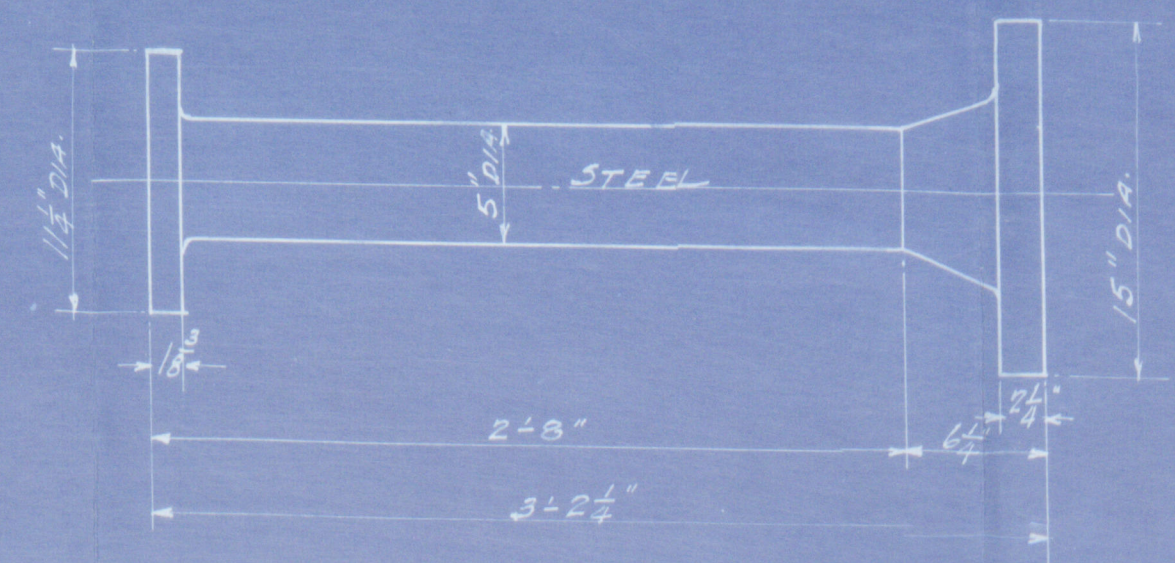

TAIL SHAFT

Noted  
Saw  
2-12-41.

SURVEYOR TO LLOYD'S AGENTS  
ILOILO P.I.  
STEEL SHAFTS  
M.S. MAMBUKAL  
SCALE: 1 1/2" = 1'-0"  
Nov. 9 1939.



Mambukal

LA. 7875.

Straight shafting

W103-0133

MAMBUKAL

Straight shafting



© 2021

Lloyd's Register  
Foundation