

# Lloyd's Register of Shipping.

(Report on Vessel No. 5914 Port Hongkong)

## No. 233 SHIP FORGINGS OR CASTINGS.

I have to report that the undermentioned ~~Iron or~~ Steel Forgings or Castings, manufactured by W. S. Bailey & Co. Ltd of Hongkong for the Vessel No. 233, being built by W. S. Bailey & Co. Ltd of Hongkong have been inspected by me as set forth below and found to be, so far as can be seen, sound & free from defects.

Mark on Forgings or Castings.


Lloyd's  
No. 233  
10-4-25  
T.S.M.

Hongkong, April 10<sup>th</sup> 1925

J. L. Morrison

	STERN FRAME.	RUDDER FRAME.	STEM.
Material*	<u>O.H. Steel</u>		
How made †	<u>Forged from ingot</u>		
Dimensions	<u>As per plan</u>		
Progress on Inspection	<u>Forged, annealed &amp; finished</u>		
Date when Inspected	<u>Mar. 24<sup>th</sup> April 3<sup>rd</sup> + 10<sup>th</sup> 1925</u>		
<b>CASTINGS.</b>			
Tests on Standard Test Pieces.			
Compressive Test—			
Tons per square inch	<u>3.2 Tons</u>		
Extension per cent. ....	<u>27 1/2 in 2"</u>		
3rd Bending Test—			
Angle before fracture	<u>180°</u>		
Drop Test—			
Height from ground ...	<u>-</u>		
Numbering Test—			
If made according to Rules and found satisfactory ...	<u>-</u>		

SKETCHES OF FRAMES SHOWING POSITION AND DESCRIPTION OF WELDS OF FORGINGS.

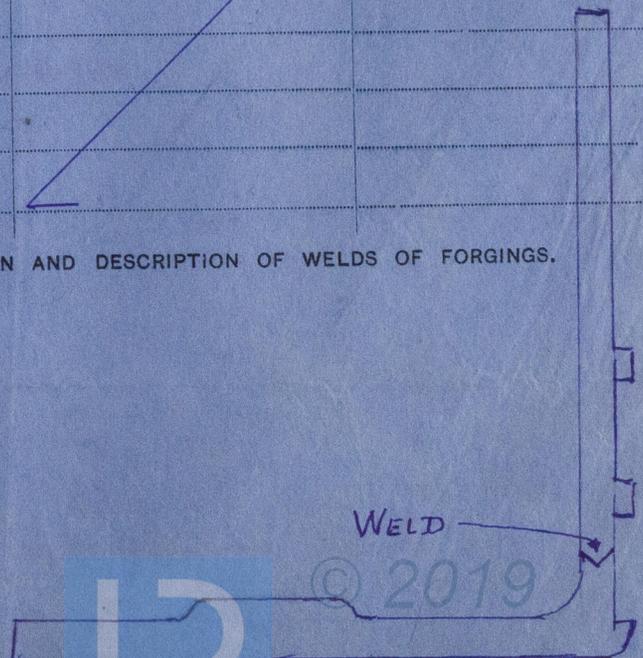


Fee (if any chargeable) £ — : : —

To be paid at —

\* If of Iron, state whether scrap or puddled Iron. If of Steel, state whether made on the Open Hearth process.

† State if annealed

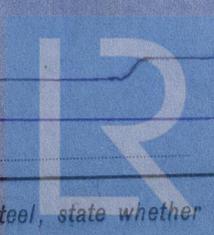

© 2019

Lloyd's Register

W103-0170