


Nº 5826.

LONGITUDINAL ELEVATION.

SCALE $\frac{1''}{8'} = 1 \text{ FOOT}$.

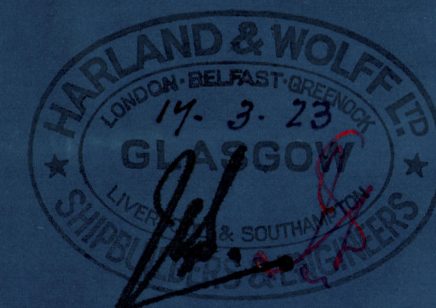

Messrs Harland & Wolff. No. 582
"Mattawin"
T.S.S. ^{ex} "EDIBA"

Profile of vessel
as built

582 GLASGOW REPORT No. 42668

for "Ediba"



© 2021

Lloyd's Register
Foundation

W103 0216