


7.11.11  
20.12.11  
21.2.12  
2.4.12


# DECK PLANS No. 238.

SCALE 1/8" = ONE FOOT.


## POOP DECK.

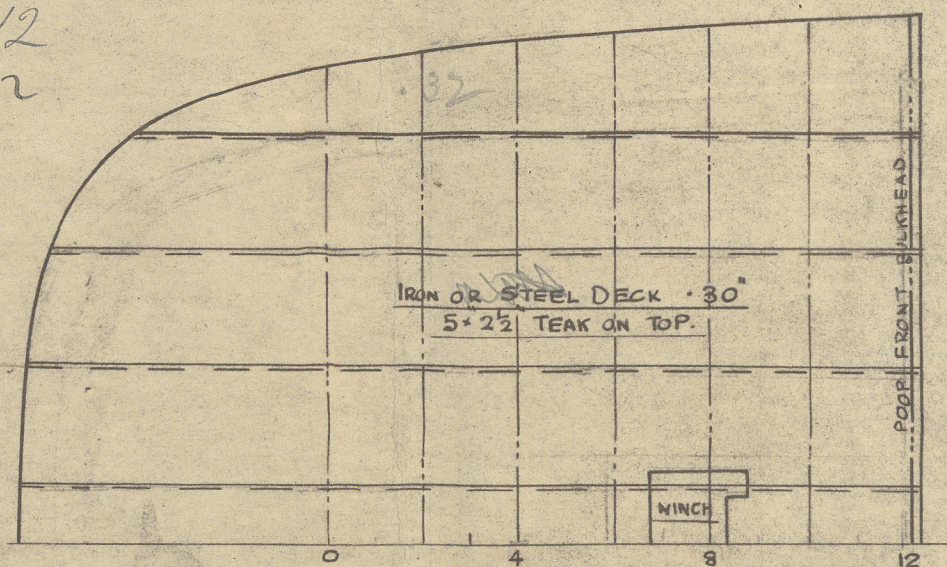


## BRIDGE DECK.

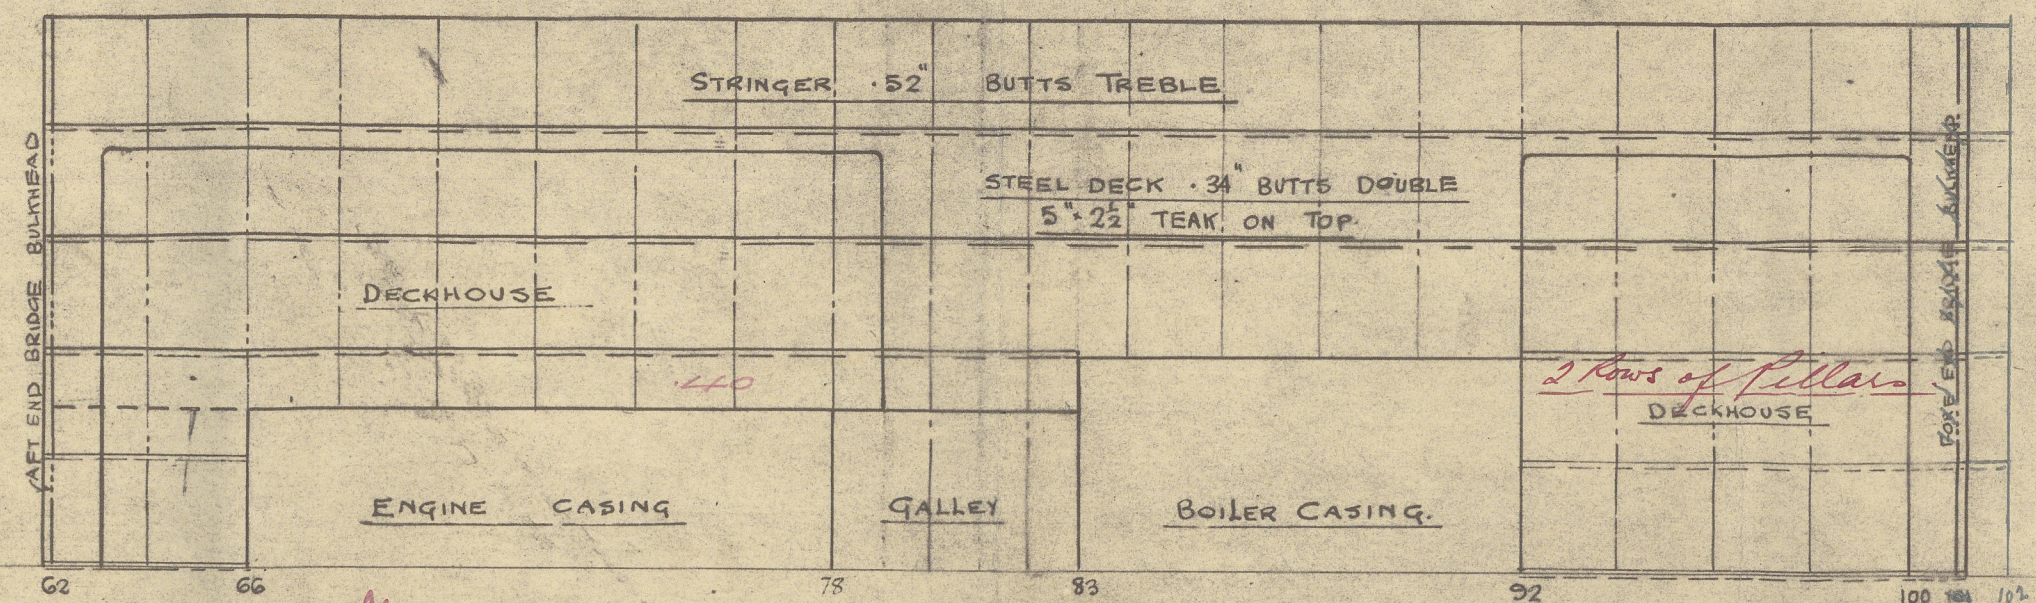


## FORECASTLE DECK.

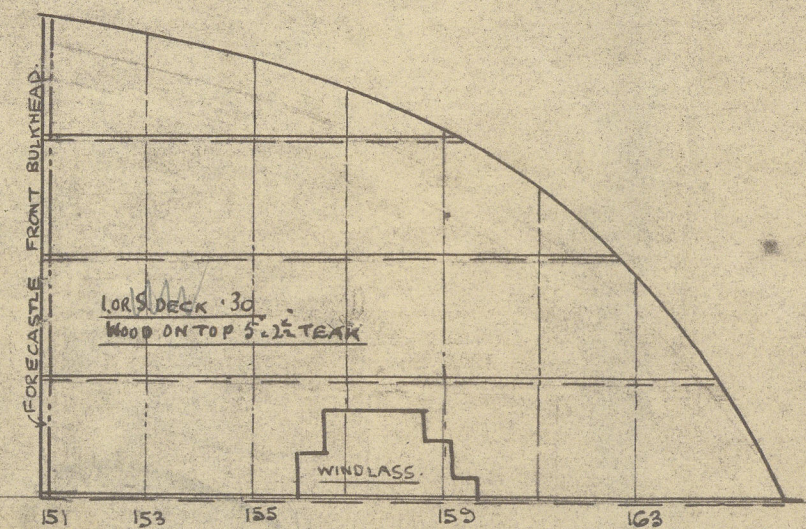

## UPPER DECK.

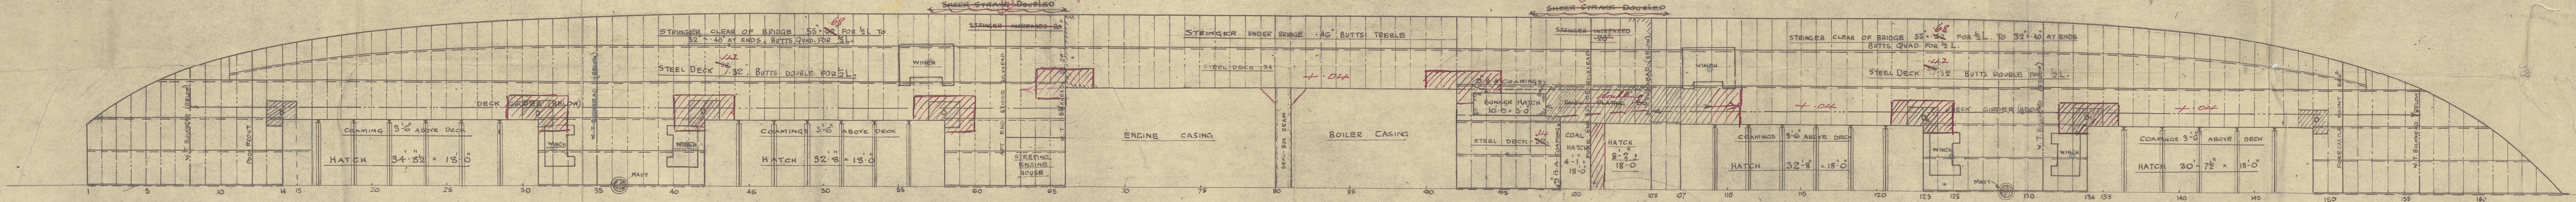

## MAIN DECK.

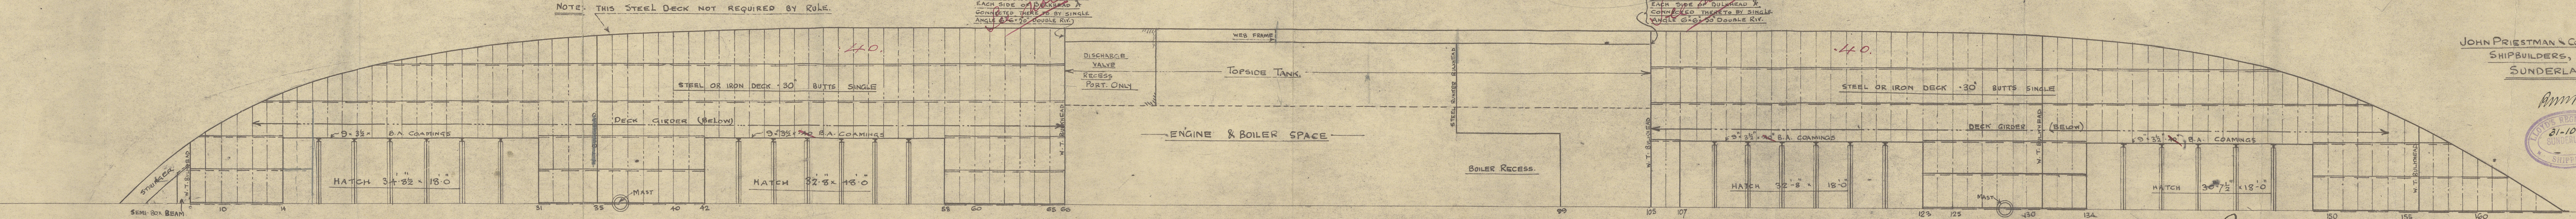

NOTE: THIS STEEL DECK NOT REQUIRED BY RULE.

STRINGER PLATE STOPPED AT EACH SIDE OF DECKHOUSE & CONNECTED TO DECK BY SINGLE ANGLE 6" x 3" DOUBLE RIV.

STRINGER PLATE STOPPED AT EACH SIDE OF DECKHOUSE & CONNECTED TO DECK BY SINGLE ANGLE 6" x 3" DOUBLE RIV.

JOHN PRIESTMAN & CO.,  
SHIPBUILDERS,  
SUNDERLAND.





W1030-0059

# TIME

Deck Plan *Old No. 23390*

No. 238




J. Priestman & Co.

*Old No. 25069*

*25553*



25 JUL 1912

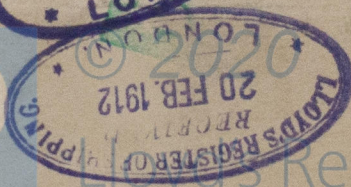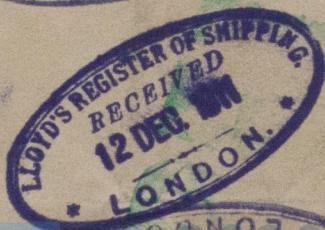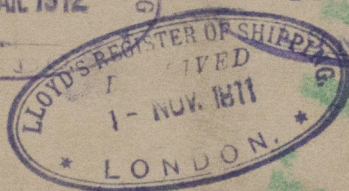

Lloyd's Register  
Foundation