


AMENDED PROFILE S.S. TIME.

SCALE 1/8" = ONE FOOT

— DIMENSIONS —
LENGTH BP 340'-0"
BREADTH EXT 49'-3"
DEPTH MLD 24'-3 1/2"

JOHN PRIESTMAN & Co.,
SHIP BUILDERS,
SUNDERLAND.

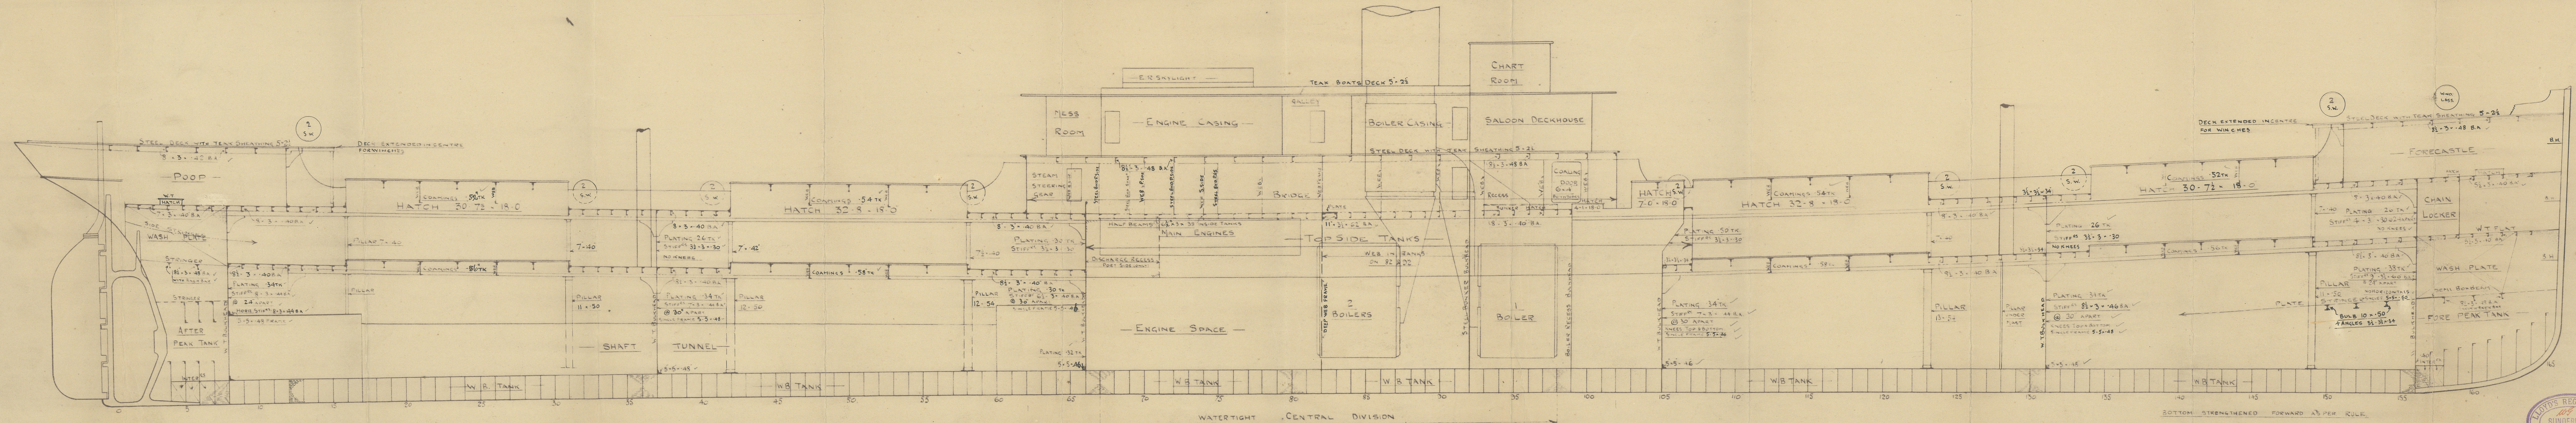

W1030-0062

"
S.S. TIME"

PRIESTMANS N^o 238.

PROFILE

(AS FITTED)

Sld. Rpt. No. 25590.

DETAIN

DETAIN



© 2020

Lloyd's Register
Foundation