
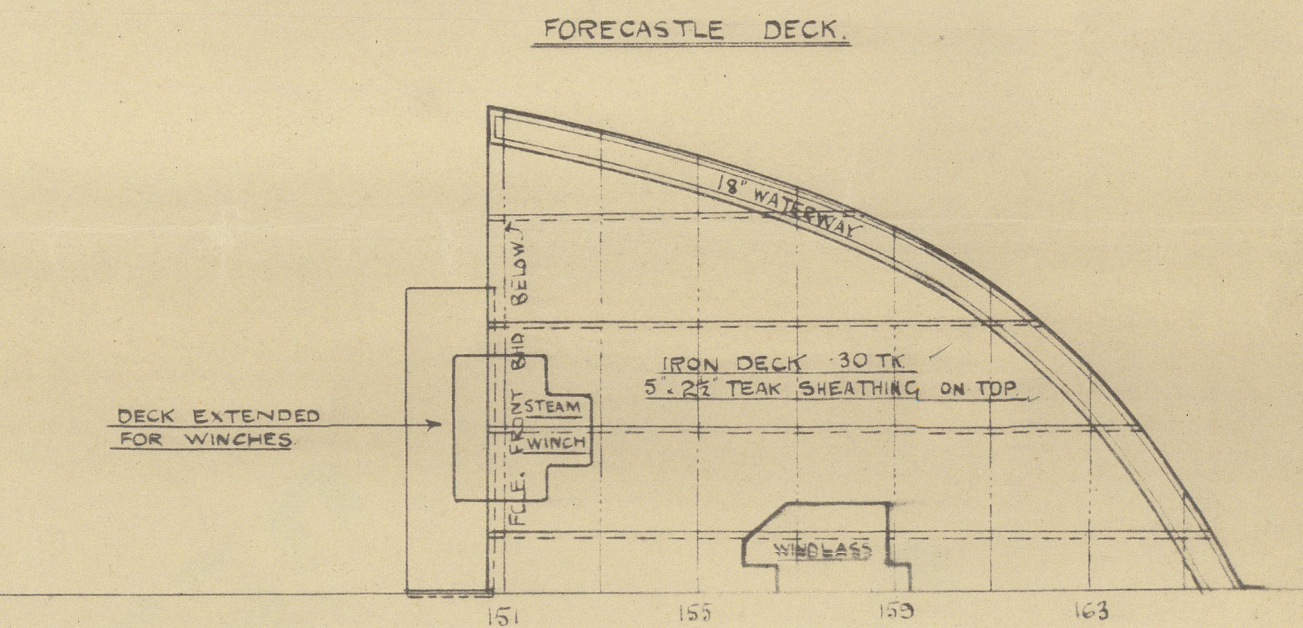
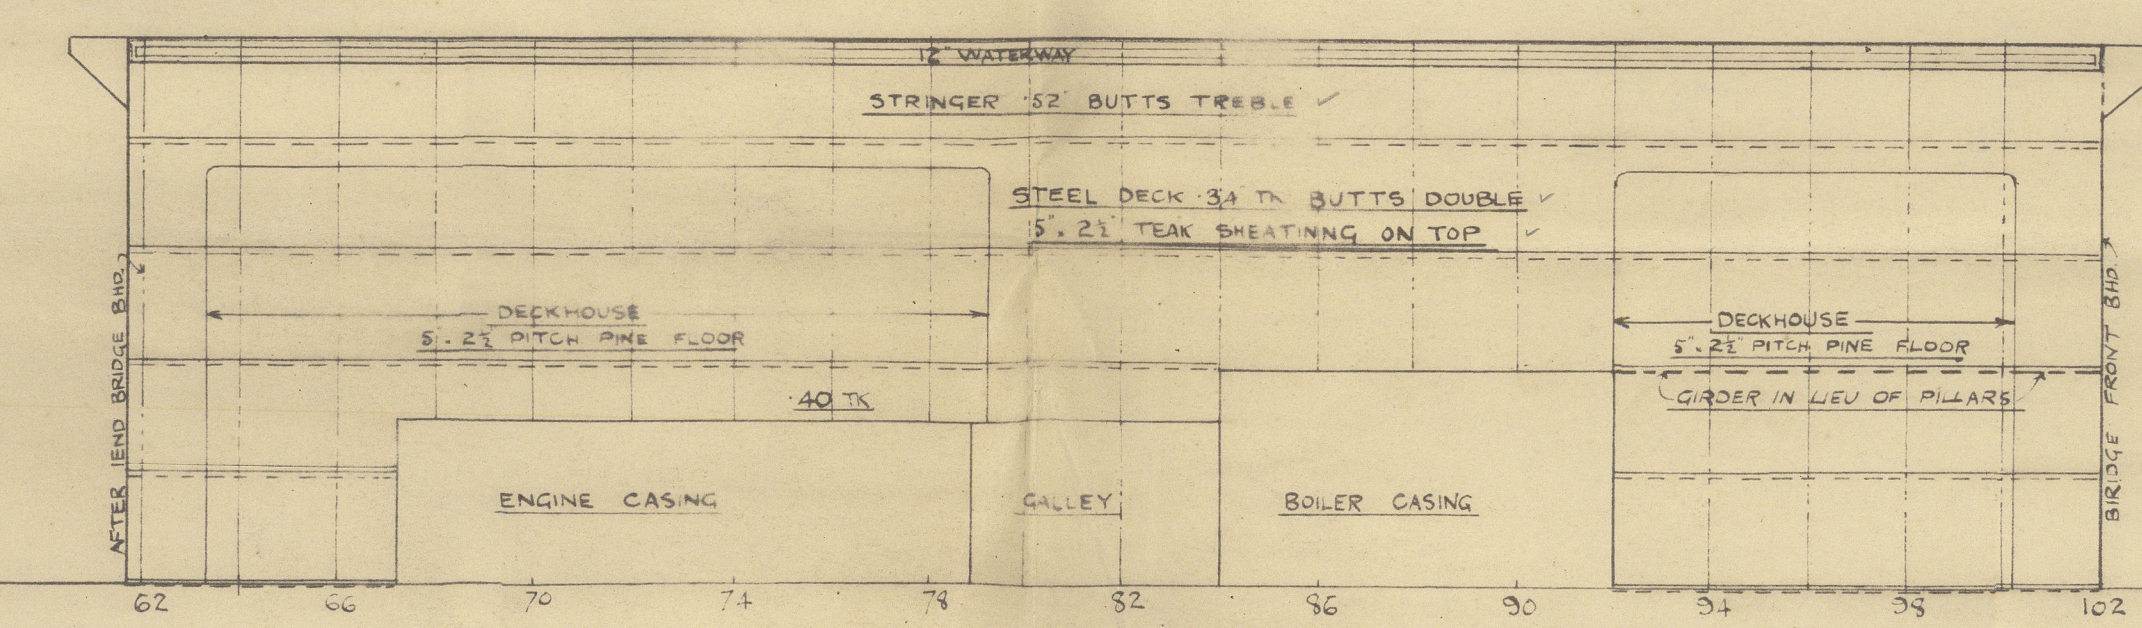



DECK PLANS S.S. TIME.

SCALE 1/8" = ONE FOOT


BRIDGE DECK

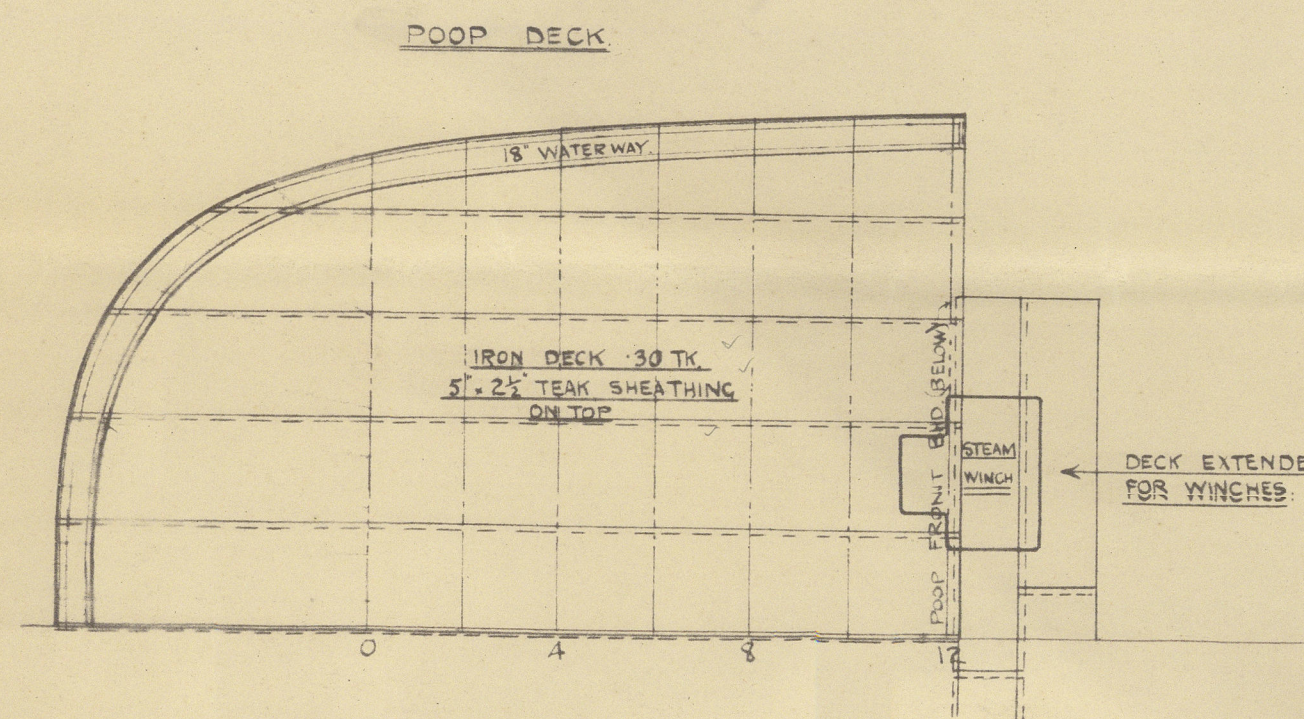

UPPER DECK

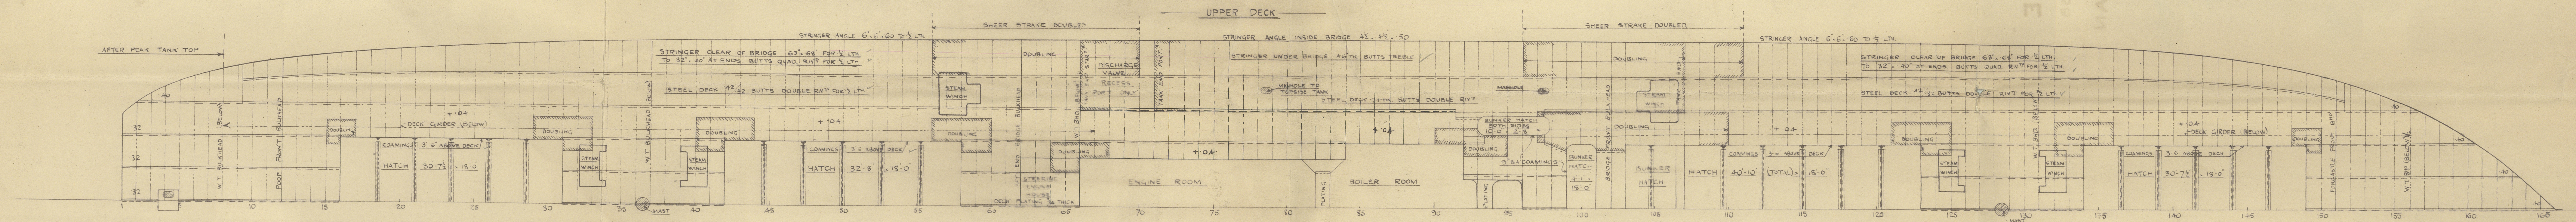

MAIN DECK

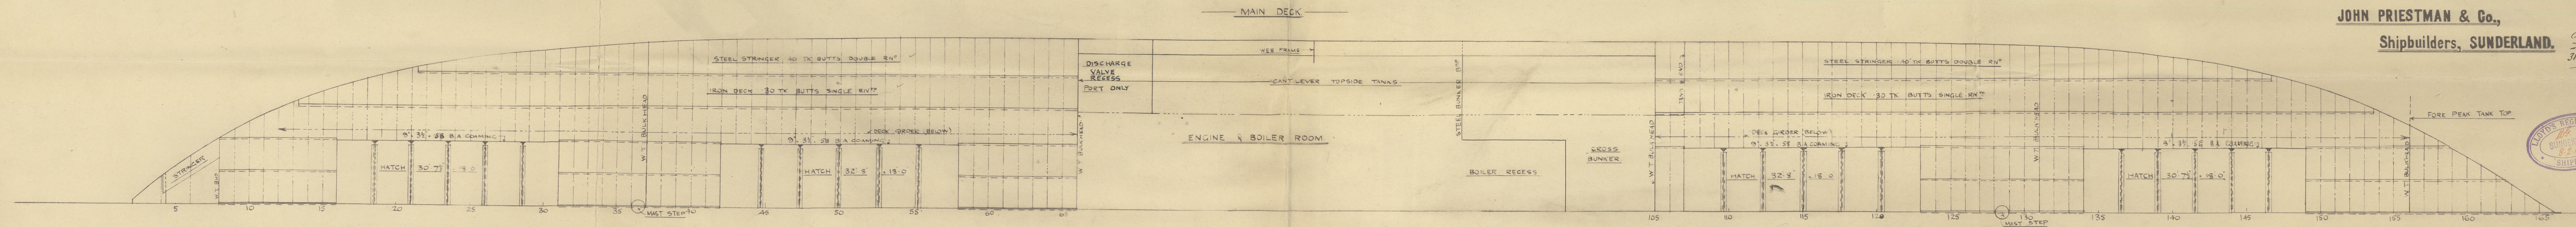

JOHN PRIESTMAN & Co.,
Shipbuilders, SUNDERLAND.



W1030-0065

S.S. TIME

PRIESTMANS No 238

DECK PLAN

(AS FITTED)

Sld. Rpt. No. 25590

DETAILS



© 2020

Lloyd's Register
Foundation