

DIMENSIONS.

LENGTH B.P.	88'-0".
BREADTH MLD.	46'-6".
BREADTH EXT.	46'-9".
DEPTH MLD.	25'-6".


S.S. No 198.
PROFILE OF STANDARD STEAMER.
 TO CLASS - 100 A.I. LLOYDS.

SCALE 1/8" = 1 FOOT




NOTE: WHERE THE ARRANGEMENT OF SCANTLINGS ON THIS PROFILE DEVIATES FROM THAT SHOWN ON THE STANDARD PROFILE, IT IS INTENDED TO UTILISE MATERIAL ALREADY IN THE YARD.
 SCANTLINGS NOT SHOWN TO BE TAKEN FROM STANDARD PROFILE APPROVED BY LLOYDS 15/2/17.

9'-3/2" B.A. FRAMES CARRIED TO BRIDGE WHERE SHOWN THIS

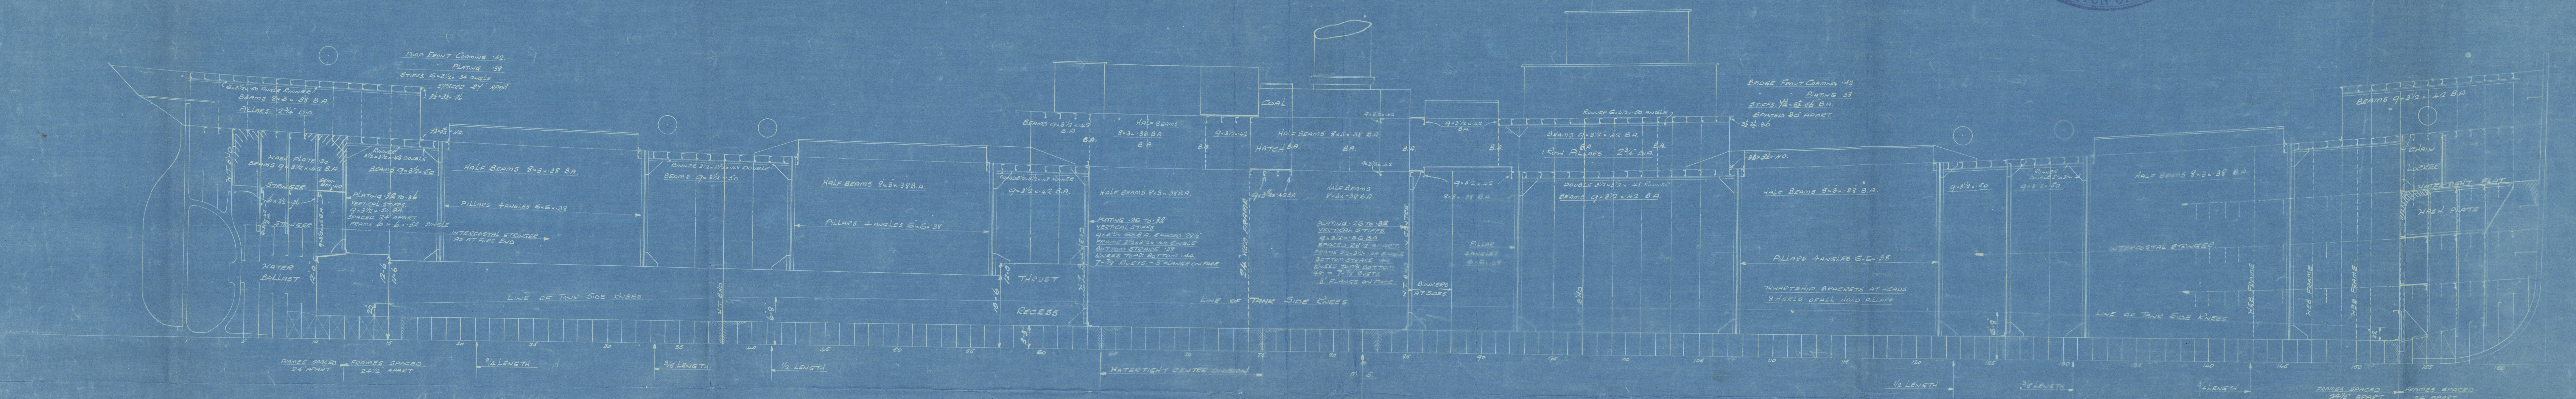

22.15.108 (REVISED - C.I.) 1917

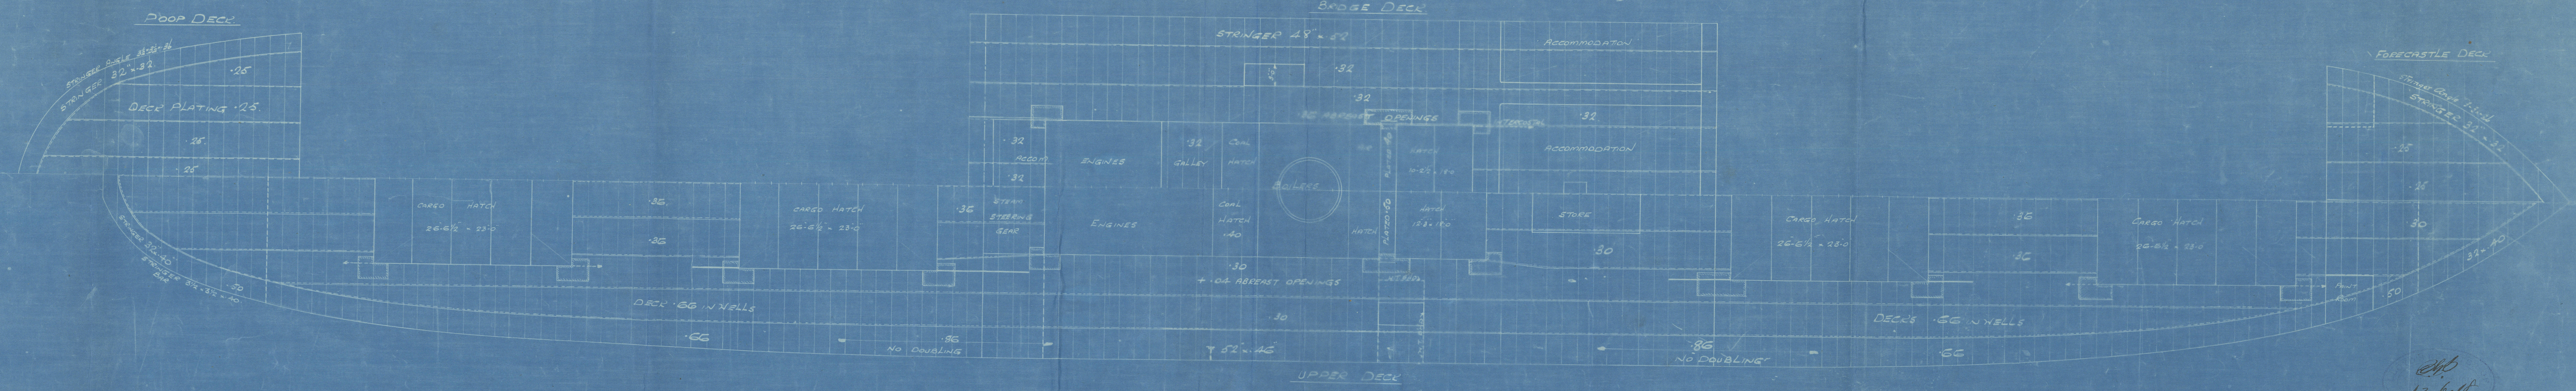


12.6.18

Must Craig & Lynn Lloyd
10122.

Prof. & Bks.

^{Wanna}
St. War ^{est} Lach

Indt. report N^o 10122.

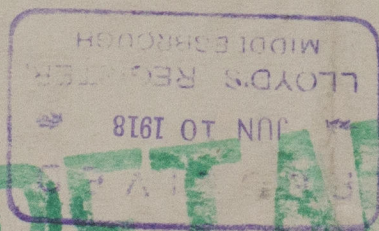

RETAIN



© 2020

Lloyd's Register
Foundation