



2. Safety valves 9" max
type 1.5" max

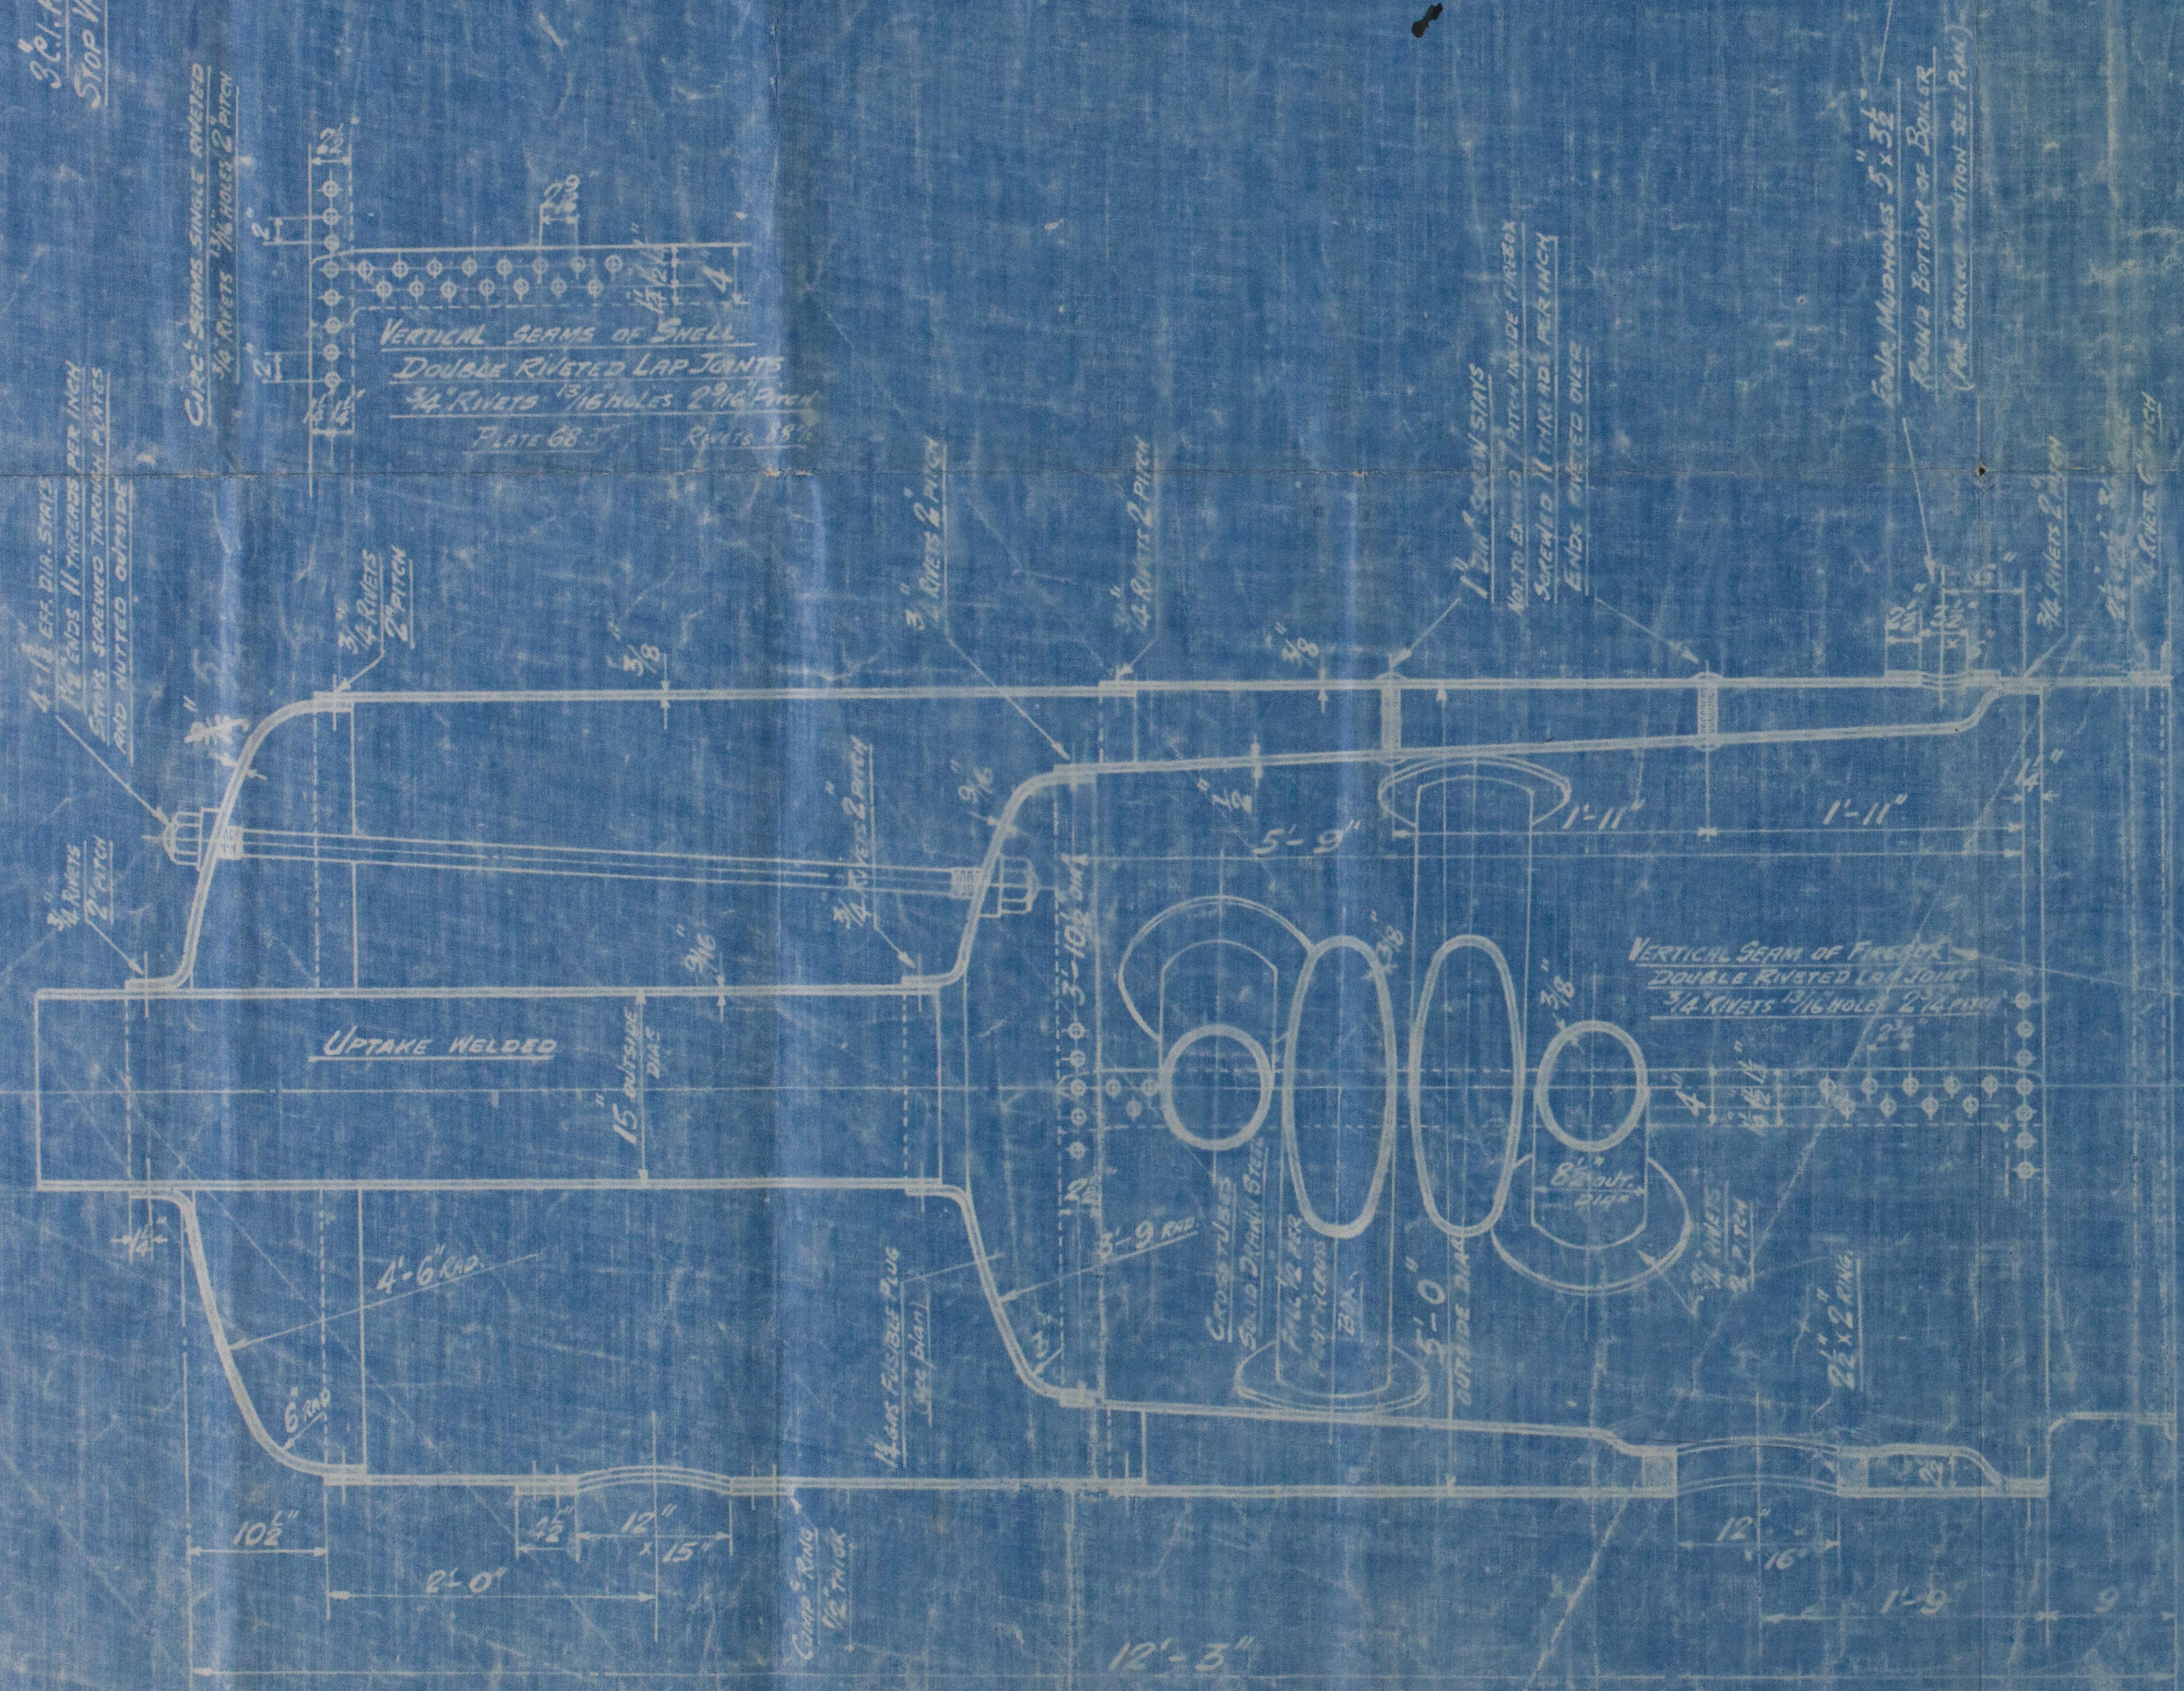

HEATING SURFACE 120 SQ. FT. (WATER SIDE)
GRATE AREA 15.0 SQ. FT.

WORKING PRESSURE 100 LBS PER SQ. INCH
TEST (WATER) 200

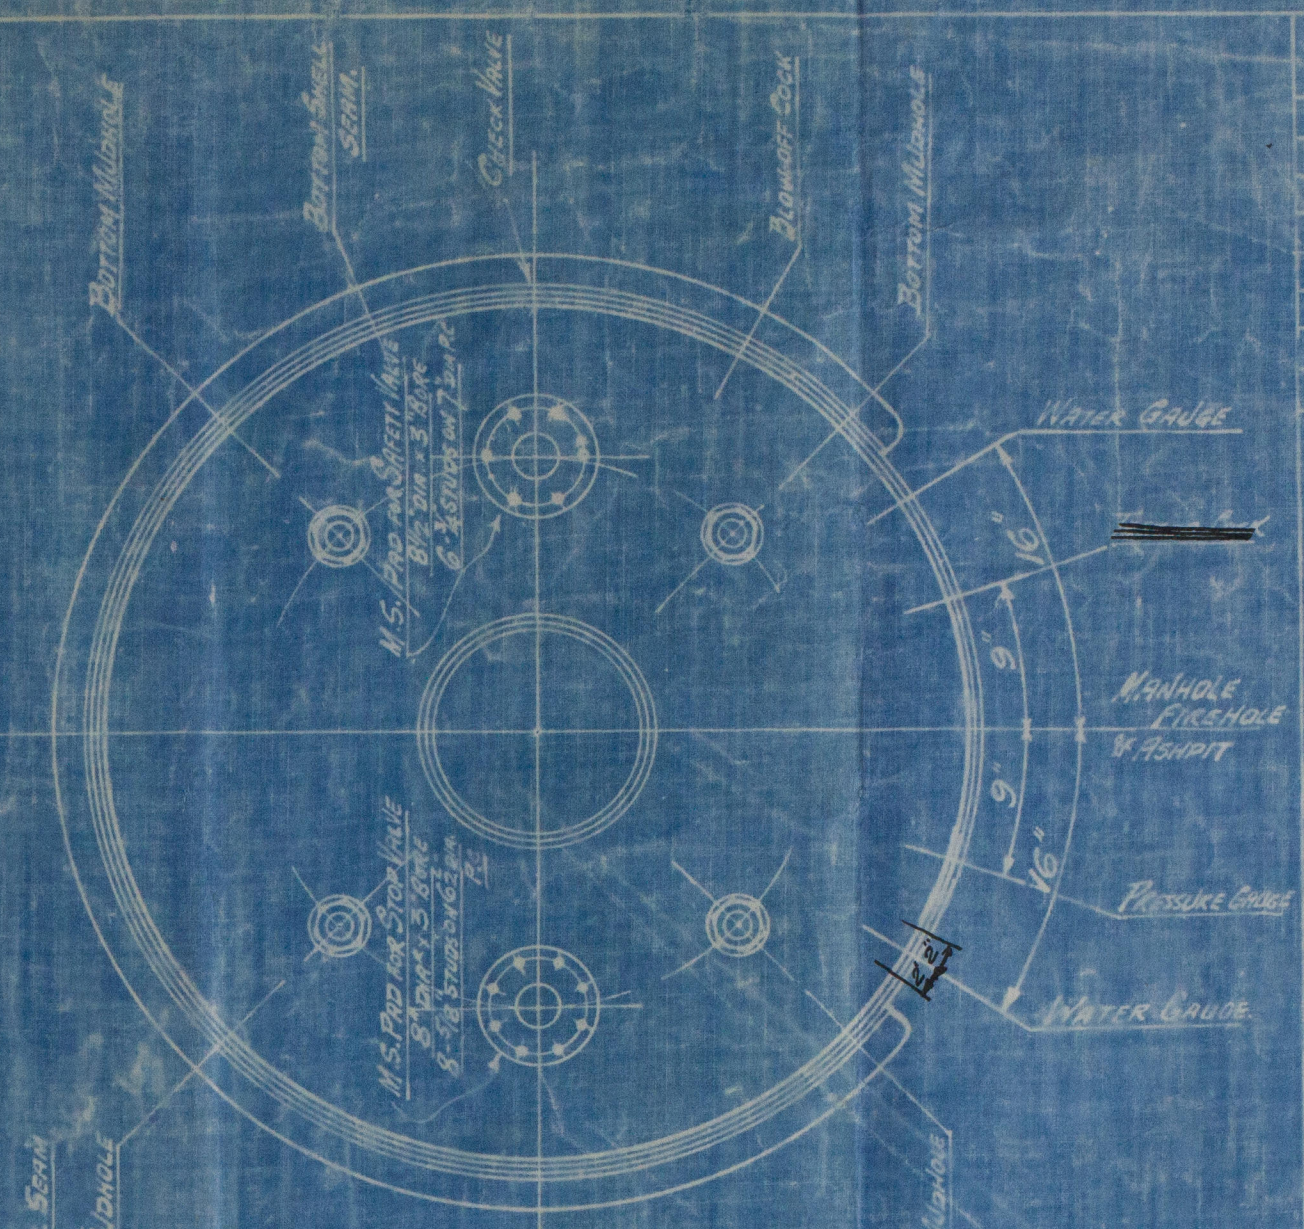

PLATES

1	PLATE 16'-0" x 6'-6" x 3/8" - BOTTOM SHELL
1	15'-9 1/2" x 5'-2" x 3/8" - TOP SHELL
1	14'-7" x 6'-8 1/2" x 5/8" - FIREBOX
1	3'-10" x 5'-8" x 3/8" - UPTAKE
1	5'-9" DIA. x 3/8" - SHELL CROWN
1	4'-7" DIA. x 3/8" - FIREBOX CROWN
1	2'-11" x 12'-10" x 5/8" - MAINHOLE RING

4 SOLID DRAWN STEEL TUBES 8" DIA. x 3/8" - CROSS-TUBES

MOUNTINGS

1	2" DIA. SAFETY VALVE
1	5" DIA. G. I. STOP VALVE WITH OUTSIDE FORN
1	SET 3/4 G.M. PRESSURE GAUGE & WATER GAUGES WITH FLOWMETER
2	1/2" G.M. A.P. TEST COCKS
1	1/4" G.M. ANGLE CHECK VALVE & COCK
1	1/4" ASBESTOS PACKED BLOWOFF COCK
6	PRESSURE GAUGES WITH IRON BUSHING & COCK


FITTINGS

1	MANHOLE AND MIDHOLE DOORS
1	FIREDOOR
1	FORNIBLE PLUG
1	CHIMNEY 6" O.D. x 15' PLATE
1	ASHPIT DAMPER

See independent views of feet
and a submergence test to be
made

See letter

12.3.36

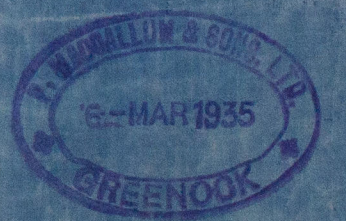


ORDER NO 35/129-10FF

16 HP

TITLE: VERTICAL CROSS-TUBE BOILER 5'-0" DIA. x 2'-3" HIGH
THE FARRAR BOILERWORKS LTD NEWARK

SCALE: 1" = 1 FOOT
DRAWN: TRACED: CHECKED: APPROVED:

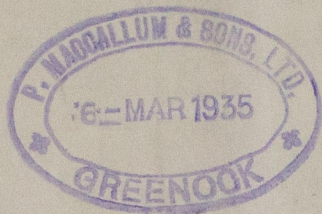

"Little Egg"
now
"Francis"
Rotterdam
N. 23611
Taver
Report 6

RETAIR

P. MacCallum
N. 23611



© 2020

Lloyd's Register
Foundation