

s.s. François Tixier

ex. ss. Ubaldo

off 41,734.

n.n. François Tixier

© 2020

Lloyd's Register
Foundation

W1031-012

31.10.19

Dimensions

Length bet. perps. 155'
 Breadth outside frames 25'
 Depth from upper edge of keel to deck at side 12-63'



Mr. Shikherver

Midships Section - Cargo Steamer

Scale 1-20

Highest Class Germanischer Lloyd + 100 A

Equipment (in letters)

2 Bows each of 12 1/2 cwt
 1 Stream 4 1/2 "
 1 Kedge 2 1/4 "
 1/8 fms cable 1 1/8" dia
 1/4 " wire 3"
 1/4 " " 2 1/8"


Equipment - Letter G.

Long. W. 5820
 Prop 246
 Box 46-5
 Vile 102-5
 Barrels 120
 Chest W. 52
 6404

RULE

Stem 6 1/4 = 1 1/2"
 Stem post 6 1/4 = 3 1/2"
 Rudder 6 = 3 1/2"
 Stick 65 = 4.33" dia
 (2 1/2")


2 Bows Stokers 10 1/2 cwt
 1 Stream 8 3/4 "
 1 Kedge 3 1/2 "
 1/8 fms cable 1 1/8" dia
 1/4 " wire 3"
 1/4 " " 2 1/8"

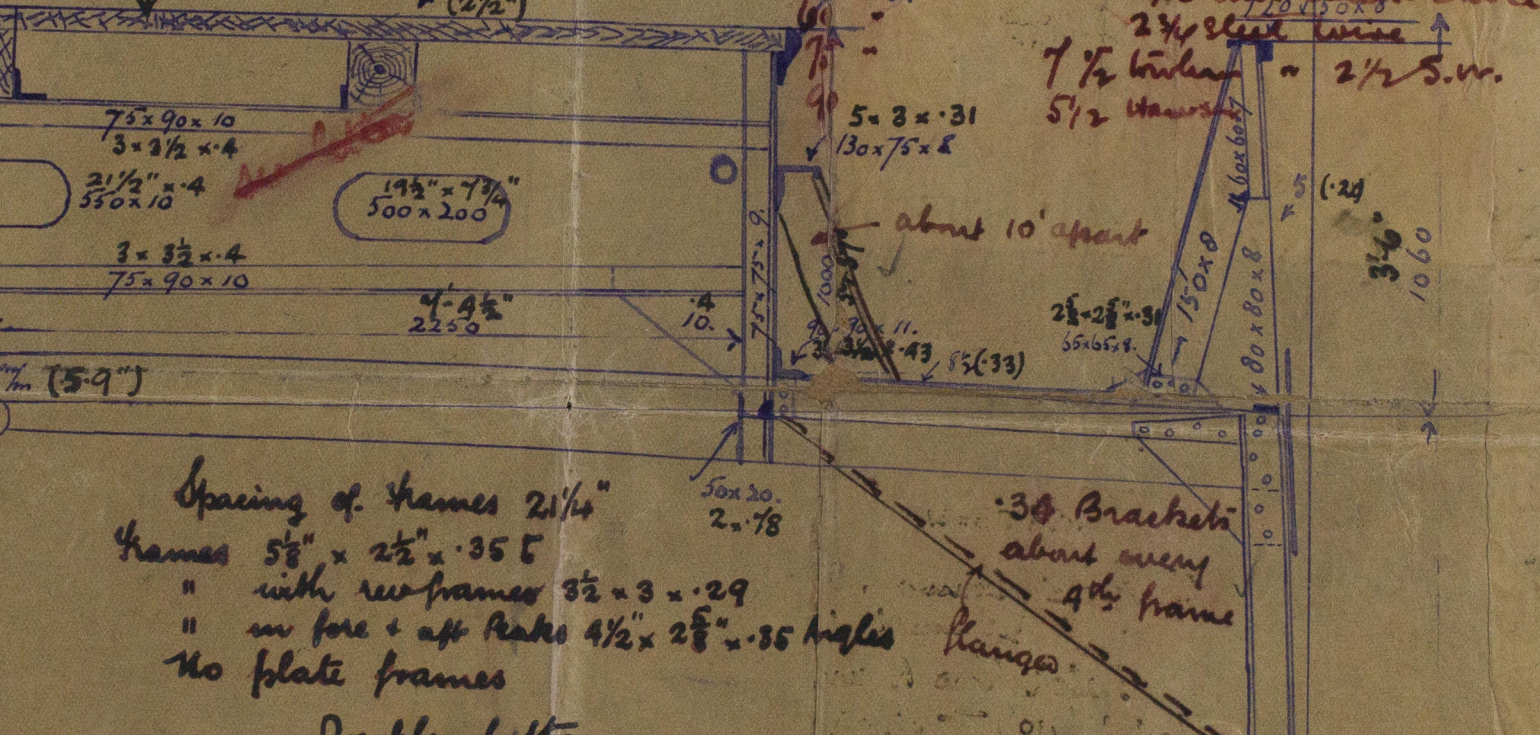

Spacing of frames 21 1/4"
 Frames 5 1/8" x 2 1/2" x 35 E
 " with res frames 3 1/2" x 3 x 29
 " in fore + aft Racks 4 1/2" x 2 1/2" x 35 higher
 No plate frames

Double bottom

Center girder 30" x 35 in boiler room 39
 Margin plate 29 " " " 35
 Side girders (inter) 24 " " " 35 and at ends 27
 Tank top plating 24 " " " 34 in boiler room 31
 Middle line strake 30" x 33 for 1/2 h. " 45 " " 35
 and at ends 29
 All laminings single riveted
 All Butts Double riveted for 1/2 h. and single at end
 excepting Margin plate which is Double riveted
 Diam. of Rivets 3/4 - 5/8"

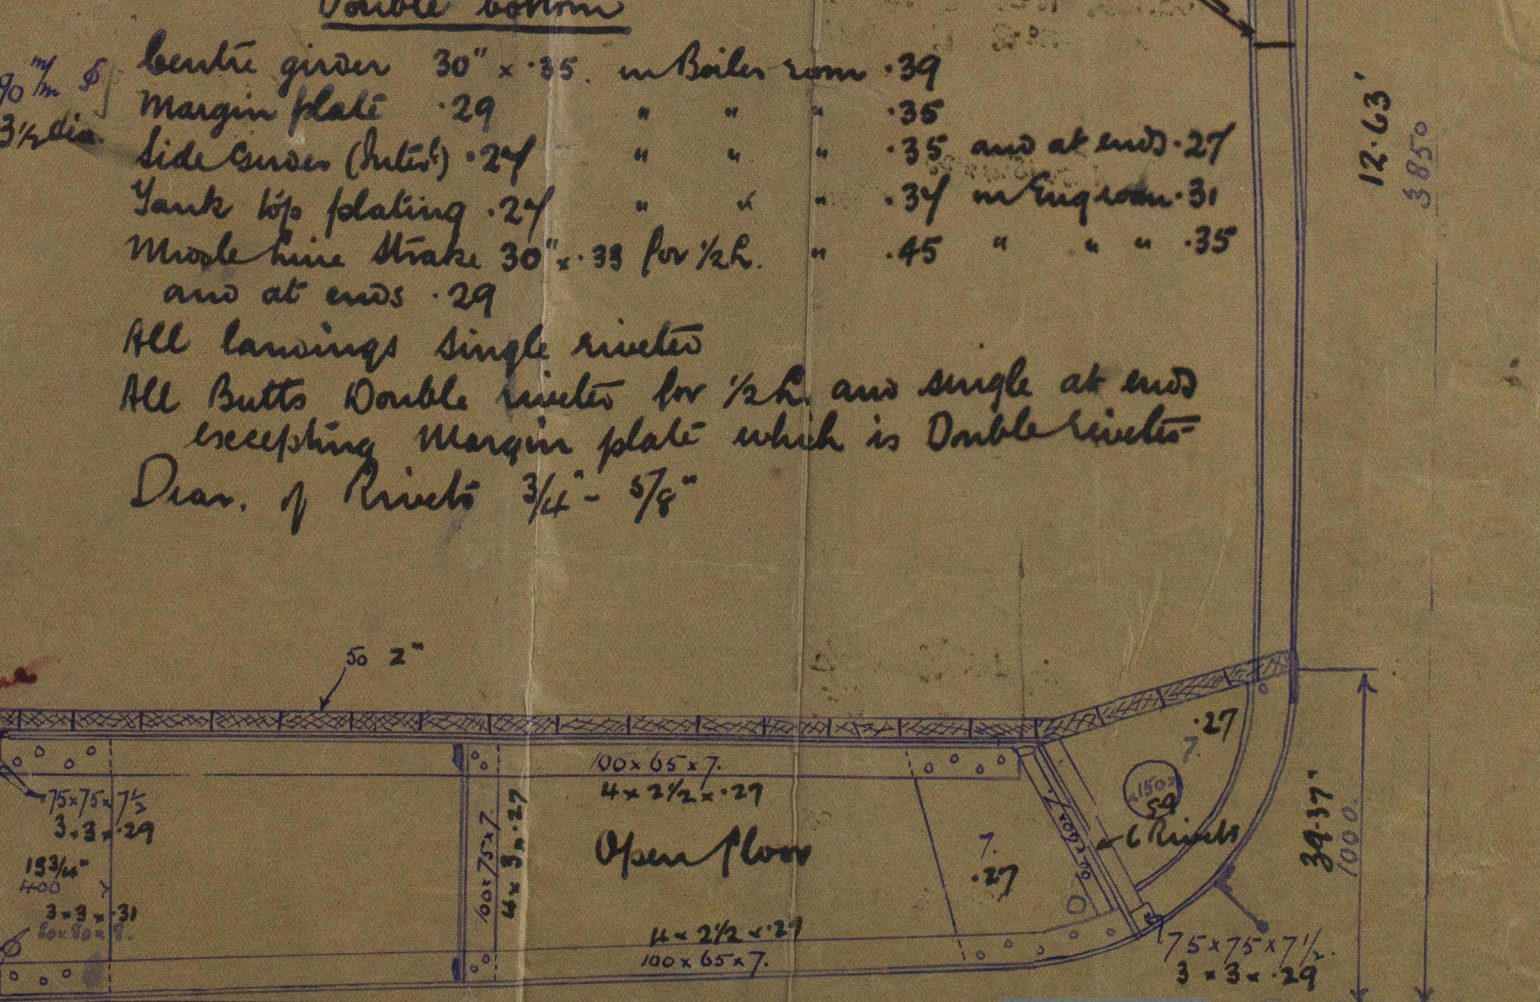

Handings of keel shown edge of sheer strake double riveted
 all other shell plating single
 Diam. of Rivets in frames + shell 3/8"
 in sheer strake 3/4"
 in Main Deck 3/4" - in Main Deck

Keel plate 31" - 53 for 1/2 h.
 43 at end
 Keel + sheer strake Double riveted butts for 1/2 h. 1/2 h.
 All other shell plating double
 Main Deck stringer plates T. Riveted
 All other decks plating Double