



Rev. 22. 2. 95.

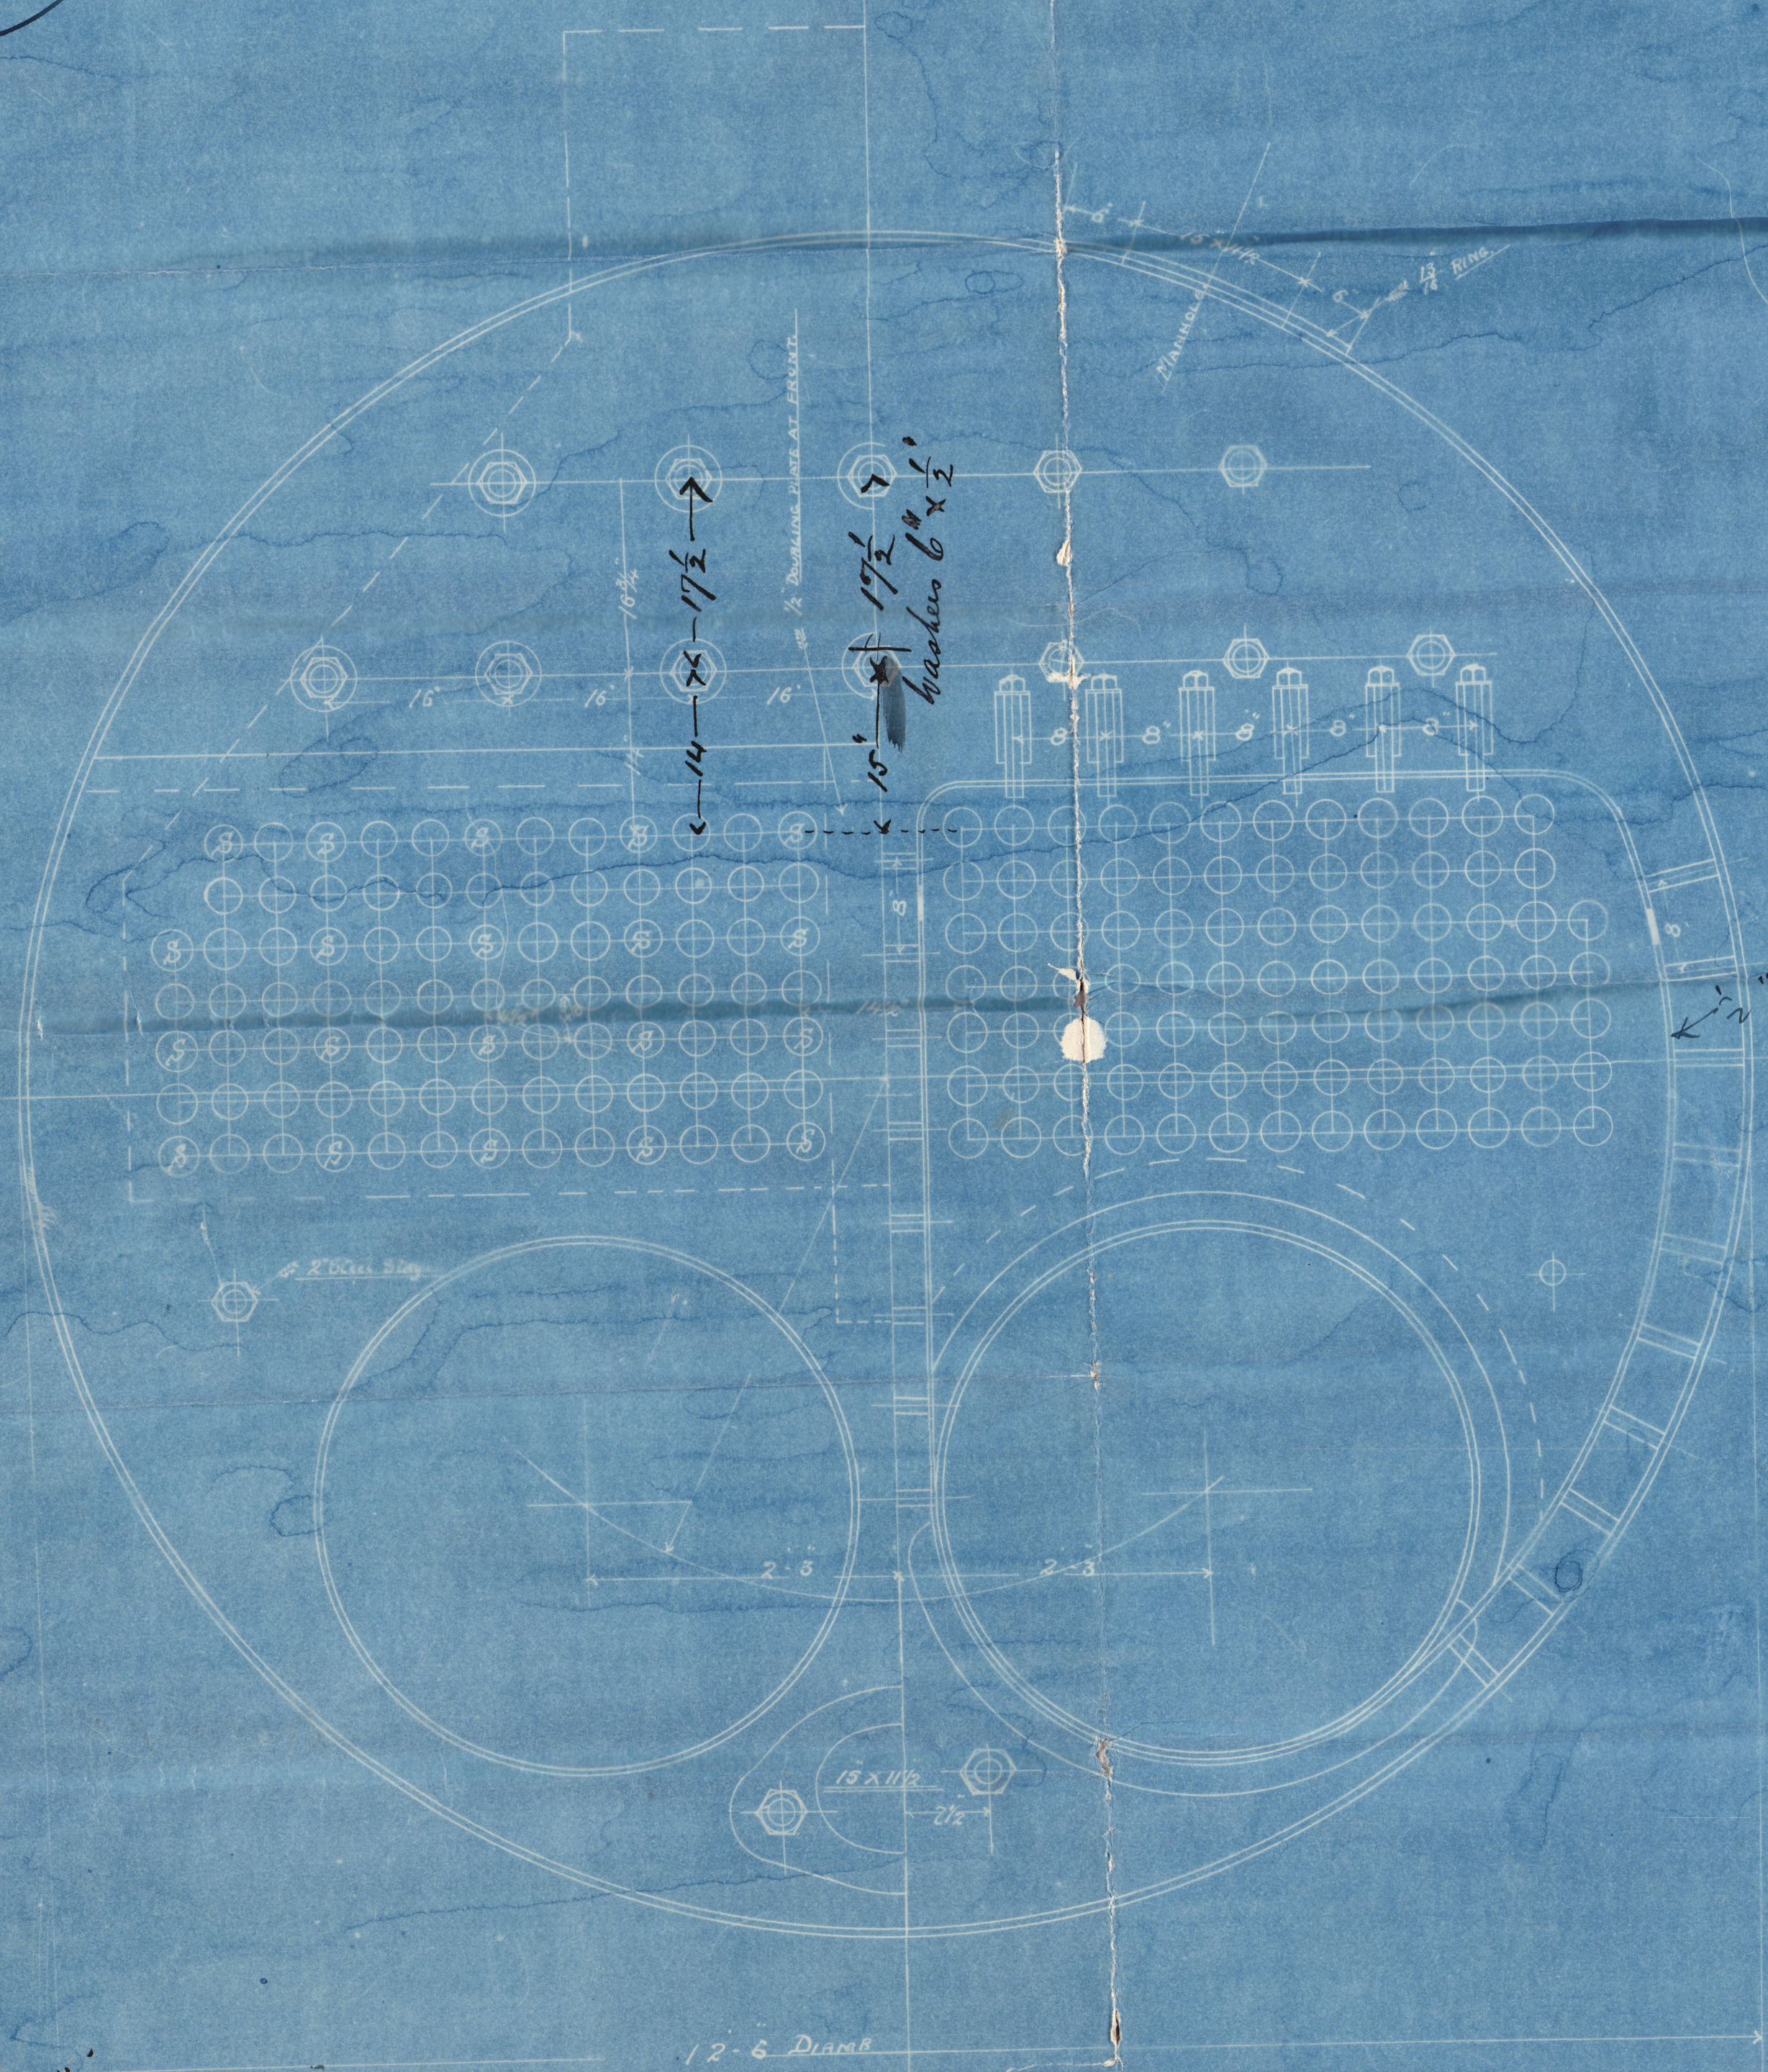

STEEL PLATES BARS AND RIVETS
ALL HOLES DRILLED IN PLACE

CIRC. SEAMS DOUBLE RIVETED
1/8\"/>

LONG SEAMS BUTT JOINTS DOUBLE STRAPPED
1/8\"/>

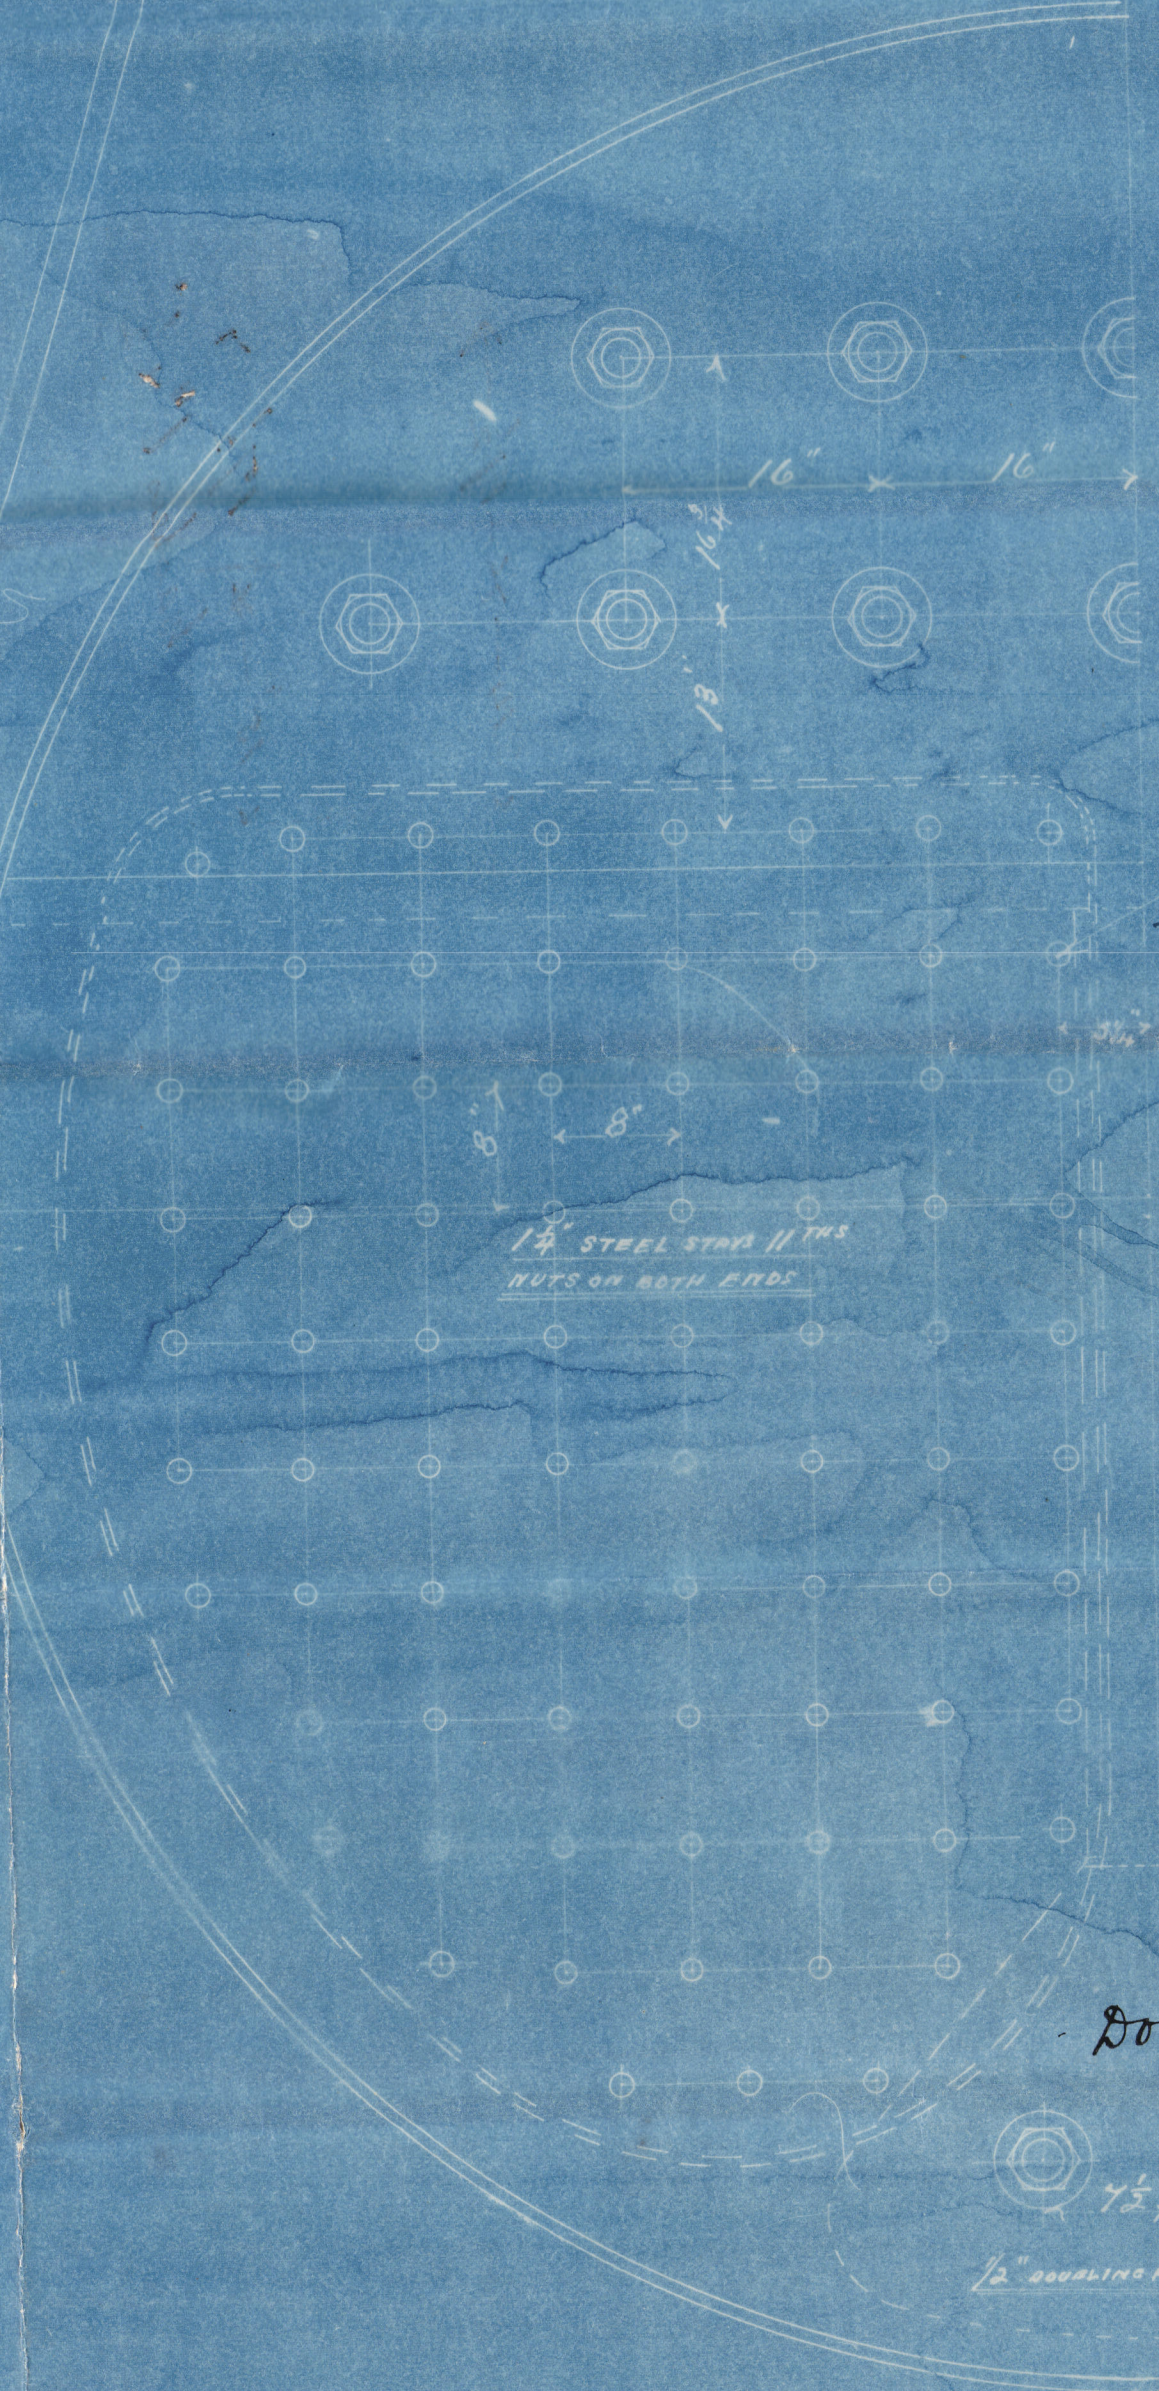

OUTSIDE ROW OF STAYS
ALL ROUND FIRE BOX
1/8\"/>

no doubling
plate will
be fitted.

Doubling plate here

CHS. 2. 95

J.M.
21/2/95

BOILER No 633
WORKING PRESSURE 120 LBS PER SQ INCH
SCALE INCH = ONE FOOT.

TO HAVE LLOYD'S CERTIFICATE



Ross & Duncan
633

Scotts No 113.
S. S. "Ponrhyn"
Glasgow Report
No 13905.

Granley

Boile



© 2020

Lloyd's Register
Foundation

W1031-0629