
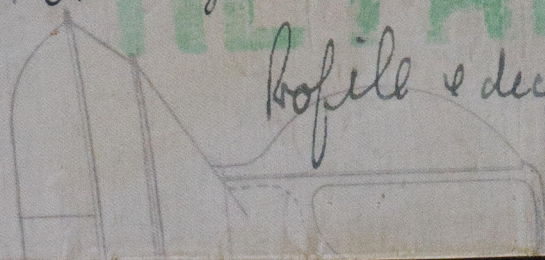


S.S. "Penrhyn" Glasgow Report N^o 13905.—

NN. Coanley


Profile & decks

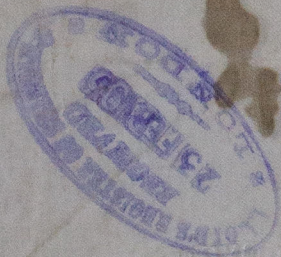




© 2020

Lloyd's Register
Foundation

S. S. N^o 113
 76.2.95
 1895

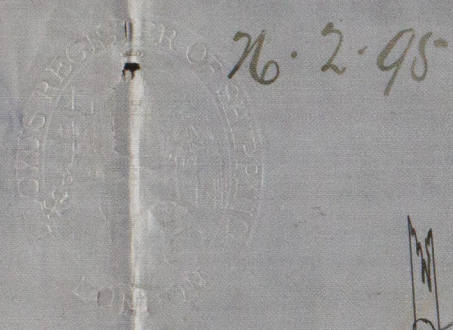

S. S. N^o 113
 scale $\frac{1}{8}$ " = one foot.
 Steel to class 100 A

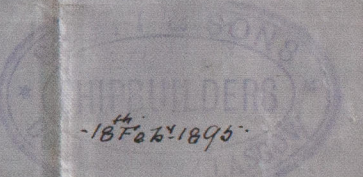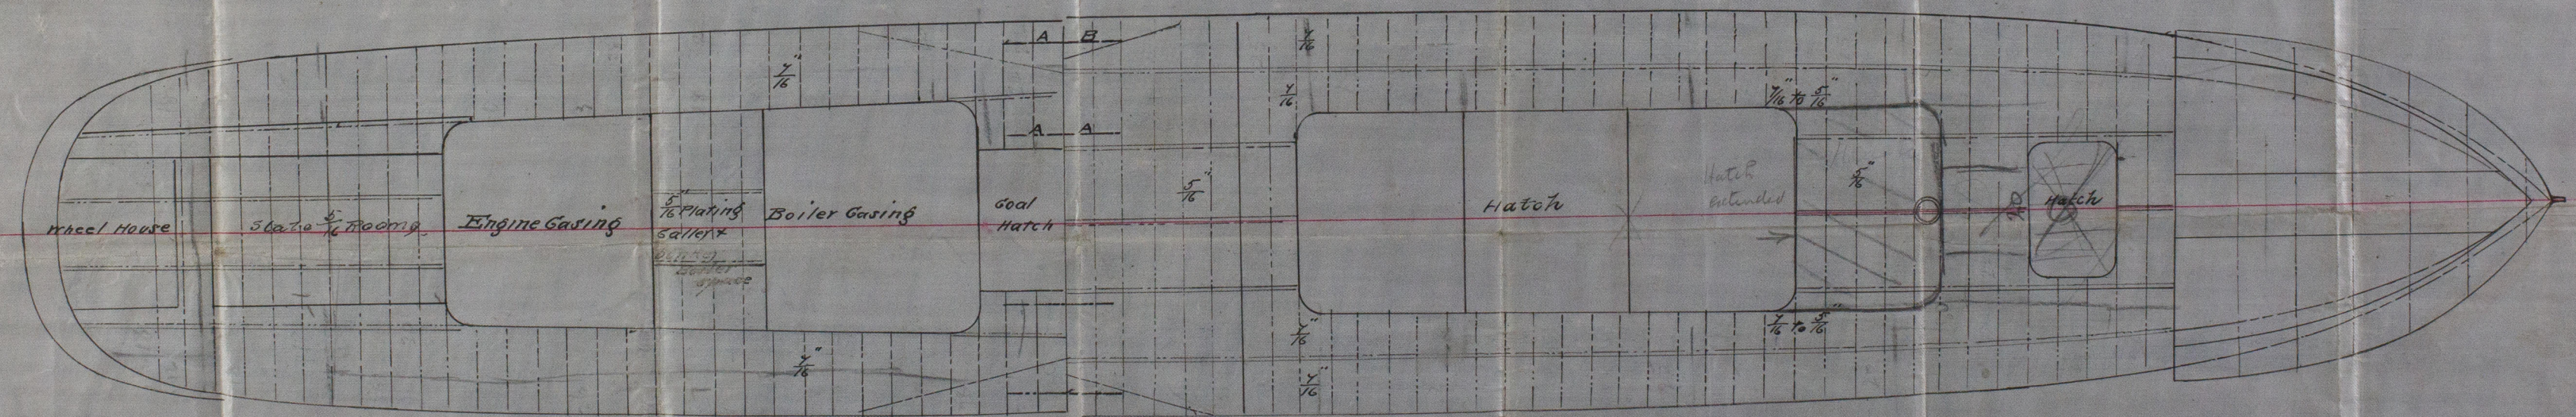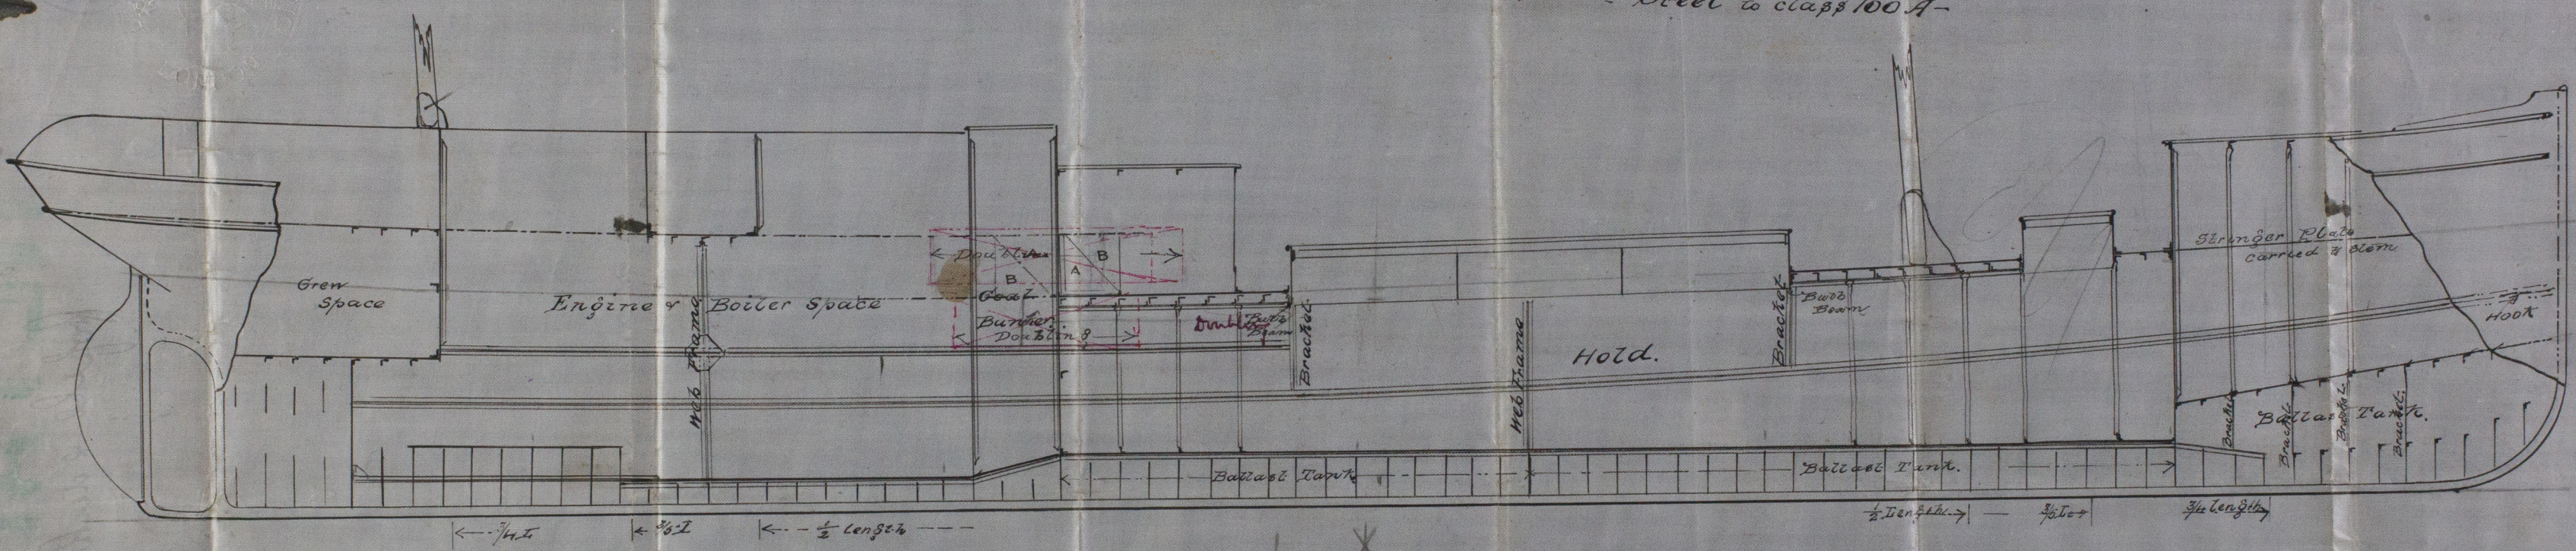

J.D.B.
 26/2/95