

DIMENSIONS

LENGTH B.P.	355'-0"
BREADTH MLD	43'-8 1/2"
BREADTH EXT.	50'-0"
DEPTH MLD	25'-8"

13.6.10
18.7.10.

S.S. N° 143 MIDSHIP SECTION.

CLASS 100. A. 1 LLOYDS.

STEEL

NUMERALS.

B.D.	=	15.36
L x (B.D.)	=	26753
1/40 TO MAIN W.	=	15.85
1/40 = BRIDGE	=	10.7

EQUIPMENT


POOP = 35'8" x 7'5"	} x 1/4 = 1016.39
BRIDGE = 109' x 7'5"	
FORE = 33'5" x 7'5"	
ENG'G HOUSE = 51'0" x 7'5"	} x 1/4 = 276.5
SHALLOON = 22'0" x 7'5"	

EQUIPMENT NO. 28086.5

Long. N° 26753

POOP 36' x 7'5"	} x 1/4 = 1020
BRIDGE 109' x 7'5"	
FORE 36'30" x 7'5"	
Eng'g House 51'0" x 7'5"	} x 1/4 = 217.5
Saloon House 22'0" x 7'5"	

28086.5

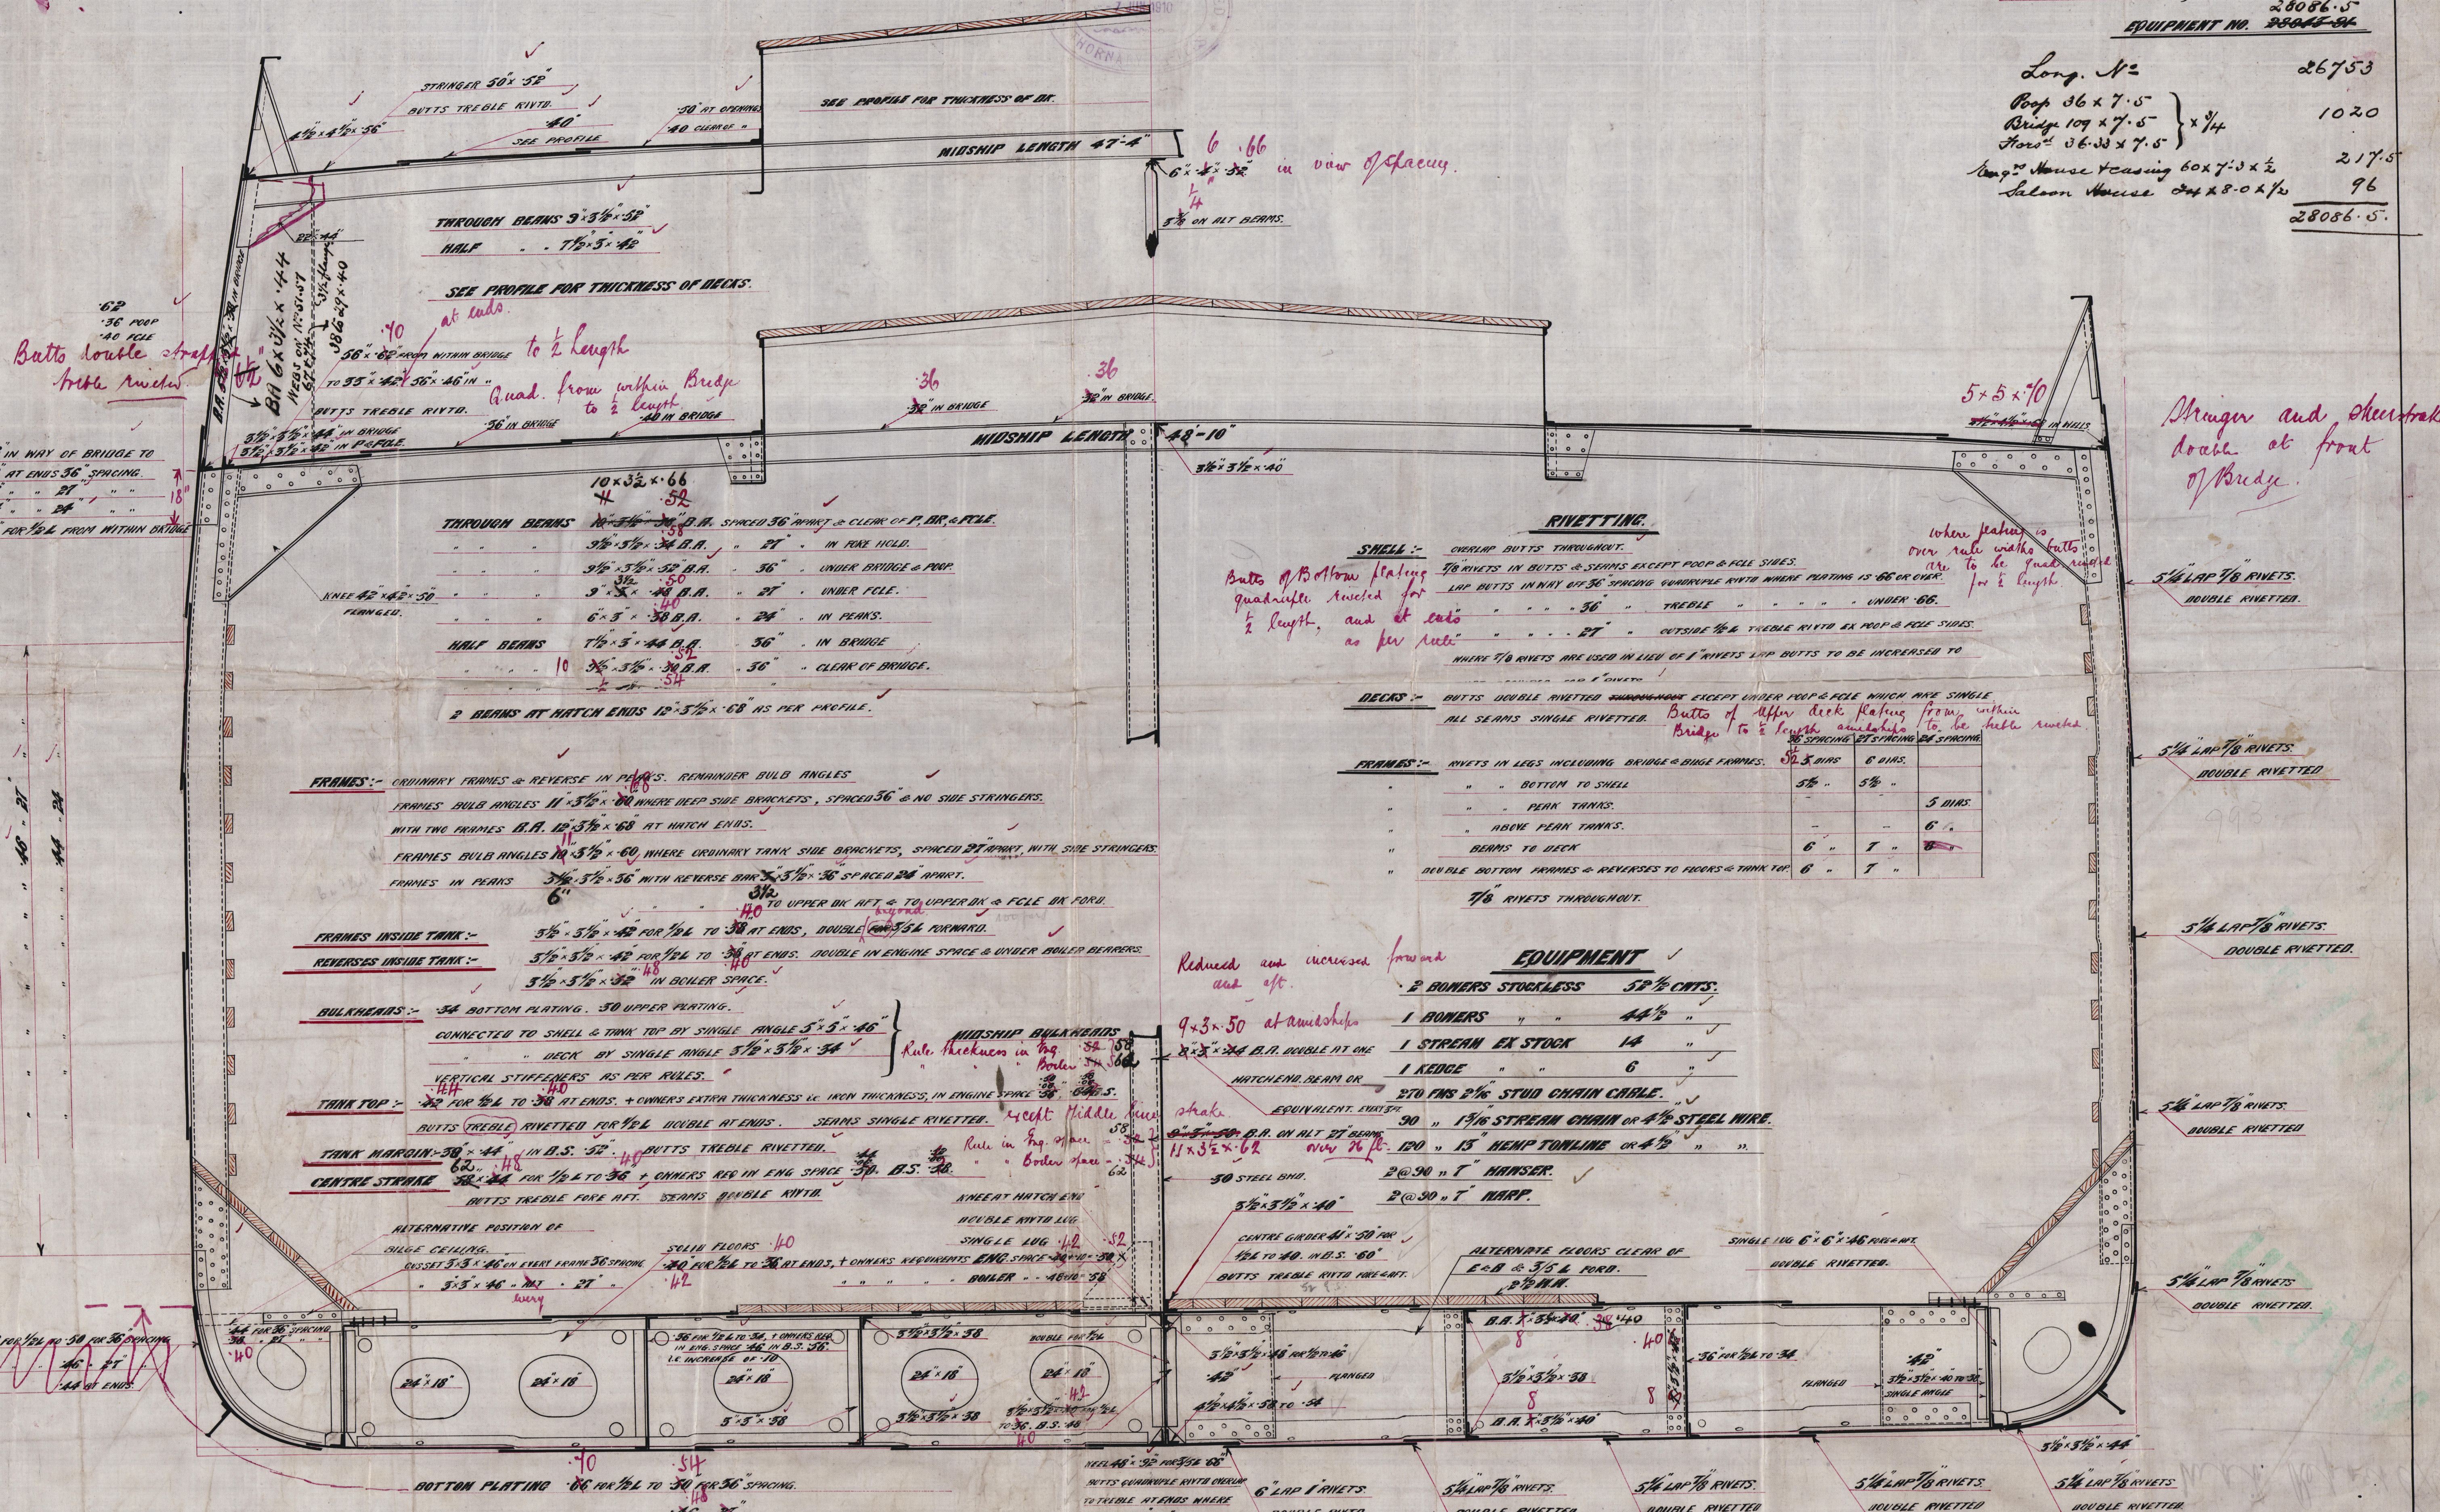

NOTE:- INCREASES IN THICK TOP & FLOORS UNDER ENGINES & BOILERS ARE OWNERS REQUIREMENTS BEYOND RULES.

EQUIPMENT

2 BOWERS STOCKLESS	32 1/2 CWT.
1 BOWERS	44 1/2 "
1 STREAM EX STOCK	14 "
1 KEDGE	6 "
270 FMS 2 1/2" STUD CHAIN CABLE.	
30 " 1 1/2" STREAM CHAIN OR 4 1/2" STEEL WIRE.	
120 " 1 1/2" HEMP TOWLINE OR 4 1/2" "	
2 @ 30 " T. HAWSER.	
2 @ 30 " T. MARP.	

Reduced and increased forward and aft.

9' x 3' 50' at amidships

8' x 2' 24' B.P. DOUBLE AT ONE

HATCHWAY DECK OR

EQUIVALENT EXTERIOR

30' ON ALT 27 BEAM

11' x 3 1/2' x 6 1/2' over 26 ft.

30 STEEL BHD.

5' x 3 1/2' x 40'

CENTRE GARDER 41' x 30' FOR 154 TO 40. M.D.S. 60'

BUTTS TREBLE RIVTS. 1/4" DIA.

5' x 3 1/2' x 30'

5' x 3 1/2' x 30'

Craig, Taylor & Co.

No 143.

Midship Section

" Cygnel
" ^{lex} Amicus

Wab. Report 6/09

(now in

Theoskephash)



© 2020

Lloyd's Register
Foundation

W143 0388