

13. 6. 10
18. 7. 10

S.S. Nº 143

LONGITUDINAL SECTION


DIMENSIONS.

LENGTH BP 355-0"

BREATH M/LD 49-8 $\frac{1}{2}$

DEPTH M/LD 25'-8'

SCALE $\frac{1}{8}$ " = 1 FT

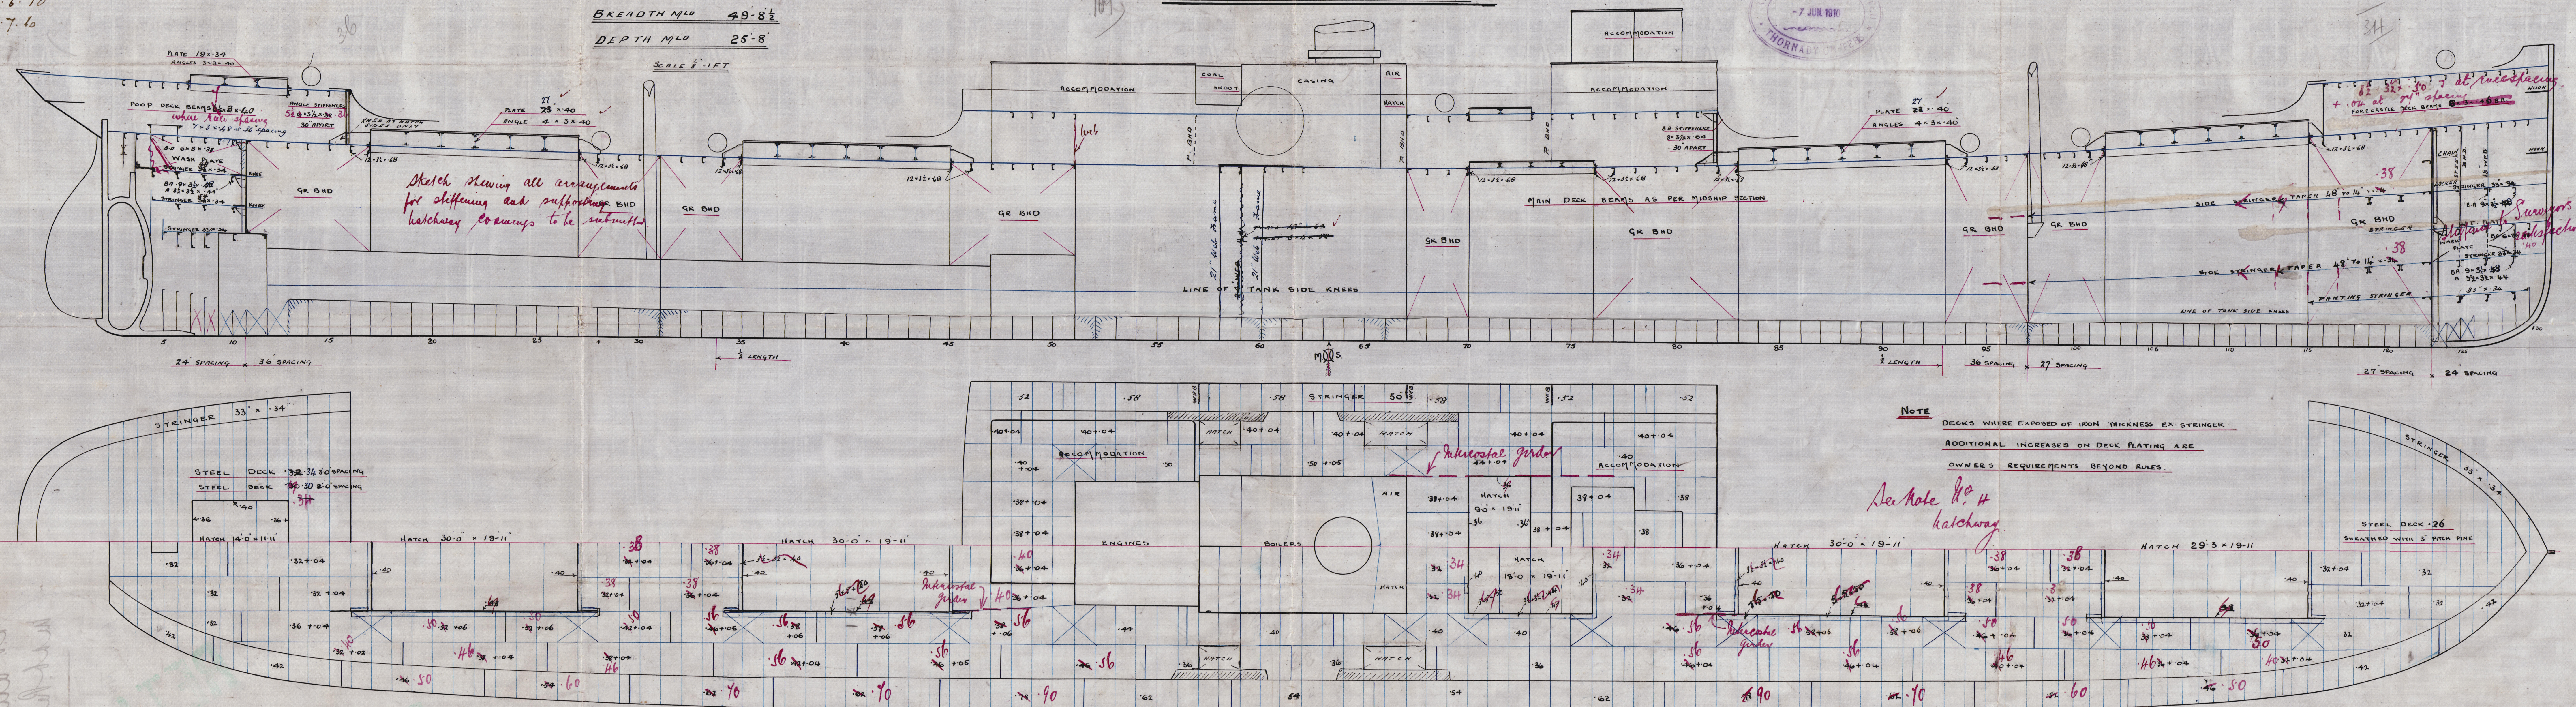

NOTE

DECKS WHERE EXPOSED OF IRON THICKNESS EX STRINGER

ADDITIONAL INCREASES ON DECK PLATING ARE

OWNERS REQUIREMENTS BEYOND RULES.

See Note No. 4
hatchway.

C.7.
13/6/10.

Craig, Taylor & Co.
No. 143.

Profile & Deck Plans.

Cy. met.
est.
L.S. Amicus

Inst. Report to 6/09

(Now Theoskepasti)

THEOSKEPASTI



© 2020

Lloyd's Register
Foundation

W1031-0384