


ORIGINAL DIMENSIONS 142'-0" x 26'-0" x 12'-3" M.D.




SCALE $\frac{1}{4}$ in = 1 ft.

RETAIN

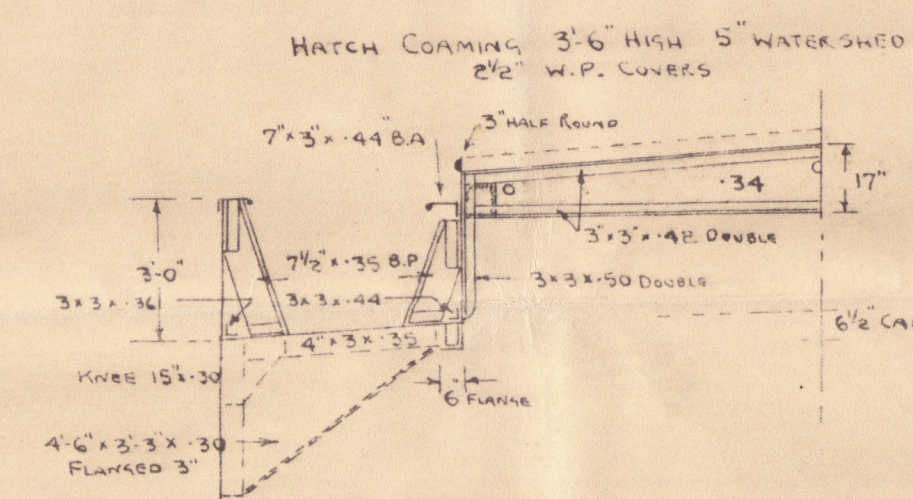

SECTION SHOWING NEW FLOOR & WEB (SCALE $\frac{1}{2}$ in = 1 ft)

1. In Way EXISTING WEB AT STM 46
2. In Way STM 51 (NOT PREVIOUSLY FITTED WITH WEB)

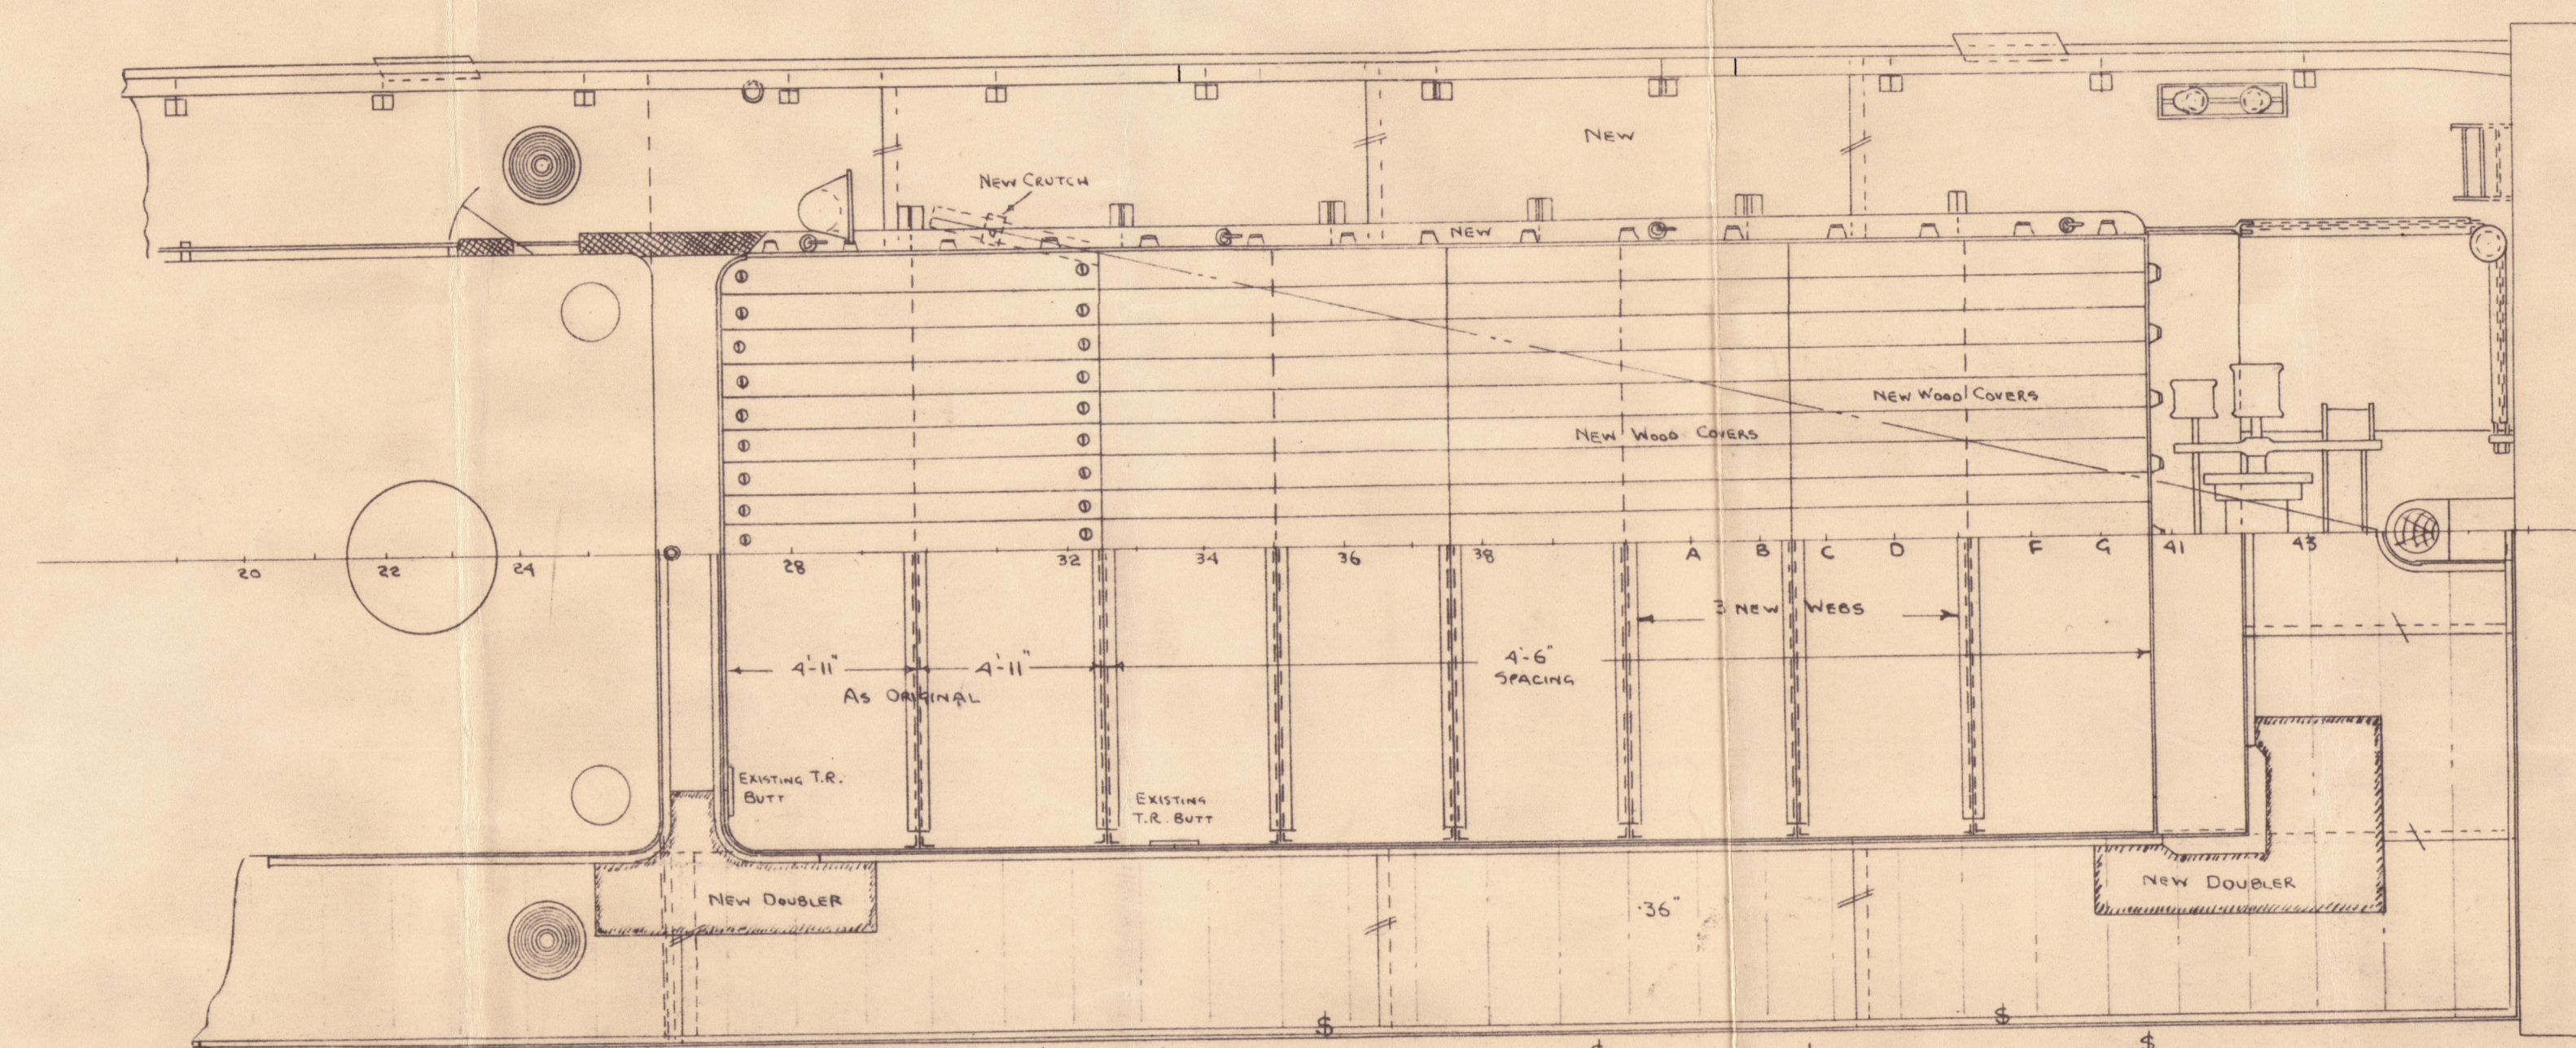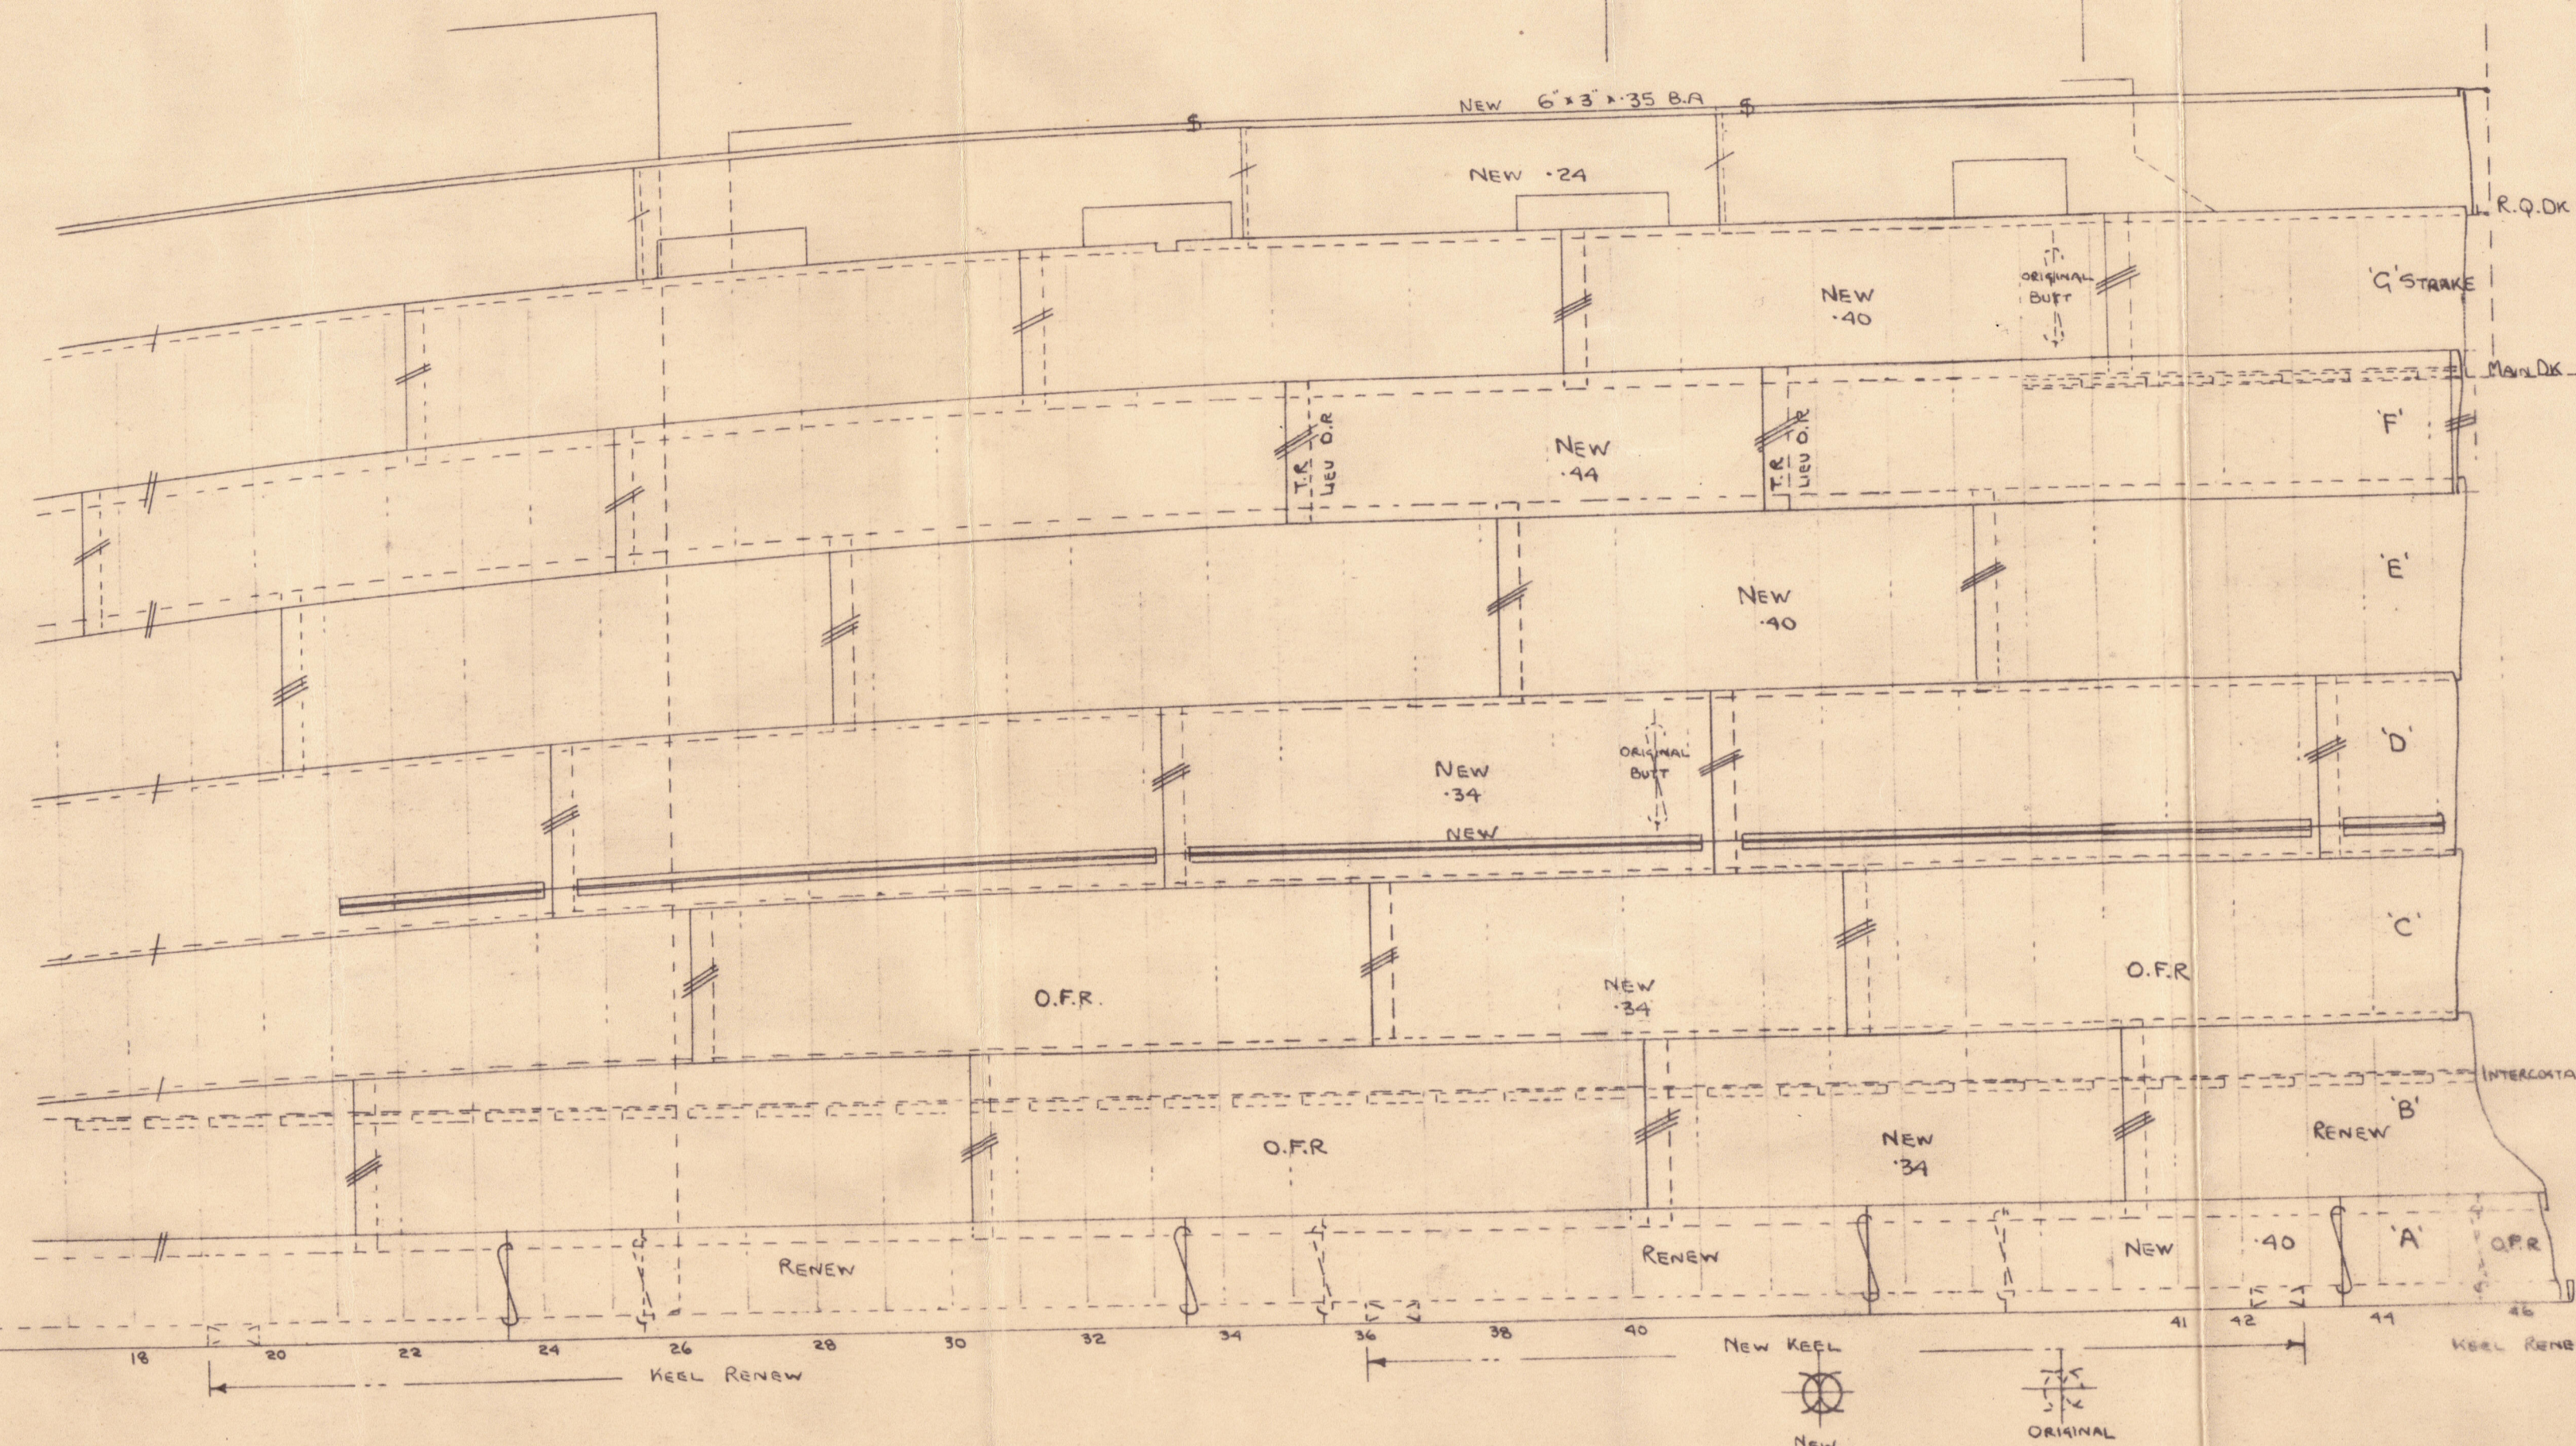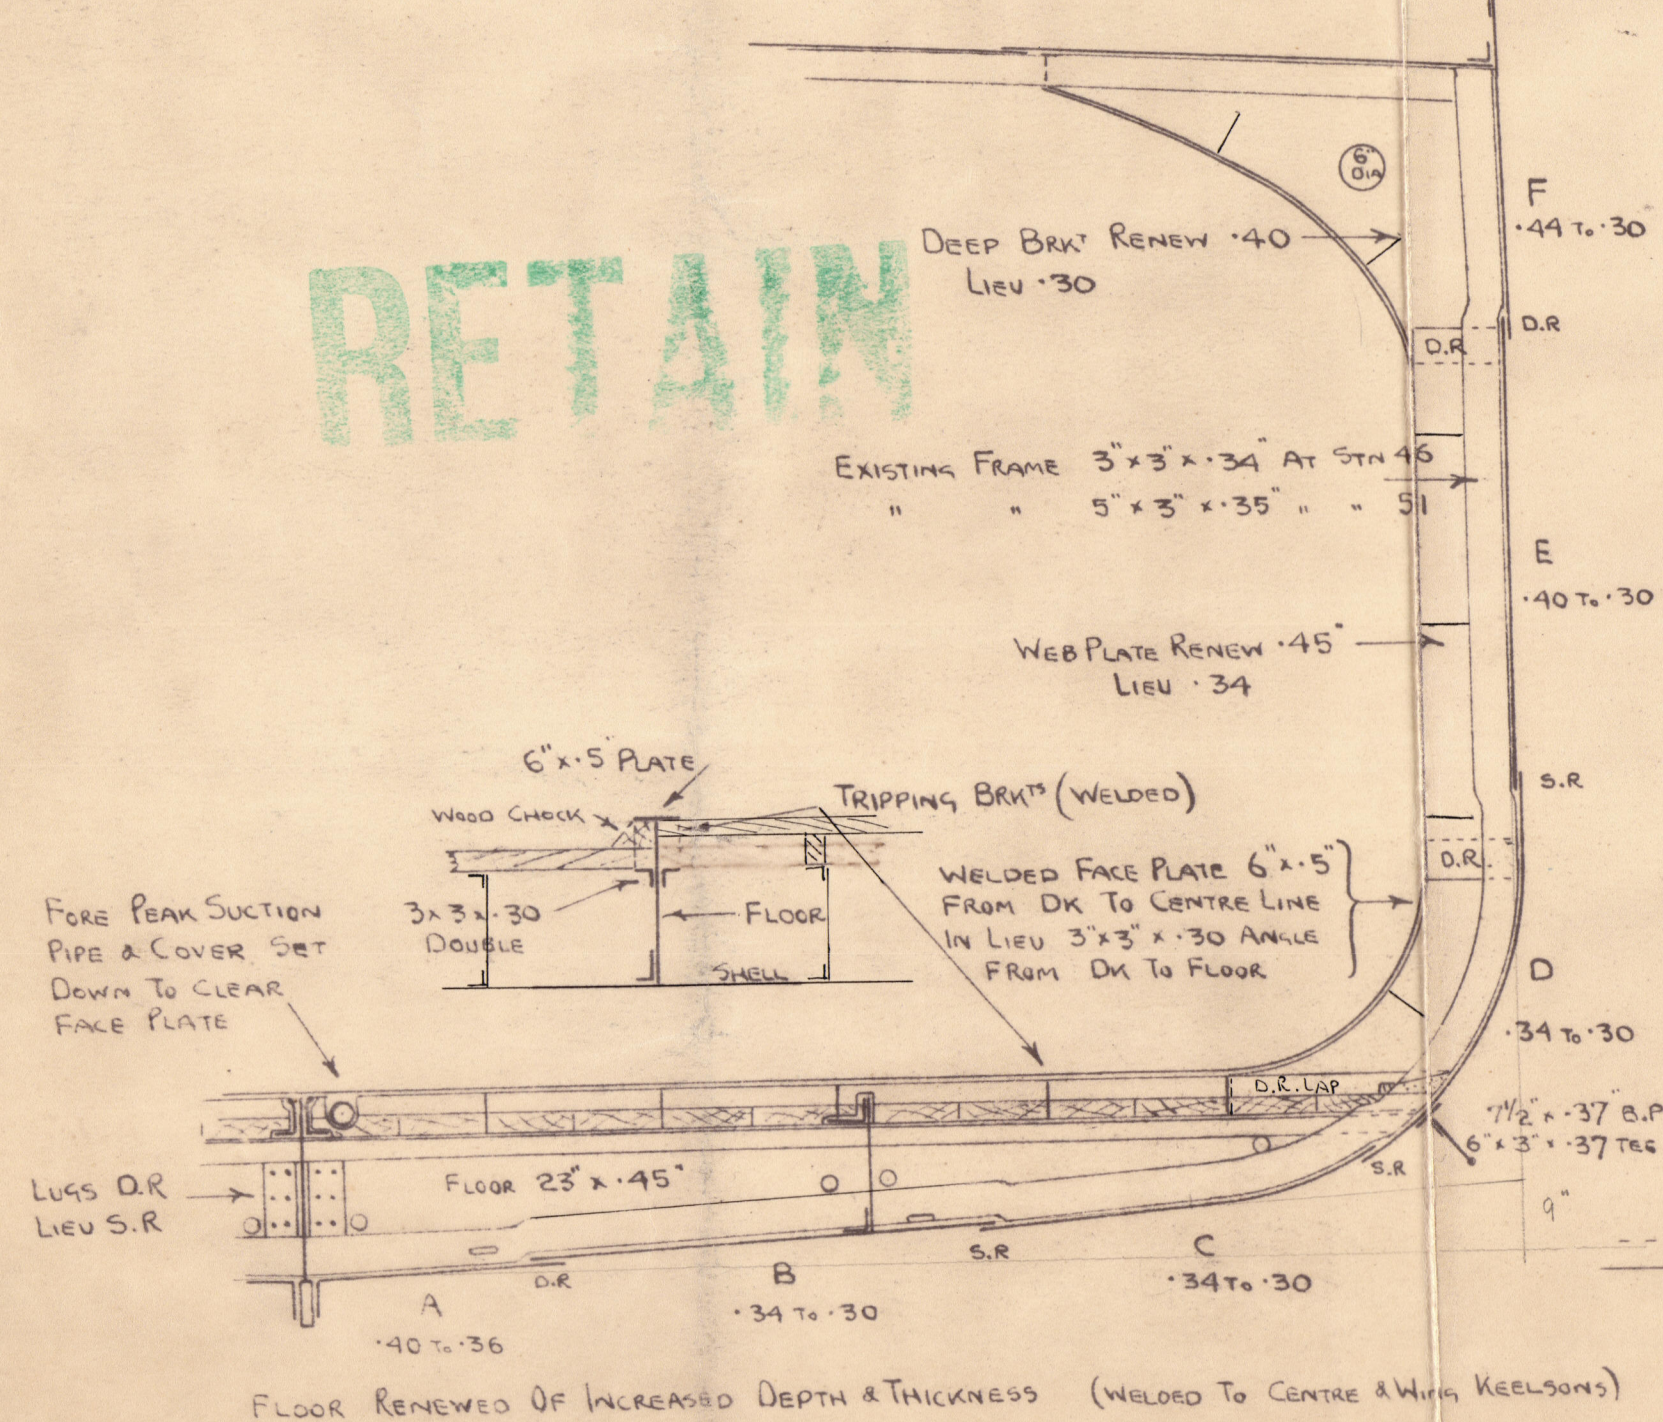

A circular purple ink stamp. The outer ring contains the text "CASEBOURNE & TURNER" at the top and "WATER ST., LIVERPOOL" at the bottom, separated by two stars. Inside the ring, the text "CONSULTING ENGINEERS" is at the top and "MARINE SURVEYORS" is at the bottom, with a small "&" in the center.

✓ Q. 1. 3.

S/S "SOUND FISHER" 15.1.37

PROPOSED LENGTHENING (JAN' 1937)

ORIGINAL DIMENSIONS 142'-0" x 26'-0" x 12'-3" MLD.

RETAIN

