


NOTE:- SIZES ARE NOT GUARANTEED
AS BEING CORRECT, AS THE
ENGINE WAS COUPLED UP WHEN
SIZES WERE TAKEN.

S/S GRANNY SUZANNE


(EX-SPRINGWAVE)

CRANKSHAFT

SCALE:- 1/8 FULL SIZE.

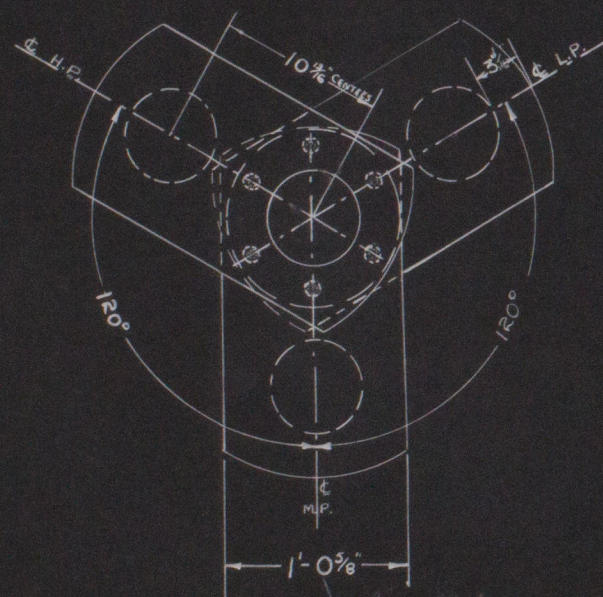

STROKE OF ENGINE:- 21 1/8".

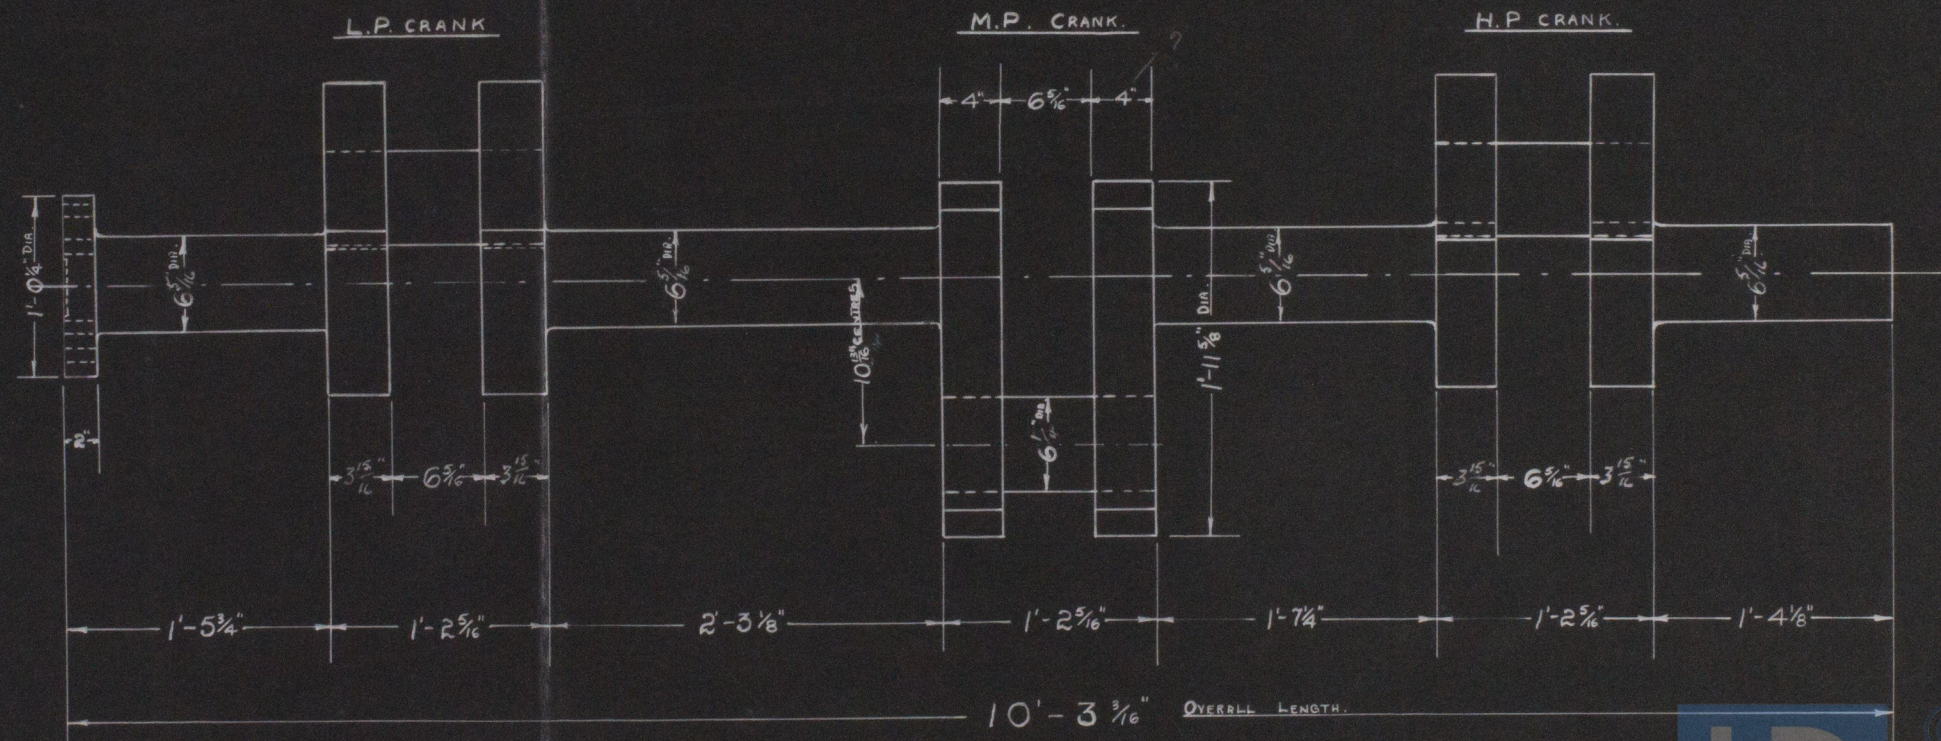


NOTED
27/1/45

Lloyd's Register
Foundation

Crankschaft

"GRANNY SUZANNE" ★

RECCO
LONEL

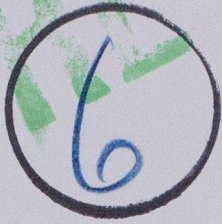

Buy 25743.

RETAIN



© 2020

Lloyd's Register
Foundation